

LAYOUT 7/20/04 A.M. INSP 4 _____
INSP 2 7/21/04 - AM INSP 5 _____
INSP 3 _____ INSP 6 _____

ISSUE DATE: 6/30/2004

APPROVAL DATE: 8/2/04

**PERMIT
INDEXED**

P 520754

A 515249 -J

**ON-SITE SEWAGE DISPOSAL SYSTEM
HOWARD COUNTY HEALTH DEPARTMENT
BUREAU OF ENVIRONMENTAL HEALTH
3525-H ELLICOTT MILLS DRIVE, ELLICOTT CITY, MD 21043**

03-340833

Fogles Septic Clean, Inc IS PERMITTED TO INSTALL ☒ ALTER ☐
ADDRESS: 580 Obrecht Road, Sykesville PHONE NUMBER: 410-795-5670
SUBDIVISION: Twin Pines LOT NUMBER: 6
ADDRESS: 3 150 Stiles Way PROPERTY OWNER: D.R. Horton
SEPTIC TANK CAPACITY (GALLONS): 1250 OUTLET BAFFLE FILTER REQUIRED ☐
PUMP CHAMBER CAPACITY (GALLONS): N/A COMPARTMENTED TANK REQUIRED ☐
NUMBER OF BEDROOMS: 4
SQUARE FEET PER BEDROOM: 180
LINEAR FEET OF TRENCH REQUIRED: 150 HOUSE SERVED BY PUBLIC WATER ☐

TRENCHES:	Trench to be 3.0 feet wide. Inlet 2.0 feet below original grade. Bottom maximum depth 4.0 feet below original grade. Effective area begins at 2.0 feet below original grade. 2.0 feet of stone below distribution pipe.
LOCATION:	Run two 75' trenches on contour on each side of the d. box. Trenches will extend slightly past the SDA stakes. DO NOT BEGIN IF SDA IS NOT STAKED OR THE LOT LINE SHARED WITH LOT 5.
NOTES:	BASEMENT GRAVITY SERVICE IS PROPOSED. ENSURE 100' SEP. DISTANCE FROM NEIGHBORING WELLS

PLANS APPROVED: KN DATE: 1/15/04

NOTES: PERMIT VOID AFTER 2 YEARS

CONTRACTOR IS RESPONSIBLE FOR SCHEDULING A PRE-CONSTRUCTION INSPECTION FOR ALL INSTALLATIONS
WATERTIGHT SEPTIC TANKS REQUIRED
ALL PARTS OF SEPTIC SYSTEM SHALL BE 100 FEET FROM ANY WATER WELL UNLESS SPECIFICALLY AUTHORIZED
MANHOLE RISERS REQUIRED ON ALL SEPTIC TANKS AND PUMP CHAMBERS UNLESS SPECIFICALLY AUTHORIZED
CONTRACTOR RESPONSIBLE FOR COMPLIANCE WITH APPLICABLE REGULATIONS, GUIDELINES AND THE TERMS OF THIS PERMIT


**NEITHER THE HOWARD COUNTY COUNCIL NOR THE HEALTH DEPARTMENT IS
RESPONSIBLE FOR THE SUCCESSFUL OPERATION OF ANY SYSTEM
PERMITTEE RESPONSIBLE FOR OBTAINING FINAL APPROVAL ON THIS PERMIT**

**BUILDING PERMIT SIGNED 410-313-2640 FOR INSPECTION OF SEPTIC SYSTEM
AND RETURNED DO NOT LEAVE ANY REQUEST FOR INSPECTION ON VOICEMAIL**

4/21/05 BOD 153279- DEER

A515249-J

NOT TO SCALE

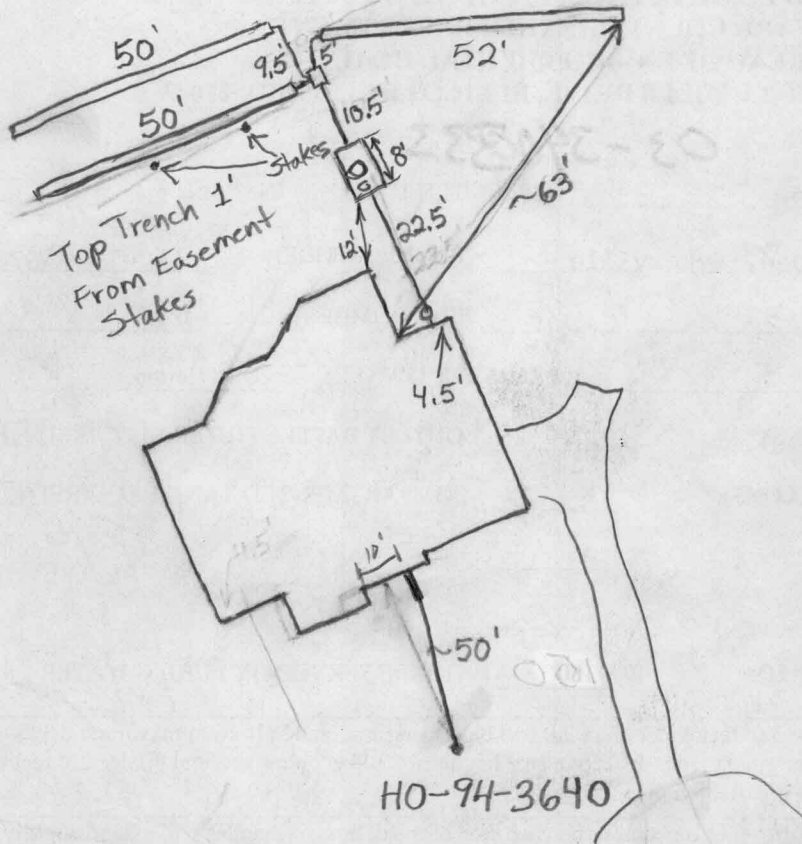

Stiles Way

TRENCH/DRAINFIELD DATA		
WIDTH	INLET	BOTTOM
3'	2'	4'
NUMBER OF TRENCHES <u>3</u>		
TOTAL LENGTH <u>152' + Sidewalk</u>		
ABSORPTION AREA <u>456 + Sidewalk</u>		
DISTRIBUTION BOX LEVEL <u>✓</u>		
DISTRIBUTION BOX BAFFLE <u>Yes</u>		
DISTRIBUTION BOX PORT <u>No</u>		

SEPTIC TANK DATA	
SEPTIC TANK 1 LEVEL	<u>✓</u>
CAPACITY	<u>1250</u> GAL
SEAM LOC	<u>Top</u>
TANK LID DEPTH	<u>1'-1.5'</u>
BAFFLES	<u>Yes</u>
BAFFLE FILTER	<u>—</u>
MANHOLE LOC	<u>Center</u>
6" PORT LOC	<u>Front</u>
WATERTIGHT TEST	<u>No</u>
SEPTIC TANK 2 LEVEL	<u>N/A</u>
CAPACITY	<u>—</u> GAL
SEAM LOC	<u>—</u>
TANK LID DEPTH	<u>—</u>
BAFFLES	<u>—</u>
BAFFLE FILTER	<u>—</u>
MANHOLE LOC	<u>—</u>
6" PORT LOC	<u>—</u>
WATERTIGHT TEST	<u>—</u>

PRE-CONSTRUCTION 7/20/04 Contour off somewhat from B.P. To install 3-50' trenches. (BB)

INSTALLATION 7/20/04 Trenches done. House connection made. Need tank cleanouts. (BB) 7/21/04 - Still needs manhole (EG) 8/2/04 - Manhole & C.O. Installed (EG)

FINAL INSPECTOR

[Signature]

DATE OF APPROVAL

8/2/04

BUILDING PERMIT SIGNED AND RETURNED

