

APPLICATION

PERCOLATION TESTING

A 516057

P _____

HOWARD COUNTY HEALTH DEPARTMENT

BUREAU OF ENVIRONMENTAL HEALTH

3525-H ELLICOTT MILLS DRIVE/ELLICOTT CITY, MARYLAND 21043
TELEPHONE: 313-2640

DISTRICT _____

DATE 10/5/01

TO: THE COUNTY HEALTH OFFICER
ELLICOTT CITY, MARYLAND

I HEREBY APPLY FOR THE NECESSARY TEST PRIOR TO APPLICATION FOR PERMIT TO CONSTRUCT (OR RECONSTRUCT) A SEWAGE DISPOSAL SYSTEM.

PROPERTY OWNER JOHN C BEWLEY, REVOCABLE TRUST
15359 UNION CHAPEL RD.
ADDRESS WOODBINE MD 21797 PHONE _____

AGENT OR PROSPECTIVE BUYER GRAYSON DEV. CO. LLC. c/o KOREN DEV. CO.
815 CENTER PARK DR. STE 104
ADDRESS COLUMBIA MD 21045 PHONE _____

PROPERTY LOCATION:

DIVISION BEWLEY PROPERTY LOT NO. 3

ROAD AND DESCRIPTION UNION CHAPEL RD

TAX MAP 14 PARCEL # 666

SIZE OF LOT ± 1 AC TYPE BLDG. SF. DWELLING
(SINGLE FAMILY DWELLING OR COMMERCIAL)

THE SYSTEM INSTALLED UNDER THIS APPLICATION IS ACCEPTABLE ONLY UNTIL PUBLIC FACILITIES BECOME AVAILABLE. I FULLY UNDERSTAND THE

FEE CONNECTED WITH THE FILING OF THIS PERC TEST APPLICATION IS NON-REFUNDABLE UNDER ANY CIRCUMSTANCES. I ALSO AGREE TO

COMPLY WITH ALL M.O.S.H.A. REQUIREMENTS IN TESTING THIS LOT. DAVID B. YANNOY GRAYSON DEVELOPMENT
(SIGNATURE OF APPLICANT) COMPANY, LLC

APPROVED BY _____ FOR _____ DATE _____

DISAPPROVED BY _____ FOR _____ DATE _____

HOLD PENDING FURTHER TESTS _____

REASONS FOR REJECTION OR HOLDING _____

PERCOLATION TEST PLAT/PRELIMINARY PLAT - TITLE OR I.D. # _____ DATE _____

SITE DEVELOPMENT PLAN/FINAL PLAT - TITLE OR I.D. # _____ DATE _____



THIS IS NOT A PERMIT

516057


COUNTY #

NOT TO SCALE

SOIL PROFILE

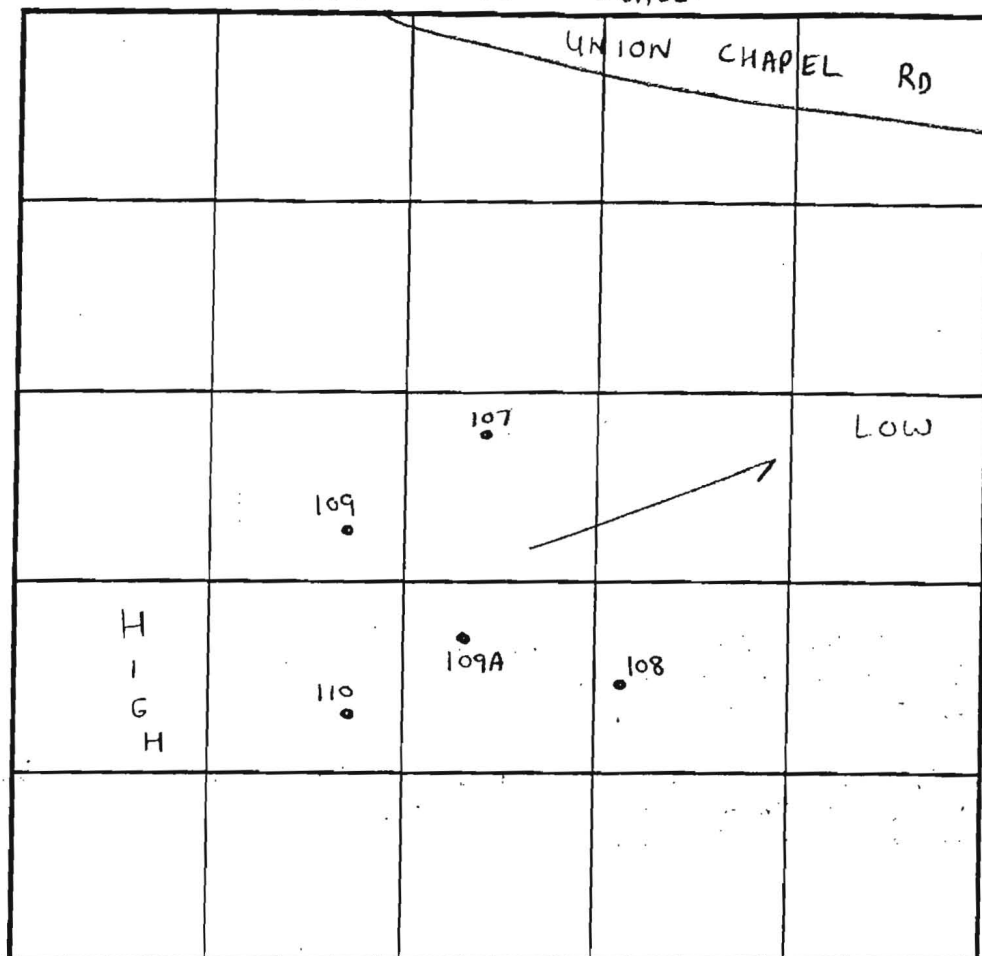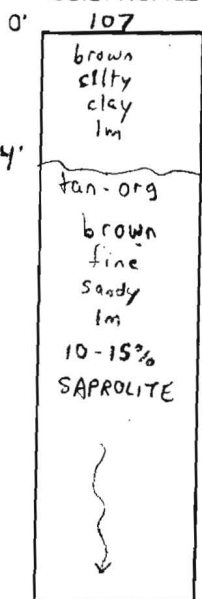

SOIL PROFILE

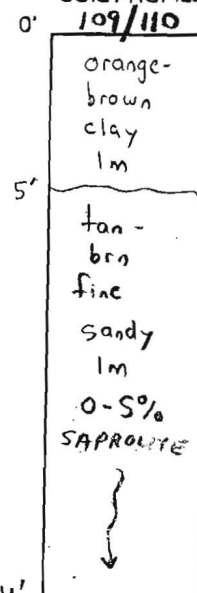

INDICATE NORTH - NAME ADJOINING ROADWAY AS BASE LINE.

DATE	TEST NO.	DEPTH	PRE-WET START	PRE-WET STOP	TEST - 1" DROP START	TEST - 1" DROP STOP	TIME	
3/14/02	107	5' / 14' V	9:41am	9:43am	9:43am	9:46am	3min	OK
	108	4'10" / 14' V	9:50am	9:52am	9:52am	9:54am	2min	OK
	109A	14' V	(VISUAL OK)		SEE SOIL PROFILE			OK
3/12/02	109	5'4" / 14' V	3:44pm	3:48pm	3:48pm	3:58pm	10min	OK
	110	7'8" / 14' V	4:05pm	4:09pm	4:09pm	4:16pm	7min	OK

REMARKS

TYPE OF SOIL GlenelgTESTED BY SRK & FAJeff Allen = Backhoe
Donnie Brown = HelperALSO PRESENT Mark Wedemeyer = Koren DevelopmentTRENCH DESIGN DATA: AVERAGE PERCOLATION TIME 6minTRENCH WIDTH 3'INLET DEPTH 3'MAXIMUM BOTTOM DEPTH 5'SQ. FT./BEDROOM 180

DATE

109

brown silty clay 1m

tan-orange/brn fine sandy 1m

10-15% SAPROLITE

109A

brown topsoil

orange-brown silty clay 1m

tan-org fine sandy 1m

0-5% SAPROLITE
pockets of white decayed feldspar

14'

G&L LTD. PARTNERSHIP
11/21/02
P. 167
RC-DEO EXIST

STEVEN KC
11/21/03

OPEN SPACE
1.9 AC +/-

OPEN SPACE
0.3 AC +/-

