


LIMITS
 DS
 DS BUFFER
 LINE STREAM
 BUFFER
 PLAIN
 TY LINE
 S 25% AND GREATER SLOPE
 X AND 100' WBRL

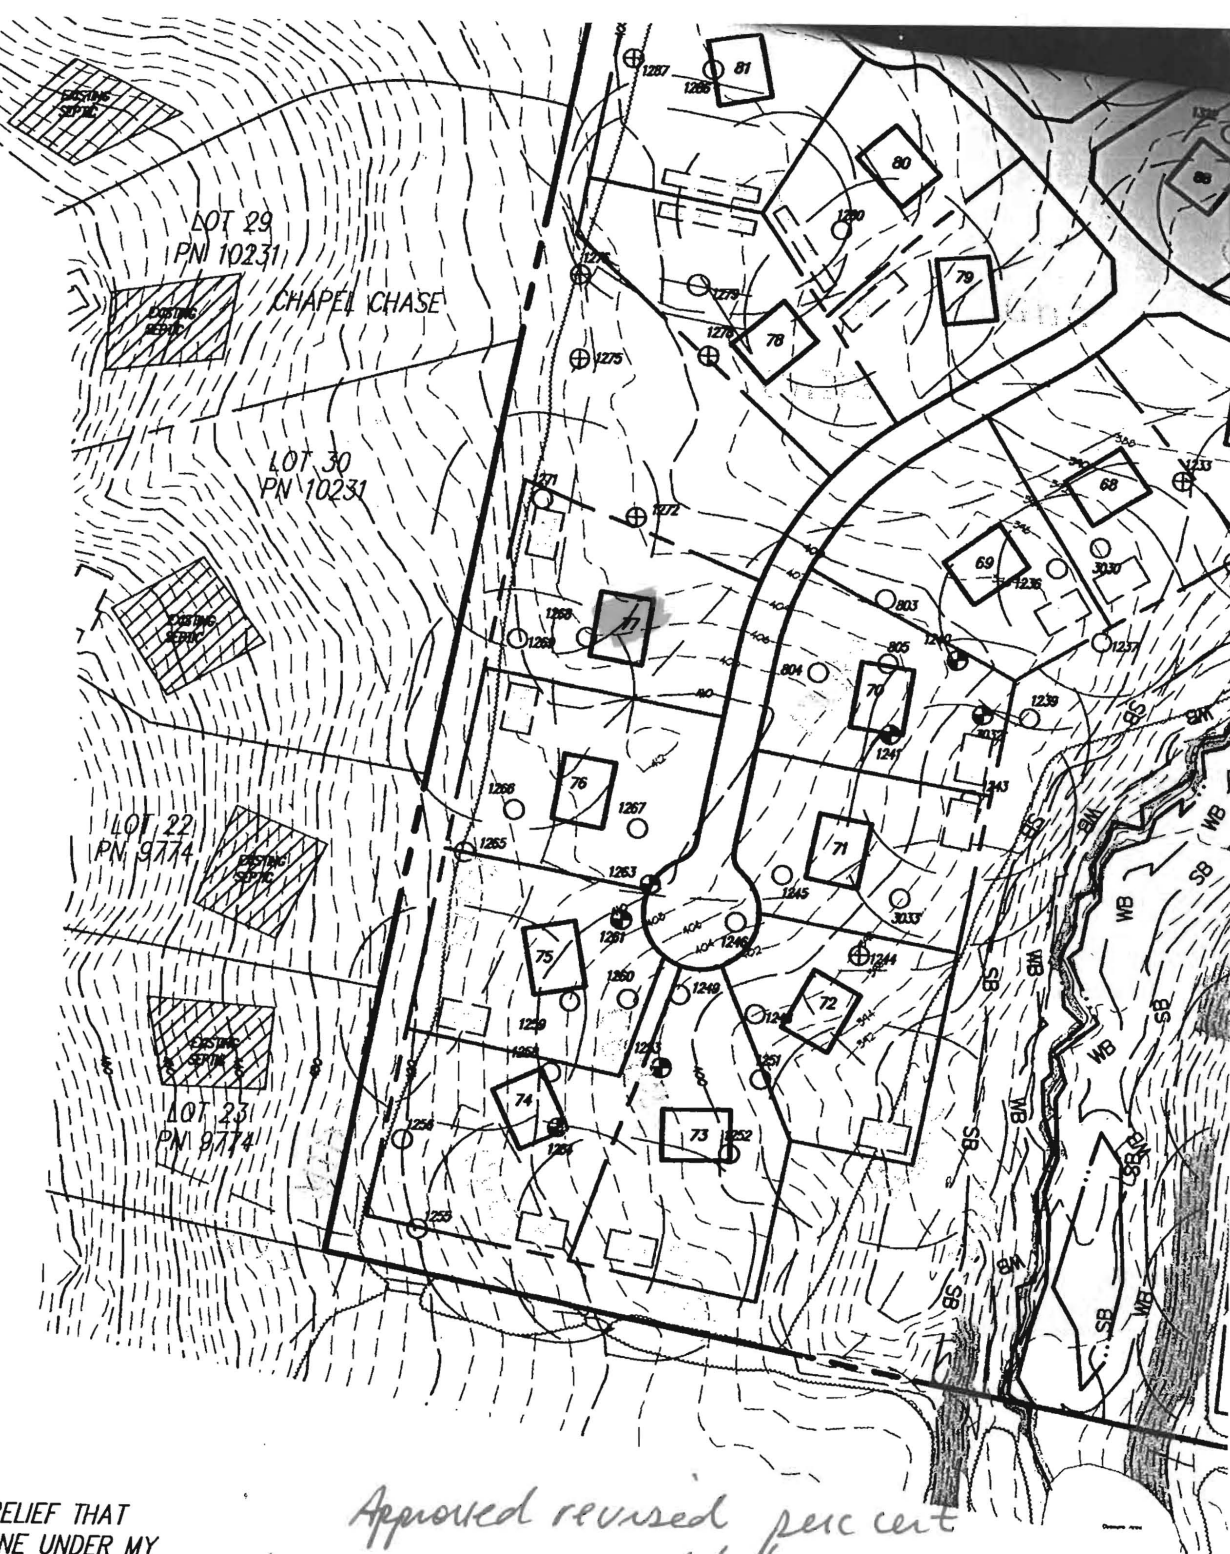


PROFESSIONAL ENGINEER AND BELIEF THAT
 BASED ON THE INFORMATION PROVIDED AND DONE UNDER MY



Approved revised percent
 6/11/07

GENERAL NOTES:

-  THIS AREA DESIGNATES PRIVATE SEWERAGE EASEMENTS OF 850,894 SQUARE FEET AS REQUIRED BY 1 FOR SHARED SEWERAGE DISPOSAL. IMPROVEMENTS OF ANY NATURE I. AVAILABLE. THIS EASEMENT SHALL BECOME NULL AND VOID UPON CC HEALTH OFFICER SHALL HAVE THE AUTHORITY TO GRANT ADJUSTMEN RECORD PLAT APPROVAL. RECORDATION OF A MODIFIED SEWERAGE E.
- THE LOTS SHOWN HEREON COMPLIES WITH THE MINIMUM LOT WID. DEPARTMENT OF THE ENVIRONMENT.
- ALL EXISTING WELLS AND/OR SEWERAGE EASEMENTS WITHIN 100 F. AVAILABLE INFORMATION

DIES ARE PENDING; ACCEPTANCE OF THE
 GUARANTEE ANY PARTICULAR YIELD OF
 RIATE STUDIES SUPPORTING THE USE
 D.

1091, 2319, 2321, 2322, 2327, 2333,
 2349, 4901, 4902, 4903, 4905, 4906,
 4914, 4915, 4916, 4999, 5000