

LAYOUT _____

INSP 1 6/14/2012 INSP 3 _____

INSP 2 _____ INSP 5 _____

ISSUE DATE:

6/14/2012

APPROVAL
DATE:

9/19/2012

PERMIT

SHARED SEPTIC SYSTEM

P 537340

~~K~~

~~P 537339~~

Tax ID # 05-449367

HOUSE SEWER LINE CONNECTION

HOWARD COUNTY HEALTH DEPARTMENT
BUREAU OF ENVIRONMENTAL HEALTH

IS PERMITTED TO INSTALL ☒ ALTER ☐

ADDRESS: _____ PHONE NUMBER: _____

SUBDIVISION Walnut Grove LOT NUMBER: 72

ADDRESS: 5223 Sweet Meadow Lane PROPERTY OWNER: Dr. Manish Ofa

NUMBER OF BEDROOMS: 5

HOUSE SERVED BY PUBLIC WATER? NO

LOCATION:	Install 4" house sewer line connection per the approved site plan.
NOTES:	This permit is limited to the installation of the individual house sewer line connection and installation of the grinder pump, if applicable. The Howard County Bureau of Utilities must be contacted for scheduling of inspection of these items as well, at 410-313-4900.

PLANS APPROVED: Dana Bernard DATE: 8/11/11

PERMIT VOID AFTER 2 YEARS

1. CONTRACTOR IS RESPONSIBLE FOR SCHEDULING A PRE-CONSTRUCTION INSPECTION FOR ALL INSTALLATIONS.
2. ALL PARTS OF SEPTIC SYSTEM SHALL BE 100 FEET FROM ANY WATER WELL UNLESS SPECIFICALLY AUTHORIZED.
3. MANHOLE RISERS REQUIRED ON ALL SEPTIC TANKS AND PUMP CHAMBERS UNLESS SPECIFICALLY AUTHORIZED.
4. CONTRACTOR RESPONSIBLE FOR COMPLIANCE WITH APPLICABLE REGULATIONS, GUIDELINES AND THE TERMS OF THIS PERMIT.
5. NEITHER THE HOWARD COUNTY COUNCIL NOR THE HEALTH DEPARTMENT IS RESPONSIBLE FOR THE SUCCESSFUL OPERATION OF ANY SYSTEM.
6. PERMITTEE RESPONSIBLE FOR OBTAINING FINAL APPROVAL ON THIS PERMIT.

CALL 410-313-1771 FOR INSPECTION HOUSE CONNECTION

NOT TO SCALE

TRENCH/DRAINFIELD DATA
WIDTH INLET BOTTOM


NUMBER OF TRENCHES _____
TOTAL LENGTH _____
ABSORPTION AREA _____
DISTRIBUTION BOX LEVEL _____
DISTRIBUTION BOX BAFFLE _____
DISTRIBUTION BOX PORT _____

SEPTIC TANK DATA

SEPTIC TANK 1 LEVEL _____
MANUFACTURER _____
CAPACITY _____ GAL
SEAM LOC _____
TANK LID DEPTH _____
BAFFLES _____
BAFFLE FILTER _____
MANHOLE LOC _____
6" PORT LOC _____
WATERTIGHT TEST _____
SLOTTED _____
DATE ON LID _____

PUMP/SEPTIC TANK LEVEL

MANUFACTURER _____
CAPACITY _____ GAL
SEAM LOC _____
TANK LID DEPTH _____
BAFFLES _____
BAFFLE FILTER _____
MANHOLE LOC _____
6" PORT LOC _____
WATERTIGHT TEST _____
SLOTTED _____
DATE ON LID _____

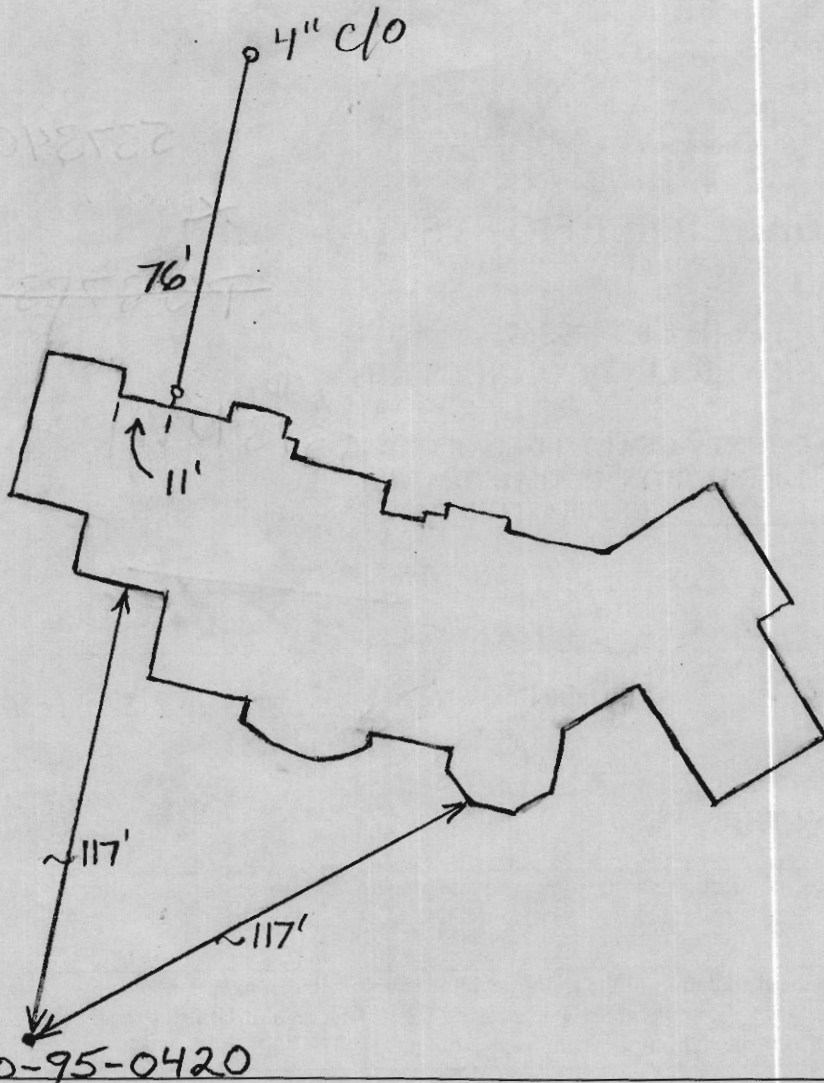

PRE-CONSTRUCTION:

INSTALLATION: 6/14/2012 House connection made. Need approval from utilities. BB

9/19/2012 System approved by utilities. BB

FINAL INSPECTOR B. Baker DATE OF APPROVAL 9/19/2012

$R=60.00'$ $A=72.08'$
 $CHD=N33^{\circ}09'51"E$ $Lc=67.83'$

N/F
DARIUS A, & KIMBERLY A. BAKHTIAR
PIN-05-449359
DB 12458/493



IPS

10' PUBLIC SEWER & UTILITY EASEMENT

20' PRIVATE DRAINAGE EASEMENT

$S79^{\circ}42'59"E$ 211.21'

10' B.R.L.

NON-BUILDABLE
PRESERVATION PARCEL B
WALNUT GROVE
SUBDIVISION

IPS

CONCRETE FOUNDATION
TOP OF FOUNDATION=408.33

FOUNDATION LOCATION DRAWING

#05-449367


LOT #72, WALNUT GROVE
PLAT NUMBER 19225
FIFTH DISTRICT
HOWARD CO., MARYLAND

THIS IS TO CERTIFY THAT THIS PLAT AND THE SURVEY ON WHICH IT IS BASED WERE PREPARED UNDER MY RESPONSIBLE CHARGE. THIS IS NOT A PROPERTY LINE SURVEY.

THIS PLAT WAS PREPARED WITHOUT THE BENEFIT OF A TITLE REPORT WHICH MAY SHOW ADDITIONAL EASEMENTS, RIGHTS-OF-WAY, OR OTHER RESTRICTIONS OR ENCUMBRANCES NOT SHOWN HEREON.


10-10-11

DAVID M. MILLER
PROFESSIONAL LAND SURVEYOR #21427

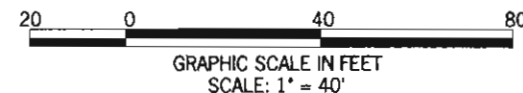

5223 SWEET MEADOW LANE
CLARKSVILLE, MD 21029
FIFTH DISTRICT
HOWARD COUNTY

SCALE: 1" = 40'
CHECKED BY: DMM
DRAWN BY: DMM
DATE: 9-14-11
SHEET: 1 of 1
JOB #: MD11.029

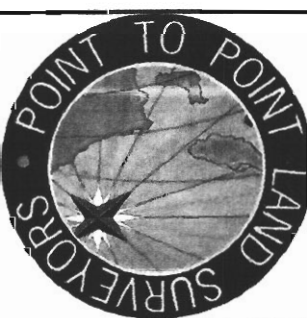

POINT TO POINT LAND SURVEYORS

305 S. Main Street, Lower Level
Mount Airy, MD 21771
(p) 301-703-8319 (f) 301-703-8324
(w) pointtopointsurvey.com