Permits: 410-313-2455 Inspections: 410-313-1810 Automated Line: 410-313-3800

Howard County Building/Fire Permit Application Department of Inspections, Licenses & Permits 3430 Court Hou

Permit Number:

Building Address: 5227	Sivert Mealow La.		10 01
Clarke	e Md 21029	Property Owner's Name:	
		Address: 4550. C.	Mege Aver
Suite/Apt. #	SDP/WP/BA #:	City: E.C. State	2: Zip Code:
Census Tract:	Subdivision:	Home Phone:9195	Work Phone:
Section:	Area:Lot:	Applicant's Name & Mailing Addre	
	el: Grid:		ess, (il other than stated herein):
	nates: Lot Size:		
	Lot 3/28:		_ Fax:
Existing Use: <u>SFD</u> Proposed Use: <u>SFD</u>	100	Email:	
		Contractor Company:	cked Out
Estimated Construction Cost: \$		Contact Person: Carry L	yon
Description of Work: Constru	et 44'x30' inregular	Address: 13726 - Pr	incess Ame Way
deep on Rom	af 3FD up steps to	City: <u>State:</u> State:	Zip Code:
and.	and up steps to	License No.: 47520	
yrade.	~	Phone: (410) 667-4700	_ Fax:
Occupant or Tenant:		Email: Deckbuild	2 Verizon net
Vas tenant space previously occupie	d? 🛛 Yes 🖉 No	Engineer/Architect Company:	
ontact Names Cdass /	0.1		
Untact Name: CATALY (2)			
ddress: 1372(Princes	And Illani	Responsible Design Prof.:	
ddress: 1372C Princes	S Anne Way	Address:	
ity: Phoenia	State: Zip Code: Z1/31	Address:	
ity: <u>Phoenic</u> hone: <u>(410)</u> 303-9921	S. Anne Wary _State: Zip Code: Z1831 _Fax:	Address:State:	Zip Code:
iddress: <u>1372C Princes</u> ity: <u>Phoenia</u> hone: <u>(40) 303-9921</u>	S. Anne Wary _State: Zip Code: Z1831 _Fax:	Address:State: City:State: Phone:	Zip Code:
nddress: <u>1372C Princes</u> ity: <u>Phoenia</u> hone: <u>(Ho) 303-9921</u> mail: <u>Peekbuild@</u>	S Anne Warj _State:Zip Code: Z1831 _Fax: Perizon met	Address:State:	Zip Code:
Iddress: <u>1372C Princes</u> ity: <u>Phoenic</u> hone: <u>(4) 303-9928</u> mail: <u>Peekbuild (2)</u> BUILDING DESCRI	S. Anne Wary _State: Zip Code: Z1831 _Fax:	Address:	Zip Code: Fax:
Iddress: <u>1372C</u> Prencess ity: <u>Phoenic</u> hone: <u>(4)(0) 303-9928</u> mail: <u>Deekbuild (0)</u> BUILDING DESCRI Building Characteristics	S Arre Way _State: Zip Code: Z1#3) _Fax: Perizon net PTION - COMMERCIAL Utilities	Address:State: City:State: Phone: Email: Building Characteristics	Zip Code: Fax: PTION – RESIDENTIAL Utilities
Iddress: <u>1372C</u> Prencess ity: <u>Phoenic</u> hone: <u>(Ho) 303-9928</u> mail: <u>Deekbuild ()</u> <u>BUILDING DESCRI</u> Building Characteristics Height:	S Arre Way _State: Zip Code: Z1#3) _Fax: PERIZON MERCIAL PTION - COMMERCIAL Utilities <u>Water Supply</u>	Address:State: City:State: Phone: Email: Building Characteristics G SF Dwelling G SF Townhouse	Zip Code: Fax: PTION – RESIDENTIAL Utilities
Iddress: <u>1372C Prences</u> ity: <u>Phoenic</u> hone: <u>(4/0) 303-9921</u> mail: <u>Dechhuild (2) s</u> <u>BUILDING DESCRI</u> Building Characteristics Height: No. of stories:	S Arre Way _State: Zip Code: Z1#3) _Fax: Perizon net PTION - COMMERCIAL Utilities	Address:State: City:State: Phone: Email: Building Descent Building Characteristics G SF Dwelling G SF Townhouse Depth Width	Zip Code: Fax: PTION – RESIDENTIAL Utilities
Iddress: <u>1372C Princes</u> ity: <u>Phoenic</u> hone: <u>(Ho) 303-9928</u> mail: <u>Deekbuild@</u> BUILDING DESCRI	S Arre Way _State: Zip Code: Z1#3) _Fax: PERIZON MERCIAL PTION - COMMERCIAL Utilities <u>Water Supply</u>	Address:State: City:State: Phone: Email: Building Characteristics Building Characteristics SF Dwelling SF Townhouse Depth Width 1 st floor:	Zip Code: Fax: PTION – RESIDENTIAL Utilities Water Supply
ddress: <u>1372C Prences</u> ity: <u>Phoenic</u> hone: <u>(46) 303-9924</u> mail: <u>Dechhuild (2005</u> <u>Building Characteristics</u> Height: No. of stories:	S Anno Way _State: Zip Code: Z/13) _Fax: PERION - COMMERCIAL DTION - COMMERCIAL Utilities <u>Water Supply</u> Public Private	Address:State: City:State: Phone: Email: Building Characteristics Building Characteristics SF Dwelling SF Townhouse Depth Width 1 st floor: 2 nd floor:	Zip Code: Fax: PTION – RESIDENTIAL Utilities Water Supply Dublic Private Sewage Disposal
ddress: <u>1372C Princes</u> ity: <u>Phoenic</u> hone: <u>(4w) 303-9921</u> mail: <u>Dechhuild@</u> <u>Building Characteristics</u> Height: No. of stories: Gross area, sq. ft./floor:	S Arre Way _State: Zip Code: Z/#3) _Fax: PERIZON MERCIAL PTION - COMMERCIAL Utilities <u>Water Supply</u> □ Public	Address:State: City:State: Phone: Email: <i>Building Characteristics</i> Building Characteristics Depth Width 1 st floor: 2 nd floor: Basement:	Zip Code: Fax: PTION – RESIDENTIAL Utilities Water Supply Public Private Sewage Disposal Public
ddress: <u>1372C Prences</u> ity: <u>Phoenic</u> hone: <u>(4w) 303-9921</u> mail: <u>Dechhuild@</u> <u>Building Characteristics</u> Height: No. of stories: Gross area, sq. ft./floor:	S Ano Way _State: Zip Code: Z/13) _Fax: Perizon net PTION - COMMERCIAL Utilities <u>Water Supply</u> □ Public □ Private <u>Sewage Disposal</u> □ Public	Address:State: City:State: Phone: Email: Building Characteristics Building Characteristics SF Dwelling SF Townhouse Depth Width 1 st floor: 2 nd floor: Basement: Finished Basement	Zip Code: Fax: PTION – RESIDENTIAL Utilities Water Supply Public Private Sewage Disposal Public Public
ddress: <u>1372C Princes</u> ity: <u>Phoenic</u> hone: <u>(40) 303-992</u> mail: <u>Dechhuild@</u> <u>Building Characteristics</u> Height: No. of stories: Gross area, sq. ft./floor: Area of construction (sq. ft.):	S Arro Wary State: Zip Code: Z103)	Address:State: City:State: Phone: Email: Building Characteristics Building Characteristics SF Dwelling SF Townhouse Depth Width 1 st floor: 2 nd floor: Basement: Finished Basement Unfinished Basement	Zip Code: Fax: PTION – RESIDENTIAL Utilities Water Supply Public Private Sewage Disposal Public Public Private Electric: Yes No
ddress: <u>1372C Princes</u> ity: <u>Phoenic</u> hone: <u>(40) 303-992</u> mail: <u>Dechhuild@</u> <u>Building Characteristics</u> Height: No. of stories: Gross area, sq. ft./floor: Area of construction (sq. ft.):	S Arro Wary State: Zip Code: Z1031	Address:State: City:State: Phone: Email: Building Characteristics Building Characteristics SF Dwelling SF Townhouse Depth Width 1 st floor: 2 rd floor: Basement: Finished Basement Unfinished Basement Crawl Space	Zip Code: Fax: PTION – RESIDENTIAL Utilities Water Supply Public Private Sewage Disposal Public Private Electric: Yes No Gas: Yes No
ddress: <u>1372C Princes</u> ity: <u>Phoenic</u> hone: <u>(40) 303-992</u> mail: <u>Dechhuild@</u> <u>BUILDING DESCRI</u> <u>Building Characteristics</u> Height: No. of stories: Gross area, sq. ft./floor: Area of construction (sq. ft.): Jse group:	State:	Address:State: City:State: Phone: Email: Building Characteristics Building Characteristics GF Dwelling SF Townhouse Depth Width 1 st floor: 2 nd floor: Basement: Finished Basement Unfinished Basement Crawl Space Slab on Grade	Zip Code: Fax: PTION – RESIDENTIAL Utilities Water Supply Public Private Sewage Disposal Private Public Private Electric:YesNo Gas:YesNo
Iddress: <u>1372C Prences</u> ity: <u>Phoenic</u> hone: <u>(4w) 303-992</u> mail: <u>Dechhuild@</u> <u>Building Characteristics</u> Height: No. of stories: Gross area, sq. ft./floor: Area of construction (sq. ft.): Jse group: <u>Construction type:</u>	State: Zip Code: ZI#3) 	Address: City: State: Phone:	Zip Code: Fax: PTION - RESIDENTIAL Utilities Water Supply Public Private Sewage Disposal Public Private Electric: Yes No Gas: Yes No Heating System Electric
Inderess: <u>1372C Prencess</u> ity: <u>Phoenix</u> hone: <u>(4w) 303-992</u> mail: <u>Dechhuidd</u> <u>Building Characteristics</u> Height: No. of stories: Gross area, sq. ft./floor: Area of construction (sq. ft.): Jse group: <u>Construction type:</u> Reinforced Concrete	State: Zip Code: ZI#3) 	Address:State: City:State: Phone: Email: Building Characteristics GSF Dwelling GSF Townhouse Depth Width 1 st floor: 2 nd floor: Basement: Finished Basement Unfinished Basement Crawl Space Slab on Grade No. of Bedrooms: Multi-family Dwelling	Zip Code: Fax: PTION - RESIDENTIAL Utilities Utilities Water Supply Public Private Sewage Disposal Public Private Electric: Yes No Gas: Yes No Heating System Electric
ddress: <u>1372C Prences</u> ity: <u>Phoenix</u> hone: <u>(4w) 303-992</u> mail: <u>Dechhuidd</u> <u>Building Characteristics</u> Height: No. of stories: Gross area, sq. ft./floor: Area of construction (sq. ft.): Jse group: <u>Construction type:</u>] Reinforced Concrete] Structural Steel	State: Zip Code: ZI#3) 	Address: City: State: Phone:	Zip Code: Fax: PTION – RESIDENTIAL Utilities Water Supply Public Private Sewage Disposal Private Electric: Yes No Gas: Yes No Heating System Electric Oil Natural Gas
ddress: <u>1372C</u> Princes, ity: <u>Phoenia</u> hone: <u>(Ho) 303-992</u> mail: <u>Decharica</u> <u>Building Characteristics</u> Height: No. of stories: Gross area, sq. ft./floor: Area of construction (sq. ft.): Jse group: <u>Construction type:</u>] Reinforced Concrete] Structural Steel] Masonry		Address:	Zip Code: Fax: PTION - RESIDENTIAL Utilities Utilities Water Supply Public Private Sewage Disposal Public Private Electric: Yes No Gas: Yes No Heating System Electric
ddress: <u>1372C</u> Princes, ity: <u>Phoenia</u> hone: <u>(Ho) 303-992</u> mail: <u>Decharica</u> Building Characteristics Height: No. of stories: Gross area, sq. ft./floor: Area of construction (sq. ft.): Jse group: <u>Construction type:</u> Reinforced Concrete Structural Steel Masonry Wood Frame	State: Zip Code: ZI#3) 	Address:State: City:State: Phone: Email: Building Characteristics Building Characteristics SF Dwelling SF Townhouse Depth Width 1 st floor: 2 nd floor: Basement: Finished Basement Crawl Space Slab on Grade No. of Bedrooms: Multi-fomily Dwelling No. of efficiency units: No. of 1 BR units:	Zip Code: Fax: PTION – RESIDENTIAL Utilities Water Supply Public Private Sewage Disposal Private Electric: Yes No Gas: Yes No Heating System Electric Oil Natural Gas
ddress: <u>1372C</u> Princes, ity: <u>Phoenix</u> hone: <u>(4w) 303-992</u> mail: <u>Decharille</u> <u>s</u> Building Characteristics Height: No. of stories: Gross area, sq. ft./floor: Area of construction (sq. ft.): Jse group: <u>Construction type:</u> Reinforced Concrete Structural Steel Masonry Wood Frame State Certified Modular		Address: City: State: Phone:	Zip Code: Fax: PTION – RESIDENTIAL Utilities Water Supply Public Private Sewage Disposal Private Electric: Yes No Gas: Yes No Heating System Electric Oil
ddress: <u>1372C</u> Princes, ity: <u>Phoenia</u> hone: <u>(Ho) 303-992</u> mail: <u>Decharica</u> Building Characteristics Height: No. of stories: Gross area, sq. ft./floor: Area of construction (sq. ft.): Jse group: <u>Construction type:</u> Reinforced Concrete Structural Steel Masonry Wood Frame State Certified Modular		Address: City: State: Phone:	Zip Code: Fax: PTION – RESIDENTIAL Utilities Water Supply Public Private Sewage Disposal Private Electric: Yes No Gas: Yes No Heating System Electric Oil Natural Gas
ddress: <u>1372C</u> Princes, ity: <u>Phoenix</u> hone: <u>(4w) 303-992</u> mail: <u>Decharica</u> <u>Building Characteristics</u> Height: No. of stories: Gross area, sq. ft./floor: Area of construction (sq. ft.): Jse group: <u>Construction type:</u> Reinforced Concrete Structural Steel Masonry Wood Frame	State: Zip Code: ZI#3) 	Address: City:	Zip Code: Fax: PTION - RESIDENTIAL Utilities Water Supply Public Private Sewage Disposal Public Private Electric: Yes No Gas: Yes No Heating System Electric Oil Natural Gas Propane Gas
address: 1372C Princes. ity: Phoenia hone: Association hone: Association mail: Decharateristics Building Characteristics Height: Building Characteristics No. of stories: Bross area, sq. ft./floor: Gross area, sq. ft./floor: Stee group: Stee group: Structural Steel Masonry Wood Frame State Certified Modular Roadside Tree Project Permit Orse INo	State: Zip Code: ZI#3) 	Address: City: State: Phone:	Zip Code: Fax: PTION - RESIDENTIAL Utilities Water Supply Public Private Sewage Disposal Public Private Electric: Yes No Gas: Yes No Gas: Yes No Heating System Electric Oil Natural Gas Propane Gas No
iddress: 1372C Princes, ity: Phoenix ity: hone: (4w) 303-9921 mail: Decharille ity: mail: Decharille ity: Building Characteristics Building Characteristics Height: No. of stories: ity: Gross area, sq. ft./floor: ity: Jse group: ity: Structural Steel Ity: I Masonry Wood Frame I State Certified Modular Roadside Tree Project Permit	Ame Way State: Zip Code: ZIN3; Fax: Fax: PTION - COMMERCIAL Utilities Utilities Vater Supply Public Private Electric: Yes No Gas: Yes No Heating System Electric Oil Natural Gas Propane Gas Sprinkler System: N/A Full Partial Other Suppression	Address: City:	Zip Code: Fax: PTION - RESIDENTIAL Utilities Water Supply Public Private Sewage Disposal Public Private Electric: Yes No Gas: Yes No Heating System Electric Oil Natural Gas Propane Gas Roadside Tree Project Permi

Deckba nail Address 11 Out Owner 7 le/Company

Checks Payable to: DIRECTOR OF FINANCE OF HOWARD COUNTY **PLEASE WRITE NEATLY & LEGIBLY** -FOR OFFICE USE ONLY-

12

Front: Rear: Side: Side St.:

DPZ SETBACK INFORMATION

All minimum setbacks met?

Historic District?

Is Entrance Permit Required?

Lot Coverage for New Town Zone: SDP/Red-line approval date:

Date

AGENCY	DATE	SIGNATURE OF APPROVAL
tate Highways		
uilding Officials		
SZA (Zoning)		
SZA (Engineering)		
ealth	6-28-12	Heree Satt
ire Protection		- 0 30 01
Sediment Control app	roval require	d for issuance? 🗆 Yes 🗆 No

] CONTINGENCY CONSTRUCTION START] ONE STOP SHOP

	Filing Fee	\$
	Permit Fee	\$
	Tech Fee	\$
	Excise Tax	\$
	PSFS	\$
	Guaranty Fund	\$
□No	Add'l per Fee	\$
□No	Total Fees	\$
□No	Sub- Total Paid	\$
	Balance Due	\$

ution of copies:	White: Building Officials	Green: PSZA,Zoning
rations\Updated	Forms\New building app 11.1	0.2010.docx

.....


ution of Caston


Yellow: PSZA, Engineering Pink: Health

□ Yes


□ Yes

Gold: SHA

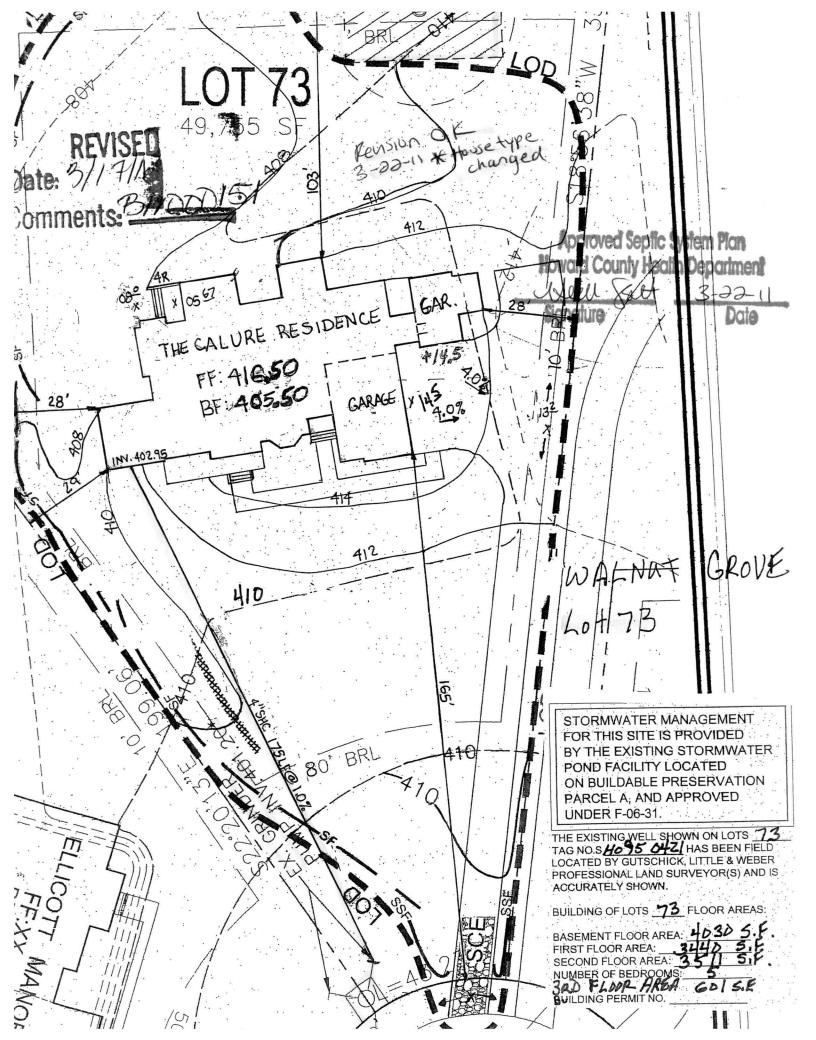

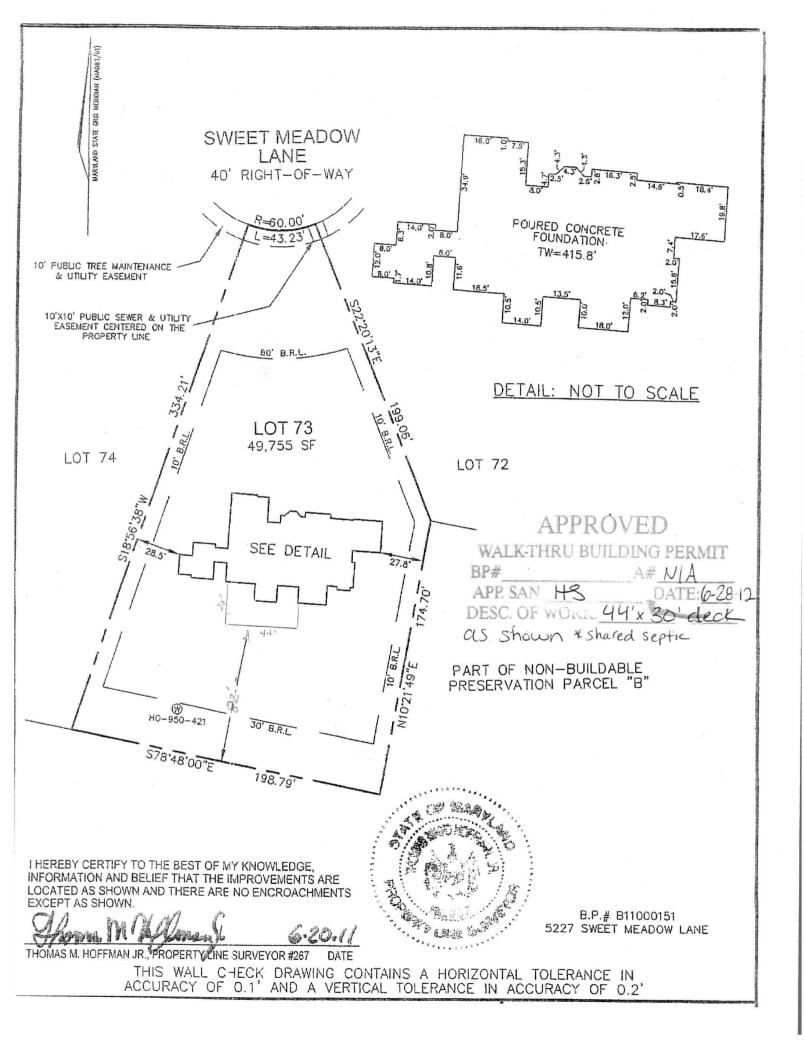

110 Var

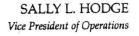

3675 Park Ave., Suite 301 Ellicott City, MD 21043

Office 410-313-8722 Fax 410-313-8731 sally@trinityhomes.com

TH TRINITY HOMES

dedicated to excellence and service

Dear Avis,

3/17/11

RE: Building permit #B11000151 Lot #73 Walnut Grove 5227 Sweet Meadow La. Clarksville 21029

Please revise this house type to an Ellicott Manor, 3 story, full basement, 13 R, 4 FB, 2 HB, 3 FP, balcony off MBR & 2 garages (5 BR) finished basement w/1 HB & 1 FB. Enclosed are 5 site plans, 2 sets of construction drawings and a \$50 check. Please let me know if there are additional fees due and when this has your approval.

Thank you.

Sally & Hadge

Sally Hodge

CC: ZONIY health



LICENSES & PERMITS DIVISION

1022266 234984

3430 COURT HOUSE DRIVE		COUNTY	PERMIT NUM	SEK .
ELLICOTT CITY, MD 21043 PERMITS (410) 313-2455 INSPECTIONS (410) 313-1810	FERMITAF	PLICATION	RIG	0151
AUTOMATED INFORMATION (410) 313-1810	SICLET MEDICE	Property Owne	r's Name 7 RINII	Y QUALITY NOM
CLARKSVILLE	21029	Address	25 INER DU	H GUNGATHOM
nite/Apt. #: SD	PP/WP/Petition #: <u>6 P-11.3</u>	Home Phone	Wor	$\frac{1}{2} \sum_{k \text{ Phone } \underline{410} - \underline{313} - \underline{520}}^{2}$ k Phone $\underline{410} - \underline{313} - \underline{520}_{2}$ k, (if other than stated herein):
ensus Tract	Subdivision			, (
ctionA	Area Lot 23			
x Map _ 28 Parcel	1Grid			
oning Man Coord	linates Hay Lot Size 4975	Phone	Fa	x 410-313-5731
cisting Use Uncha		Contractor Con	mpany <u>7 CINIII</u>	QUALIT HAMLS
oposed Use 5/D stimated Construction Cost	C 200 104	Contact Person	SALLY HADE	1 1
escription of Work A Park	368-2310RY 111	16 City/1110	on Cit State m	Zip Code 21643
SINT LOR, 21 5 BKS	B, IHB, FPSCAR	License No.	a general second s	x 410
ccupant or Tenant N//)	Engineer or A	rchitect Company Al	In
		Contact Person	n	
ldress				
	eZip Code			Zip Code
none State				
.one	1`ax			
BUILDING DESC	CRIPTION - <u>COMMERCIAL</u>			ON – <u>RESIDENTIAL</u>
Building Characteristics	Utilities Water Supply:	SF Dwelling	<u>g Characteristics</u> SF Townhouse □	Utilities Water Supply:
	Public	Depth 1 st floor:	Vidth	Public Private
b. of stories:	Private Sewage Disposal:	2 nd floor:		Sewage Disposal:
oss area, sq. ft. per floor:	Public Private	Basement:		Public Private
se group:	Electric Yes 🗆 No 🗆	space (□ Unfinished Basement 😰 Crawl □ Slab on Grade 🗆	Electric Yes I No 🗆
onstruction type:	$\begin{array}{cccc} \text{Electric} & \text{Yes} \ \Box & \text{No} \ \Box \\ \text{Gas} & \text{Yes} \ \Box & \text{No} \ \Box \end{array}$	No. of Bedrooms	5	Gas Yes No 🗆
Reinforced Concrete Structural Steel	Heating System:	Multi-family dwe		Heating System:
Masonry	Electric Oil Oil	No. of efficiency No. of 1 BR units	units:	Electric D Oil D Natural Gas D
Wood Frame	Natural Gas □ Propane Gas □	No. of 2 BR units No. of 3 BR units		Propane Gas
State Certified Modular	Sprinkler system: N/A □			Sprinkler system: N/A
	Full Partial	Other Structure: _ Dimensions:		NFPA #13D NFPA #13R
	Other Suppression	Footings: Roof:	<u> </u>	Other:
	# of Heads			
		State Certif Manufactur		
HE UNDERSIGNED HEREBY CER	TIFIES AND AGREES AS FOLLOWS: (1) T COMPLY WITH ALL REGULATIONS OF HO PERTY NOT SPECIFICALLY DESCRIBED IN	WARD COUNTY WHICH ARE THIS APPLICATION; (5) TH	E APPLICABLE THERETO; (4) AT HE/SHE GRANTS COUNT	ATION; (2) THAT THE INFORMATION THAT HE/SHE WILL PERFORM NO WO Y OFFICIALS THE RIGHT TO ENTER ON
ORRECT; (3) THAT HE/SHE WILL O IN THE ABOVE REFERENCED PRO HIS PROPERTY FOR THE PURPOSE Applicant's Signature	E OF INSPECTING THE WORK PERMITTED .	Print Nam	11/ 110061	
CORRECT; (3) THAT HE/SHE WILL O IN THE ABOVE REFERENCED PRO- HIS PROPERTY FOR THE PURPOSE Applicant's Signature	E OF INSPECTING THE WORK PERMITTED	Print Nam	<u>L / 1100GL</u>	
ORRECT; (3) THAT HE/SHE WILL O IN THE ABOVE REFERENCED PRO HIS PROPERTY FOR THE PURPOSE Applicant's Signature CALLY CONTRACTOR Email Address	NITING THE WORK PERMITTED.	Print Nan	14/10061	
ORRECT; (3) THAT HE/SHE WILL O N THE ABOVE REFERENCED PRO HIS PROPERTY FOR THE PURPOSE poplicant's Signature DILLY DILLY mail Address	NITANOMIS . 20	<u>SA4</u> Print Nan	114/10	
ORRECT; (3) THAT HE/SHE WILL O N THE ABOVE REFERENCED PRO HIS PROPERTY FOR THE PURPOSE pplicant's Signature mail Address	E OF INSPECTING THE WORK PERMITTED	Drint Nam)14/10 oward county	
CRRECT; (3) THAT HE/SHE WILL C N THE ABOVE REFERENCED PRO HIS PROPERTY FOR THE PURPOSE Definition of the purpose Definition o	E OF INSPECTING THE WORK PERMITTED	Date TOR OF FINANCE OF H RITE NEATLY AND LEGII R OFFICE USE ONLY - DPZ SETBACK INFO)14/10 oward county bly.** ormation	PROPERTY ID #
CRRECT; (3) THAT HE/SHE WILL C N THE ABOVE REFERENCED PRO HIS PROPERTY FOR THE PURPOSE Definition of the purpose Definition o	E OF INSPECTING THE WORK PERMITTED	Date TOR OF FINANCE OF H RITE NEATLY AND LEGH R OFFICE USE ONLY - DPZ SETBACK INFF Front:)14/10 oward county bly.** <u>ormation</u>	
CRRECT; (3) THAT HE/SHE WILL C N THE ABOVE REFERENCED PRO HIS PROPERTY FOR THE PURPOSE pplicant's Signature mail Address POPLATE itle/Company GENCY and Development, DPZ	E OF INSPECTING THE WORK PERMITTED	Date TOR OF FINANCE OF H RITE NEATLY AND LEGII R OFFICE USE ONLY - DPZ SETBACK INFO)14/10 oward county bly.** <u>ormation</u>	PROPERTY ID #
ORRECT; (3) THAT HE/SHE WILL ON N THE ABOVE REFERENCED PRO- HIS PROPERTY FOR THE PURPOSE policant's Signature mail Address POLICIENT itle/Company GENCY DATE and Development, DPZ tate Highways	E OF INSPECTING THE WORK PERMITTED	Date TOR OF FINANCE OF H RITE NEATLY AND LEGH R OFFICE USE ONLY - DPZ SETBACK INFF Front:)14/10 oward county bly.** ormation	PROPERTY ID # Filing fee \$ Permit fee \$ Excise tax \$
ORRECT; (3) THAT HE/SHE WILL ON IN THE ABOVE REFERENCED PRO- HIS PROPERTY FOR THE PURPOSE pplicant's Signature mail Address HICLY DATE and Development, DPZ tate Highways uilding Officials	E OF INSPECTING THE WORK PERMITTED	Date TOR OF FINANCE OF H RITE NEATLY AND LEGI R OFFICE USE ONLY - DPZ SETBACK INFO Front: Rear: Rear:	0ward county bly.**	PROPERTY ID # Filing fee \$ Permit fee \$
ORRECT; (3) THAT HE/SHE WILL ON N THE ABOVE REFERENCED PRO- HIS PROPERTY FOR THE PURPOSE pplicant's Signature mail Address Title/Company GENCY DATE and Development, DPZ tate Highways cuilding Officials Dev. Engineering, DPZ	E OF INSPECTING THE WORK PERMITTED	Print Nan Print Nan Date TOR OF FINANCE OF H RITE NEATLY AND LEGH R OFFICE USE ONLY - DPZ SETBACK INFF Front: Rear: Rear: Side: Side:	0WARD COUNTY BLY.** ORMATION	PROPERTY ID # Filing fee \$ Permit fee \$ Excise tax \$
ORRECT; (3) THAT HE/SHE WILL ON N THE ABOVE REFERENCED PRO HIS PROPERTY FOR THE PURPOSE Applicant's Signature Comail Address Title/Company CGENCY DATE Cand Development, DPZ Catate Highways Building Officials Dev. Engineering, DPZ Health 2-1-11	E OF INSPECTING THE WORK PERMITTED	Print Nam	0WARD COUNTY BLY.** ORMATION	PROPERTY ID # Filing fee \$
ORRECT; (3) THAT HE/SHE WILL O N THE ABOVE REFERENCED PRO HIS PROPERTY FOR THE PURPOSE Applicant's Signature Email Address Citle/Company AGENCY DATE Land Development, DPZ State Highways Building Officials Dev. Engineering, DPZ Health $2 - [-1]$ Fire Protection As Sediment Control approval reco	E OF INSPECTING THE WORK PERMITTED	Date TOR OF FINANCE OF H RITE NEATLY AND LEGH R OFFICE USE ONLY - DPZ SETBACK INFF Front: Rear: Side: Side St.: All minimum setback YES □ NO □ Is Entrance Permit R	<u>)14/10</u> OWARD COUNTY BLY.** ORMATION 	PROPERTY ID #Filing fee\$Permit fee\$Excise tax\$Add'l per fee\$TOTAL FEES\$Sub-total paid\$Balance due\$
ORRECT; (3) THAT HE/SHE WILL C N THE ABOVE REFERENCED PRO HIS PROPERTY FOR THE PURPOSE Applicant's Signature Comail Address Mile/Company CENCY DATE Cand Development, DPZ State Highways Building Officials Dev. Engineering, DPZ Health 2-1-11 Cire Protection	E OF INSPECTING THE WORK PERMITTED	Print Nan Print	<u>)14/10</u> OWARD COUNTY BLY.** ORMATION 	Filing feePROPERTY ID #Permit fee\$Excise tax\$Add'l per fee\$TOTAL FEES\$Sub-total paid\$
ORRECT; (3) THAT HE/SHE WILL C IN THE ABOVE REFERENCED PRO HIS PROPERTY FOR THE PURPOSE Applicant's Signature Cmail Address Title/Company CGENCY DATE And Development, DPZ State Highways Building Officials Dev. Engineering, DPZ Health 2-1-11 Fire Protection s Sediment Control approval records YES NO D	E OF INSPECTING THE WORK PERMITTED	Print Nan Print Nan Date TOR OF FINANCE OF H RITE NEATLY AND LEGH R OFFICE USE ONLY - DPZ SETBACK INFF Front: Rear: Side: Side St.: All minimum setback YES □ NO □ Is Entrance Permit R YES □ NO □	//4//0 OWARD COUNTY BLY.** ORMATION 	PROPERTY ID # Filing fee \$

