

LAYOUT 2/25/09 INSP 4 _____
INSP 2 2/26/09 INSP 5 _____
INSP 3 _____ INSP 6 _____

ISSUE DATE: 2/23/09

APPROVAL DATE: 2/26/09

PERMIT

P 530315

A Repair

TAX ID # 03-282082

ON-SITE SEWAGE DISPOSAL SYSTEM HOWARD COUNTY HEALTH DEPARTMENT BUREAU OF ENVIRONMENTAL HEALTH

Fogles' Septic IS PERMITTED TO INSTALL ☒ ALTER ☐

ADDRESS: 580 Ubrecht Rd PHONE NUMBER: 410-795-3432

SUBDIVISION: _____ LOT NUMBER: _____

ADDRESS: 2665 Thompson Dr. PROPERTY OWNER: Dan Cichetti

SEPTIC TANK CAPACITY (GALLONS): Ex 1000 OUTLET BAFFLE FILTER REQUIRED ☐

PUMP CHAMBER CAPACITY (GALLONS): N/A COMPARTMENTED TANK REQUIRED ☐

NUMBER OF BEDROOMS: 3

SQUARE FEET PER BEDROOM: 0.8

LINEAR FEET OF TRENCH REQUIRED: 94

TRENCHES:	Trench to be <u>3</u> feet wide. Inlet <u>4</u> feet below original grade. Bottom maximum depth <u>7</u> feet below original grade. Effective area begins at <u>4</u> feet below original grade. <u>3</u> feet of stone below distribution pipe.
LOCATION:	
NOTES:	

PLANS APPROVED: SO

DATE: 2-24-09

NOTE: PERMIT VOID AFTER 2 YEARS

NOTE: CONTRACTOR RESPONSIBLE FOR SCHEDULING A PRE-CONSTRUCTION INSPECTION FOR ALL INSTALLATIONS

NOTE: WATERTIGHT SEPTIC TANKS REQUIRED

NOTE: ALL PARTS OF SEPTIC SYSTEM SHALL BE 100 FEET FROM ANY WATER WELL

NOTE: MANHOLE RISERS REQUIRED ON ALL SEPTIC TANKS AND PUMP CHAMBERS UNLESS SPECIFICALLY AUTHORIZED


NEITHER THE HOWARD COUNTY COUNCIL NOR THE HEALTH DEPARTMENT IS
RESPONSIBLE FOR THE SUCCESSFUL OPERATION OF ANY SYSTEM
PERMITTEE RESPONSIBLE FOR OBTAINING FINAL APPROVAL ON THIS PERMIT
CALL 410-313-2640 FOR INSPECTION OF SEPTIC SYSTEM

Thompson Drive

NOT TO SCALE

Public H₂O

Ex. House.

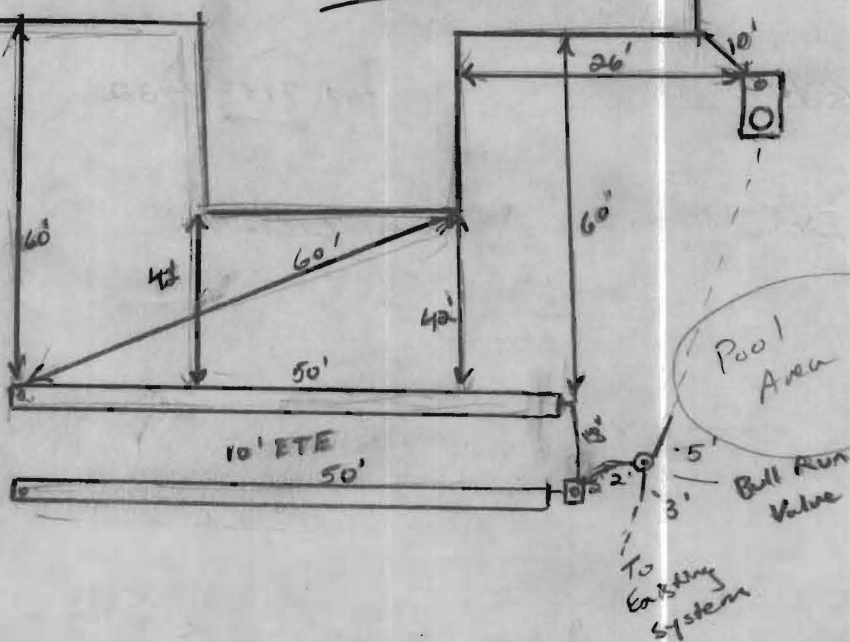

TRENCH/DRAINFIELD DATA

WIDTH 3' INLET 4' BOTTOM 7'

NUMBER OF TRENCHES 2

TOTAL LENGTH 100

ABSORPTION AREA 300' ± SW

DISTRIBUTION BOX LEVEL Yes

DISTRIBUTION BOX BAFFLE Yes

DISTRIBUTION BOX PORT Yes

SEPTIC TANK DATA

SEPTIC TANK 1 LEVEL ?

MANUFACTURER ?

CAPACITY 1000 GAL

SEAM LOC mid

TANK LID DEPTH ~ 2'

BAFFLES

BAFFLE FILTER

MANHOLE LOC Rear (new)

6" PORT LOC Front

WATERTIGHT TEST

SLOTTED

PUMP/SEPTIC TANK LEVEL

MANUFACTURER

CAPACITY GAL

SEAM LOC

TANK LID DEPTH

BAFFLES

BAFFLE FILTER

MANHOLE LOC

6" PORT LOC

WATERTIGHT TEST

SLOTTED

PRE-CONSTRUCTION

2/25/09 - In: tail (2)

47' trenches on best contour parallel to old trenches. Shot

contour, slope is 12" over 50'. Told contractor to split the difference and keep invert & bottom level. Check rear baffle & install man hole. Contractor asked to install bull run valve. That's OK (S)

INSTALLATION

2/26/09 system installed per start order. Ex. Drains fields 100% cut-in. Bull-Run valve installed but will not be used for long time. OK to backfill (CW)

FINAL INSPECTOR

Ku

DATE OF APPROVAL

2/26/09