

APPLICATION

PERCOLATION TESTING

A 50087A

P _____

HOWARD COUNTY HEALTH DEPARTMENT

BUREAU OF ENVIRONMENTAL HEALTH

3525-H ELLICOTT MILLS DRIVE/ELLICOTT CITY, MARYLAND 21043
TELEPHONE 313-2640

DISTRICT _____

DATE 4/14/94

TO: THE COUNTY HEALTH OFFICER
ELLICOTT CITY, MARYLAND

I HEREBY APPLY FOR THE NECESSARY TEST PRIOR TO APPLICATION FOR PERMIT TO CONSTRUCT (OR RECONSTRUCT) A SEWAGE DISPOSAL SYSTEM.

PROPERTY OWNER Mary Ann Noreis Henry R. Wainwright III
Terry Lee Noreis Sarah Louise Timko

ADDRESS Wainwright Rd. Highland Md PHONE 410-923-2348
20777

AGENT OR PROSPECTIVE BUYER _____

ADDRESS 1501 Palisades Blvd PHONE _____
Crownsville Md 21034

PROPERTY LOCATION _____

SUBDIVISION _____ LOT NO. Parcel 3

ROAD AND DESCRIPTION West of Rt 106 in 5th Election District

TAX MAP 40 PARCEL # 8506

SIZE OF LOT 13.9696 Ac TYPE BLDG. Single Family
(SINGLE FAMILY DWELLING OR COMMERCIAL)

THE SYSTEM INSTALLED UNDER THIS APPLICATION IS ACCEPTABLE ONLY UNTIL PUBLIC FACILITIES BECOME AVAILABLE. I FULLY UNDERSTAND THE

BE CONNECTED WITH THE FILING OF THIS PERC TEST APPLICATION IS NON-REFUNDABLE UNDER ANY CIRCUMSTANCES. I ALSO AGREE TO

COMPLY WITH ALL M.O.S.H.A. REQUIREMENTS IN TESTING THIS LOT. Oliver L. Ketter
(SIGNATURE OF APPLICANT)

APPROVED BY _____ FOR _____ DATE _____

APPROVED BY _____ FOR _____ DATE _____

OLD PENDING FURTHER TESTS _____

REASONS FOR REJECTION OR HOLDING PERC SANDY HOLD FOR PLAT MR 5/15/94

PERCOLATION TEST PLAT/PRELIMINARY PLAT - TITLE OR I.D. # _____ DATE _____

DEVELOPMENT PLAN/FINAL PLAT - TITLE OR I.D. # _____ DATE _____

THIS IS NOT A PERMIT

500879

Parcel (3)

COUNTY #

SOIL PROFILE

brn org

si cl

lm

org tan

sa lm

10-15%

frags

org

si-cl

lm

tan

sa


mica

loam

10-15%

frags

SOIL PROFILE

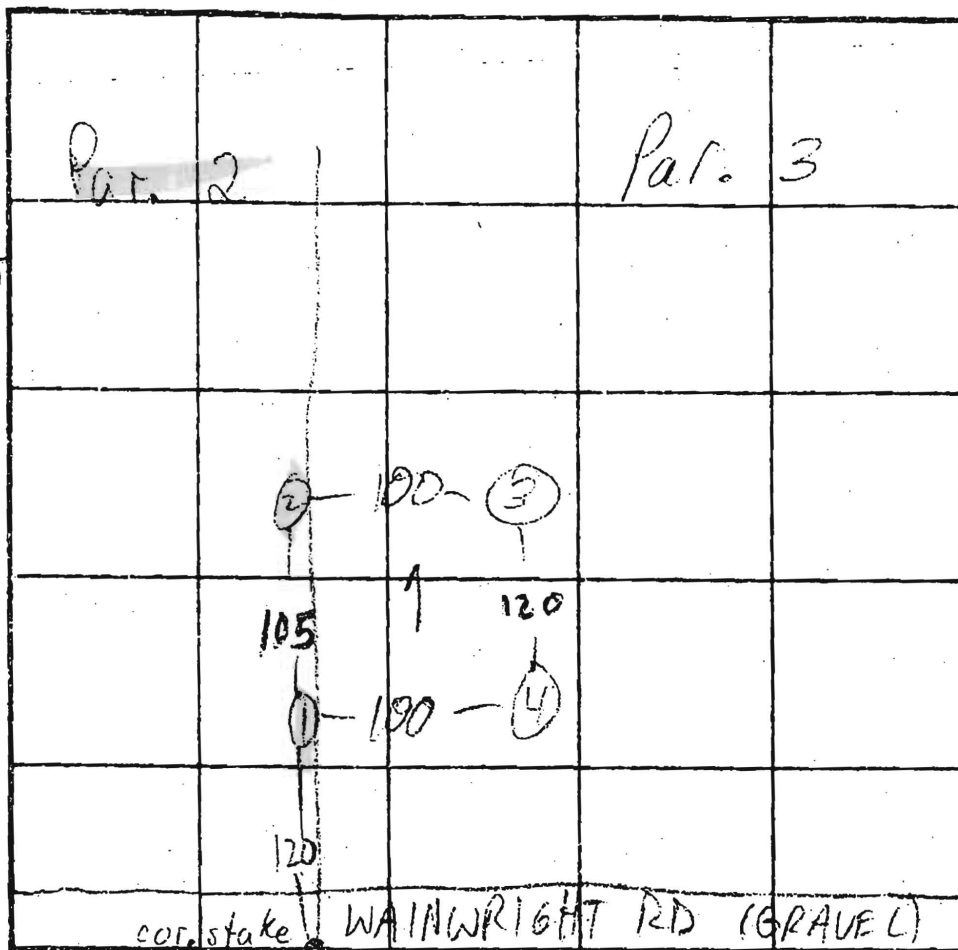

INDICATE NORTH - NAME ADJOINING ROADWAY AS BASE LINE.

← to RT. 108

DATE	TEST NO.	DEPTH	PRE-WET		TEST - 1" DROP		TIME
			START	STOP	START	STOP	
8/25/77	1 S	3 1/2 HI	10:49	11:20	31 min	1" REDIG	
		5 SIDE	11:40	12:13	33 min	1" REDIG	
	1 S	LOW SIDE 3	12:39	12:42	12:42	12:47	5
	1 H	7'9"	10:53:20	10:54:10	10:54:10	10:55:40	1 1/2 min
	1 V	11 1/2'					
	2 S	4'9"	11:20	11:40	1" REDIG		
	2 S	4'9"	11:52	12:15	4" REDIG		
	2 S	5'	12:51	12:52	12:52	12:58	6
	2 V	11'	15-20% frags				
	3 S	3 1/2'	12:27	12:28:30	12:28:30	12:31:30	3
	3 V	10'					
	4 V	10'4"					

REMARKS

TYPE OF SOIL

TESTED BY M. Rifkin

ALSO PRESENT OK Jr. owners

TRENCH DESIGN DATA: AVERAGE PERCOLATION TIME

TRENCH WIDTH

INLET DEPTH

MAXIMUM BOTTOM DEPTH

1. SUBJECT PROPERTY ZONED : RR-DEO
2. THIS AREA DESIGNATES A PRIVATE SEWAGE EASEMENT OF 10,000 S.F. AS REQUIRED BY THE MO STATE DEPT. OF THE ENVIRONMENT FOR INDIVIDUAL SEWAGE DISPOSAL. IMPROVEMENTS OF ANY NATURE IN THIS AREA ARE RESTRICTED. THIS EASEMENT SHALL BECOME NULL & VOID UPON CONNECTION TO A PUBLIC SEWAGE SYSTEM. THE COUNTY HEALTH OFFICER SHALL HAVE THE AUTHORITY TO GRANT VARIANCES FOR ENCROACHMENTS IN THE PRIVATE SEWAGE EASEMENT. RECREATION OF A MODIFIED SEWAGE EASEMENT PLAT SHALL NOT BE NECESSARY.
3. THE LOTS SHOWN HEREON COMPLY WITH THE MINIMUM OWNERSHIP & LOT AREA AS REQUIRED BY THE MO. STATE DEPT. OF THE ENVIRONMENT.
4. PCL. DESIGNATES BUILDING RESTRICTION LINE

- ✖ DESIGNATES PROPOSED HOUSING
 - DESIGNATES SUCCESSFUL PERC TEST
 - DESIGNATES FAILED PERC TEST
 - ▲ DESIGNATE, EXISTING, WELL
 - ▲ DESIGNATES PROPOSED WELL
 - DESIGNATES EXISTING SETBACK SYSTEM CLEANOUT
5. ELEVATIONS SHOWN HEREON ARE FIELD READING BASED ON HOWARD COUNTY CONTROL STATE # 27-35004 AND DO NOT NEED TO AGREE WITH HOWARD COUNTY 2"00 SCALE AERIAL PHOTOGRAMMETRY.
6. ALL VISIBLE WELLS & OPTIC SYSTEMS WITHIN 100 FEET OF PROPERTY HAVE BEEN SHOWN HEREON.

APPROVED: FOR PRIVATE WATER &
PRIVATE SEWAGE
SYSTEMS.

Joseph B. Lick 11-2F-91
COUNTY HEALTH OFFICER DATE

G. SCOTT SHANABERGER
 PROF. LAND SURVEYOR #10849

SHANABERGER LANE

8726 TOWN & COUNTRY BLVD.
SUITE 104
ELLIOTT CITY, MO 21043
(410) 461-9563

FIELD LOCATED PERC TEST PLAT
 (E) Revised 2-9 Parcel, Mary Ann Meeks Property

- ② REVISED 3RD PARCEL, MARY ANN NORRIS PROPERTY
- ③ REVISED 2ND REMAINDER OF 3RD PARCEL, SARAH G. WAINWRIGHT ESTATE
- ④ REVISED 2ND REMAINDER OF 2ND PARCEL, SARAH G. WAINWRIGHT ESTATE
- ⑤ REVISED 1ST PARCEL, SARAH G. WAINWRIGHT ESTATE
- ⑥ REVISED 1ST REMAINDER OF 2ND PARCEL, SARAH G. WAINWRIGHT

Under 13091 Wainwright