

LAYOUT 7/18/08 INSP 4 _____
INSP 2 7/21/08 INSP 5 _____
INSP 3 _____ INSP 6 _____

ISSUE DATE: 7/10/08

APPROVAL DATE: 7/22/08

PERMIT

Used in

P 529481

A 528485

TAX ID # **05347483**

ON-SITE SEWAGE DISPOSAL SYSTEM HOWARD COUNTY HEALTH DEPARTMENT BUREAU OF ENVIRONMENTAL HEALTH

Fogles Septic Clean IS PERMITTED TO INSTALL ☒ ALTER ☐

ADDRESS: 580 Obrecht Road, Sykesville PHONE NUMBER: 410-795-5670

SUBDIVISION: _____ LOT NUMBER: _____

ADDRESS: 13080 Wainwright Rd PROPERTY OWNER: Henry Wainwright

SEPTIC TANK CAPACITY (GALLONS): 2000 OUTLET BAFFLE FILTER REQUIRED ☐

PUMP CHAMBER CAPACITY (GALLONS): _____ COMPARTMENTED TANK REQUIRED ☒

NUMBER OF BEDROOMS: 4

SQUARE FEET PER BEDROOM: _____

LINEAR FEET OF TRENCH REQUIRED: 214

Application Rate 0.8

| | |
|-----------|---|
| TRENCHES: | Trench to be 2.0 feet wide. Inlet 4.0 feet below original grade. Bottom maximum depth 8.0 feet below original grade. Effective area begins at 6.0 feet below original grade. 4.0 feet of stone below distribution pipe. |
| LOCATION: | |
| NOTES: | Layout inspection required prior to installation. Install system per plan unless otherwise noted by HCHD. Cleanout required every 70' from house to tank. |

PLANS APPROVED: Heidi Scott DATE: 4/29/08

- NOTE: PERMIT VOID AFTER 2 YEARS
- NOTE: CONTRACTOR RESPONSIBLE FOR SCHEDULING A PRE-CONSTRUCTION INSPECTION FOR ALL INSTALLATIONS
- NOTE: WATERTIGHT SEPTIC TANKS REQUIRED
- NOTE: ALL PARTS OF SEPTIC SYSTEM SHALL BE 100 FEET FROM ANY WATER WELL
- NOTE: MANHOLE RISERS REQUIRED ON ALL SEPTIC TANKS AND PUMP CHAMBERS UNLESS SPECIFICALLY AUTHORIZED

**NEITHER THE HOWARD COUNTY COUNCIL NOR THE HEALTH DEPARTMENT IS
RESPONSIBLE FOR THE SUCCESSFUL OPERATION OF ANY SYSTEM
PERMITTEE RESPONSIBLE FOR OBTAINING FINAL APPROVAL ON THIS PERMIT
CALL 410-313-1771 FOR INSPECTION OF SEPTIC SYSTEM**

NOT TO SCALE

184963

** See Separate Sheet
for As-Built*

ROAD

TRENCH/DRAINFIELD DATA
WIDTH 2' INLET 4' BOTTOM 8'
NUMBER OF TRENCHES 3
TOTAL LENGTH 240'
ABSORPTION AREA _____
DISTRIBUTION BOX LEVEL finish
DISTRIBUTION BOX BAFFLE Yes
DISTRIBUTION BOX PORT Yes

SEPTIC TANK DATA
SEPTIC TANK 1 LEVEL Yes
CAPACITY 2000 GAL
SEAM LOC Top
TANK LID DEPTH 1-2'
BAFFLES Yes
BAFFLE FILTER _____
MANHOLE LOC Front/Rear
6" PORT LOC _____
WATERTIGHT TEST _____
~~CAPACITY _____ GAL~~
~~SEAM LOC _____~~
~~TANK LID DEPTH _____~~
~~BAFFLES _____~~
~~BAFFLE FILTER _____~~
~~MANHOLE LOC _____~~
~~6" PORT LOC _____~~
~~WATERTIGHT TEST _____~~

PRE-CONSTRUCTION 7/18/08 Install 3 x 71' trenches on contour w/
D box @ top center of easement.

INSTALLATION 7/21/08 Plumbing from house to S.T. installed
Tank and D box sets. No trenches dug.
7/22/08 system complete. All trenches installed per
spec. (xw)

FINAL INSPECTOR

K. Wall

DATE OF APPROVAL

7/22/08

~~NO-95-1598~~

88

13080.

080.
Whinnwright Rd

NOT TO SCALE

240

1
225

165

30

8

✓ 4/0

1

7

2

9

10

1

↑
N
↓


GENERAL NOTES:

- 1) THIS LOCATION DRAWING IS PREPARED FOR THE BENEFIT OF THE CLIENT SIGNING THE HOUSE LOCATION SURVEY APPROVAL FORM INsofar AS IT IS REQUIRED BY A LENDER OR TITLE INSURANCE COMPANY OR ITS AGENTS IN CONNECTION WITH THE CONTEMPLATED TRANSFER, FINANCING OR REFINANCING OF THE PROPERTY SHOWN HEREON. UNLESS INDICATED AS BEING A BOUNDARY SURVEY, THIS LOCATION DRAWING IS NOT INTENDED FOR USE IN THE ESTABLISHMENT OF PROPERTY LINES AND IS NOT TO BE RELIED UPON FOR THE ESTABLISHMENT OR LOCATIONS OF FENCES, GARAGES, BUILDINGS OR OTHER EXISTING OR FUTURE IMPROVEMENTS. AS A RESULT, THIS LOCATION DRAWING DOES NOT PROVIDE FOR ACCURATE IDENTIFICATION OF PROPERTY LINES, BUT SUCH IDENTIFICATION MAY NOT BE REQUIRED FOR THE TRANSFER OF TITLE OR SECURING FINANCING FOR RE-FINANCING.
- 2) SUBJECT PROPERTY IS SHOWN IN ZONE C ON THE NATIONAL FLOOD INSURANCE PROGRAM FLOOD INSURANCE RATE MAP OF HOWARD COUNTY, MARYLAND, COMMUNITY PANEL No. 2400440037B EFFECTIVE DEC. 4, 1986.
- 3) THE OFFSETS FROM BUILDING LINE TO PROPERTY LINE AS SHOWN ON THE PLAT HEREON ARE TO AN ACCURACY OF PLUS OR MINUS 1.0' (±).
- 4) NO TITLE REPORT FURNISHED. SUBJECT TO ALL EASEMENTS, RIGHTS OF WAY AND CONDITIONS OF RECORD.
- 5) THE EXISTING WELL(S) SHOWN ON THIS PLAN (IDENTIFIED WITH THE ATTACHED WELL TAG NUMBER HO-95-1598) HAS BEEN FIELD LOCATED BY FISHER, COLLINS AND CARTER, INC. PROFESSIONAL LAND SURVEYORS AND IS ACCURATELY SHOWN.
- 6) TOGETHER WITH AND SUBJECT TO A 25 FOOT RIGHT-OF-WAY FOR INGRESS, EGRESS AND MAINTENANCE. (SEE DEED LIBER 7026, FOLIO 449).
- 7) TOGETHER WITH TWO 30 FOOT RIGHT-OF-WAYS (SEE DEED LIBER 7026, FOLIO 449).
- 8) BEING ALL OF THE 30 FOOT RIGHT-OF-WAY AS DESCRIBED IN DEED LIBER 302, FOLIO 091 & ALL THE 30 FOOT RIGHT-OF-WAY AS DESCRIBED IN DEED LIBER 439, FOLIO 161.

BASED ON DEED DATUM OF LIBER 7026, FOLIO 449



DETAIL:
1"=20'

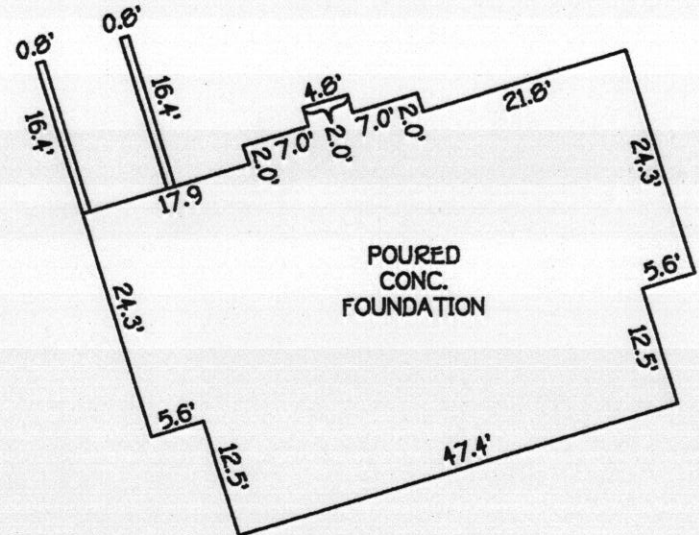

was check ok
7/10/08
S

30' RIGHT-OF-WAY
(439 / 161)



Mark L. Bobel
PROFESSIONAL LAND SURVEYOR
REG. # 339
DATE 6/20/08

FISHER, COLLINS & CARTER, INC.
CIVIL ENGINEERING CONSULTANTS & LAND SURVEYORS
CENTENNIAL SQUARE OFFICE PARK - 10272 BALTIMORE NATIONAL PIKE
ELLCOTT CITY, MARYLAND 21042
(410) 451 - 2895

*13080 WAINWRIGHT ROAD
PROPERTY OF HENRY R. WAINWRIGHT III
5TH ELECTION DISTRICT
HOWARD COUNTY, MARYLAND
B.R.L. = BUILDING RESTRICTION LINE
FIRST FLOOR ELEV. = 465.1'

HOUSE LOCATION DRAWING

FOUNDATION LOCATION: 6/17/08
FINAL LOCATION:
BOUNDARY SURVEY:

SCALE: 1"=100'
DATE: 06/20/08
DRAWN BY: VLJ
CHECKED BY: MLR
PROJECT No.: 08008-6001