

DEPARTMENT OF INSPECTIONS, LICENSES AND PERMITS
3430 COURT HOUSE DRIVE
ELLICOTT CITY, MD 21043
PERMITS (410)313-2455 INSPECTIONS (410)313-1810
AUTOMATED INFORMATION (410) 313-3800

HOWARD COUNTY
PERMIT APPLICATION

PERMIT NUMBER
B00131874

Building Address 12301 WAKE FOREST RD
CLARKSVILLE MD, 21029

Suite/Apt. #: SDP/WP/Petition #: Census Tract Subdivision

Section Area Lot

Tax Map 31 Parcel 179 Grid 12

Zoning 12R Map Coordinates 14E8 Lot size

Property Owner's Name MARK L. WILSON

Address 12301 WAKE FOREST RD.

City CLARKSVILLE State MD Zip Code 21029

Home Phone 410-531-3591 Work Phone 410-977-4274

Applicant's Name & Mailing Address, (if other than stated hereon):

Phone Fax

Existing Use SFD

Proposed Use SFD WITH GARAGE

Estimated Construction Cost \$ 28,200

Description of Work 15700V 2 CAR GARAGE
ATTACHED TO HOUSE WITH MUD ROOM & BATH

Contractor Company OWNER

Contact Person

Address

City State Zip Code

License No. Phone Fax

Occupant or Tenant OWNER

Contact Name

Address

City State Zip Code

Phone Fax

Engineer or Architect Company

Contact Person

Address

City State Zip Code

Phone Fax

BUILDING DESCRIPTION - COMMERCIAL

BUILDING DESCRIPTION - RESIDENTIAL

Building Characteristics

Utilities

Building Characteristics

Utilities

Height:

No. of stories:

Gross area, sq. ft. per floor:

Use group:

Construction type:

Reinforced Concrete

Structural Steel

Masonry

Wood Frame

State Certified Modular

Water Supply:

Public

Private

Sewage Disposal:

Public

Private

Electric Yes No

Gas Yes No

Heating System:

Electric Oil

Natural Gas

Propane Gas

Sprinkler system: N/A

Full

Partial

Other Suppression

of Heads

SF Dwelling Depth Width

1st floor:

2nd floor:

Basement:

Finished Basement Unfinished Basement

Crawl space Slab on Grade

No. of Bedrooms

Multi-family dwellings:

No. of efficiency units:

No. of 1 BR units:

No. of 2 BR units:

No. of 3 BR units:

Other Structure:

Dimensions:

Footings:

Roof:

State Certified Modular

Manufactured Home

Water Supply:

Public

Private

Sewage Disposal:

Public

Private

Electric Yes No

Gas Yes No

Heating System:

Electric Oil

Natural Gas

Propane Gas

Sprinkler system: N/A

NFPA #13D

NFPA #13R

Other:

THE UNDERSIGNED HEREBY CERTIFIES AND AGREES AS FOLLOWS: (1) THAT HE/SHE IS AUTHORIZED TO MAKE THIS APPLICATION; (2) THAT THE INFORMATION IS CORRECT AND COMPLETE; (3) THAT HE/SHE WILL COMPLY WITH ALL REGULATIONS OF HOWARD COUNTY WHICH ARE APPLICABLE THERETO; (4) THAT HE/SHE WILL PERFORM NO WORK ON THE ABOVE REFERENCED PROPERTY NOT SPECIFICALLY DESCRIBED IN THIS APPLICATION; (5) THAT HE/SHE GRANTS COUNTY OFFICIALS THE RIGHT TO ENTER ONTO THIS PROPERTY FOR THE PURPOSE OF INSPECTING THE WORK PERMITTED AND POSTING NOTICES.

Mark L. Wilson

Applicant's Signature

OWNER

Title/Company

MARK WILSON

Print Name

8-8-01

Date

Checks payable to: DIRECTOR OF FINANCE OF HOWARD COUNTY
** PLEASE WRITE NEATLY AND LEGIBLY. **
- FOR OFFICE USE ONLY -

AGENCY DATE SIGNATURE APPROVAL

DPZ SETBACK INFORMATION

PROPERTY ID# 51812

Land Development, DPZ

State Highways

Building Official

Dev. Engineering, DPZ

Health

Fire Protection

Is Sediment Control approval required prior to issuance?

YES NO

CONTINGENCY CONSTRUCTION START

ONE STOP SHOP

Front:

Rear:

Side:

Side St.

All minimum setbacks met?

YES NO

Is Entrance Permit required?

YES NO

Historic District?

YES NO

Lot Coverage for New Town Zone

SDP/Red-line approval date

Accepted by

Filing fee \$ 25

Permit fee \$

Excise tax \$

Add'l per. fee \$

TOTAL FEES \$


Sub-total paid \$

Balance due \$

Check #

Validation # 44064

Property known as: Lot 1 & 8 Block 'C' THIS PLAT CAN NOT BE USED TO ESTABLISH PROPERTY
HERITAGE HEIGHTS SECTION ONE P.B. 4/94 LINES OR CORNERS.
5th ELECTION DIST. HOWARD CO. MD

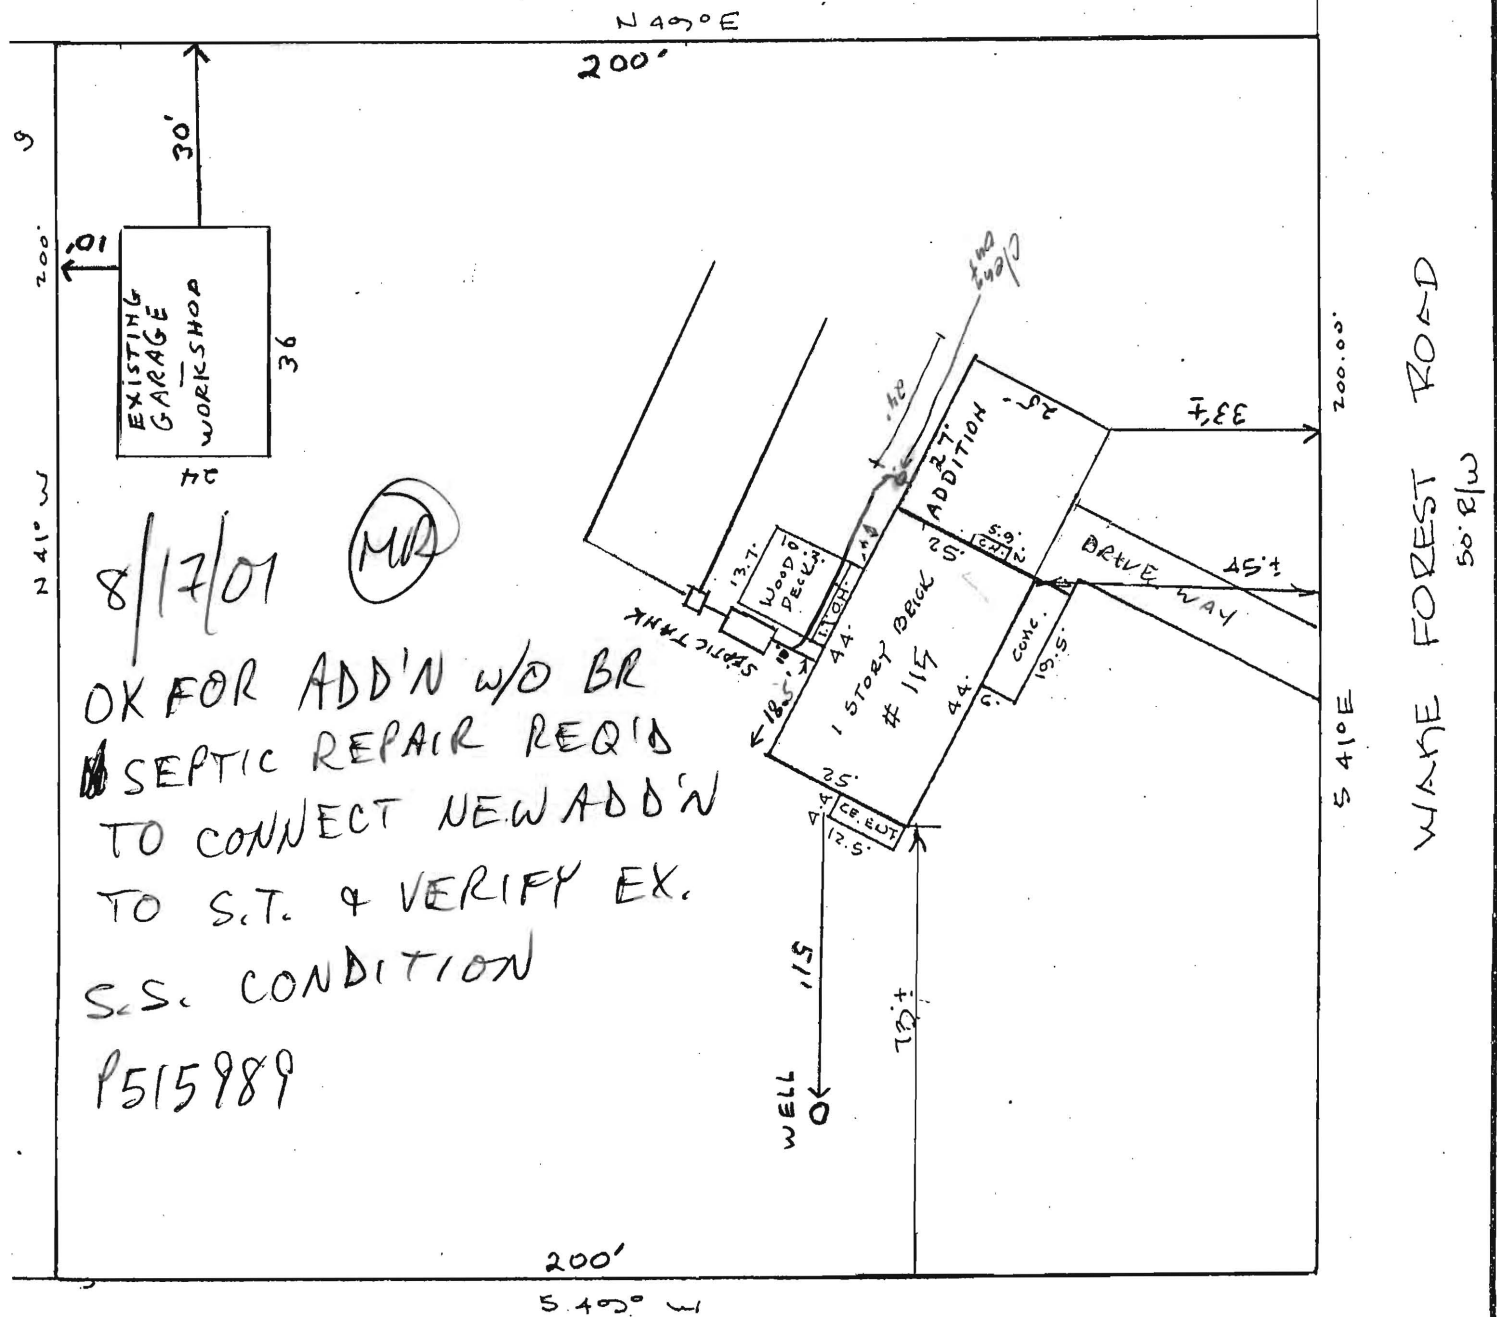

THOMPSON DRIVE
50' R/W

LOCATION SURVEY PLAT

CERTIFICATION

This is to certify that I have surveyed
the property known as:
115 WAKE FOREST ROAD

for the purpose of locating the im-
provements thereon, and the improvements
are located as shown.

SEAL



Walter Park

SCALE 1" = 30'

DATE 2-9-1987

PHONE
828-9060 TOWSON
730-9060 COLUMBIA

HUDKINS ASSOCIATES, INC.
Surveyors and Subdivision Designers

SUITE 231, JOSEPH SQUARE
5485 HARPERS FARM ROAD
WALTER PARK, L.S. COLUMBIA, MARYLAND 21044
5539