


SITE PLAN
13214 HIGHLAND ROAD
CLARKSVILLE (5th) DISTRICT
HOWARD COUNTY, MD
SCALE 1" = 50'

District = 5
MAP = 34
Grid = 21
Parcel = 70
USE = Residential
ZONE = R
AREA = 1.003 ACRES


Poster Location X

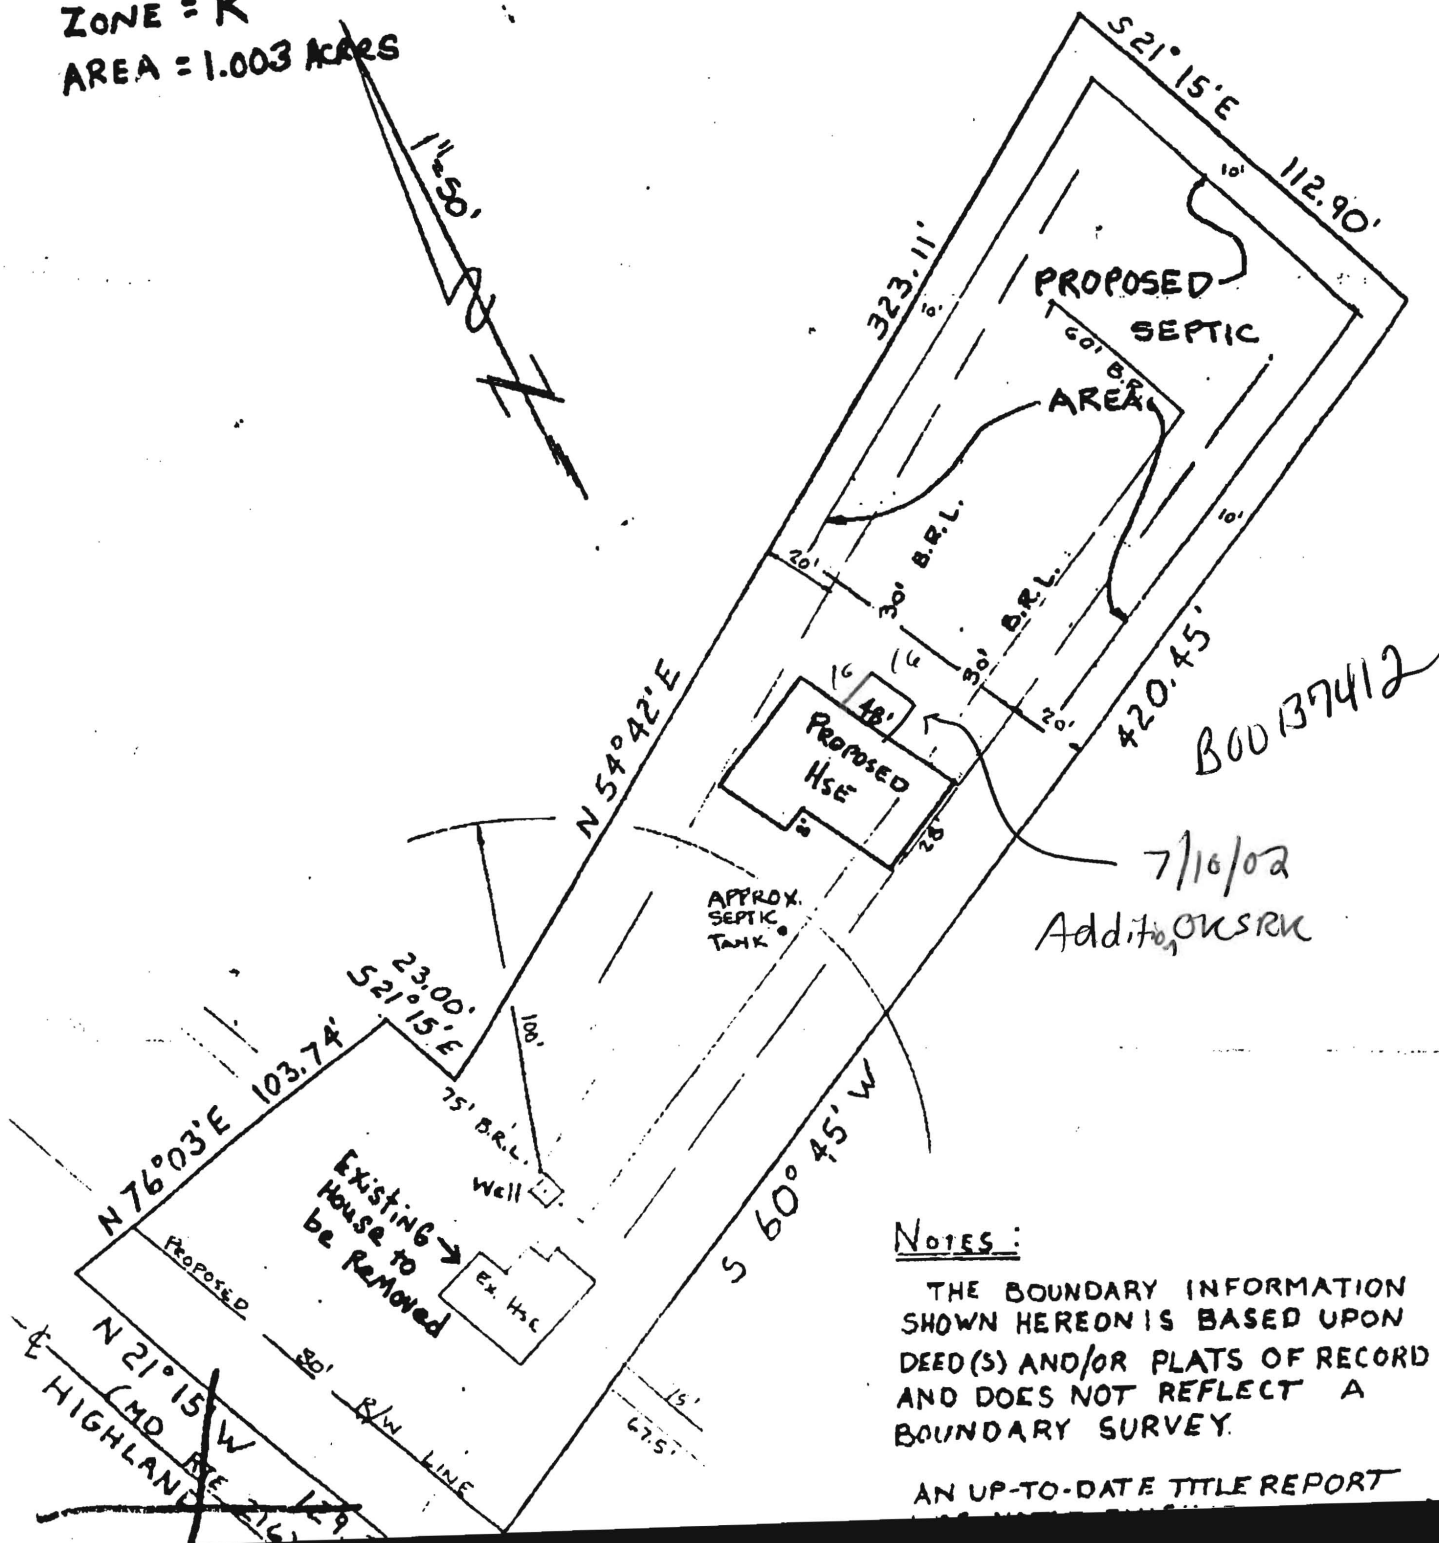


NOTES:

THE BOUNDARY INFORMATION SHOWN HEREON IS BASED UPON DEED(S) AND/OR PLATS OF RECORD AND DOES NOT REFLECT A BOUNDARY SURVEY.

AN UP-TO-DATE TITLE REPORT

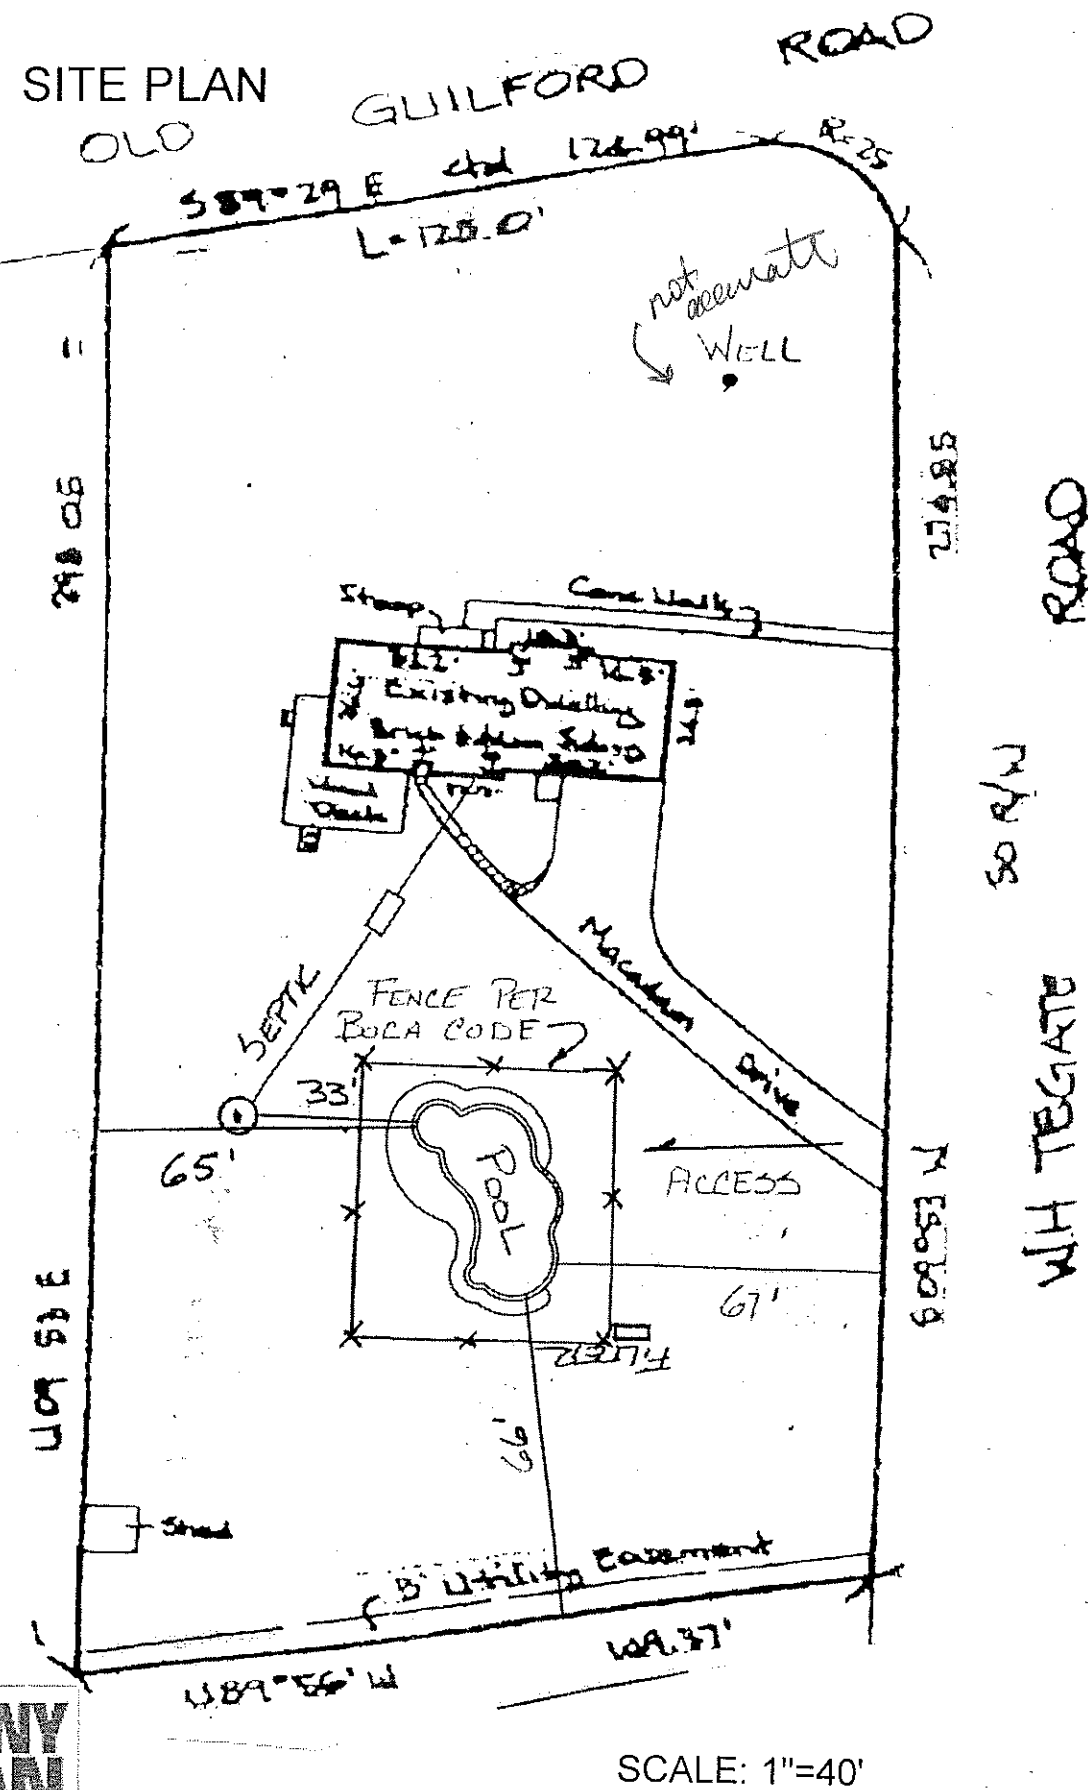

VICINITY MAP

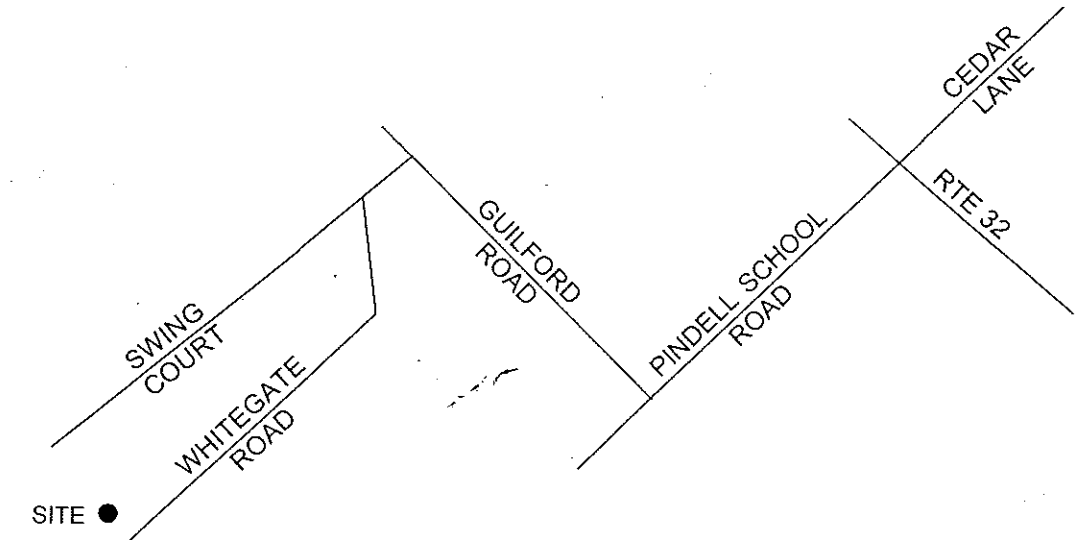

HOWARD COUNTY
MAP PG 14 GRID K-11

DIRECTIONS: FROM LAUREL

RTE 32 TO
(L) CEDAR LANE TO
PINDELL SCHOOL ROAD TO
(R) GUILFORD ROAD TO
(L) WHITEGATE ROAD - SITE ON RIGHT