

05-300001
6/28/01 1:00 7/13/01 1:00
8/15/01 10:00

PERMIT

SEWAGE DISPOSAL SYSTEM
HOWARD COUNTY HEALTH DEPARTMENT
BUREAU OF ENVIRONMENTAL HEALTH
410-313-2640

P 515305 - A

A REPAIR

ISSUE DATE 6-27-2001

APPROVAL DATE 8/15/01

INDEXED

Jack Fyock Septic Service

IS PERMITTED TO INSTALL ALTER X

ADDRESS PO Box 89, Glenelg, MD 21737 PHONE 410-988-9270

SUBDIVISION Clarksville Ridge LOT NUMBER 6 ADDRESS 6600 Whitegate

PROPERTY OWNER Scordato PROPERTY OWNER'S ADDRESS Same

SEPTIC TANK CAPACITY EX. 1000 GALLONS

PUMP CHAMBER CAPACITY GALLONS

NUMBER OF BEDROOMS 3

SQUARE FEET PER BEDROOM 180

LINEAR FEET OF TRENCH REQUIRED

TRENCHES: Trenches to be feet wide. Inlet 3 1/2 - 4 feet below original grade. Bottom maximum depth 5 1/2 - 6 feet below original grade. 2 feet of stone below distribution box.

LOCATION:

REPAIR - PURPOSE - Existing septic system has failed.

Call for inspection when ground is opened so sanitarian can recommend repair. 6-27-01

LEACHING BED 20' x 30' 20' UPHILL OF D/W

PLANS APPROVED DATE

PERMIT VOID AFTER 2 YEARS

NOTE: CONTRACTOR RESPONSIBLE FOR SCHEDULING A PRE-CONSTRUCTION INSPECTION FOR ALL INSTALLATIONS

NOTE: TOP OF SEPTIC TANKS ARE TO BE NO DEEPER THAN 3.0 FEET BELOW FINISH GRADE

NOTE: WATERTIGHT SEPTIC TANKS REQUIRED

NOTE: CLEANOUT REQUIRED EVERY 70 FEET OF SEWER LINE AND/OR AT 90° SWEEPS IN LINES FROM HOUSE TO DRAIN FIELDS, 90° ELBOWS ARE NOT ACCEPTABLE

NOTE: ALL PARTS OF SEPTIC SYSTEMS (I.E. TANK, DISTRIBUTION BOX, DRAINFIELDS) TO BE 100 FEET FROM ANY WATER WELL UNLESS OTHERWISE SPECIFICALLY AUTHORIZED

NOTE: NO ABSORPTION TRENCH TO EXCEED 100 FEET IN LENGTH UNLESS SPECIFICALLY AUTHORIZED

NOTE: ALL PIPE FROM HOUSE TO SEPTIC TANK MUST BE CAST IRON OR SCHEDULE 35/40 PVC OR ABS

NOTE: MANHOLE RISERS REQUIRED ON ALL SEPTIC TANKS AND PUMP CHAMBERS


NOTE: DISTRIBUTION BOXES MUST HAVE BAFFLES

NOTE: IF PUMPED SEPTIC SYSTEM REQUIRED, (1) SEPTIC PUMP DETAIL TO BE PROVIDED BY INSTALLER PRIOR TO ISSUANCE OF SEPTIC PERMIT (2) PUMP PERFORMANCE TEST IS NECESSARY PRIOR TO HEALTH DEPARTMENT APPROVAL OF SEPTIC PERMIT

NEITHER THE HOWARD COUNTY COUNCIL NOR THE HEALTH DEPARTMENT IS RESPONSIBLE FOR THE
SUCCESSFUL OPERATION OF ANY SYSTEM
PERMITTEE RESPONSIBLE FOR OBTAINING FINAL APPROVAL ON THIS PERMIT
CALL 410-313-2640 FOR INSPECTION OF SEPTIC SYSTEM

515305-H

NOT TO SCALE

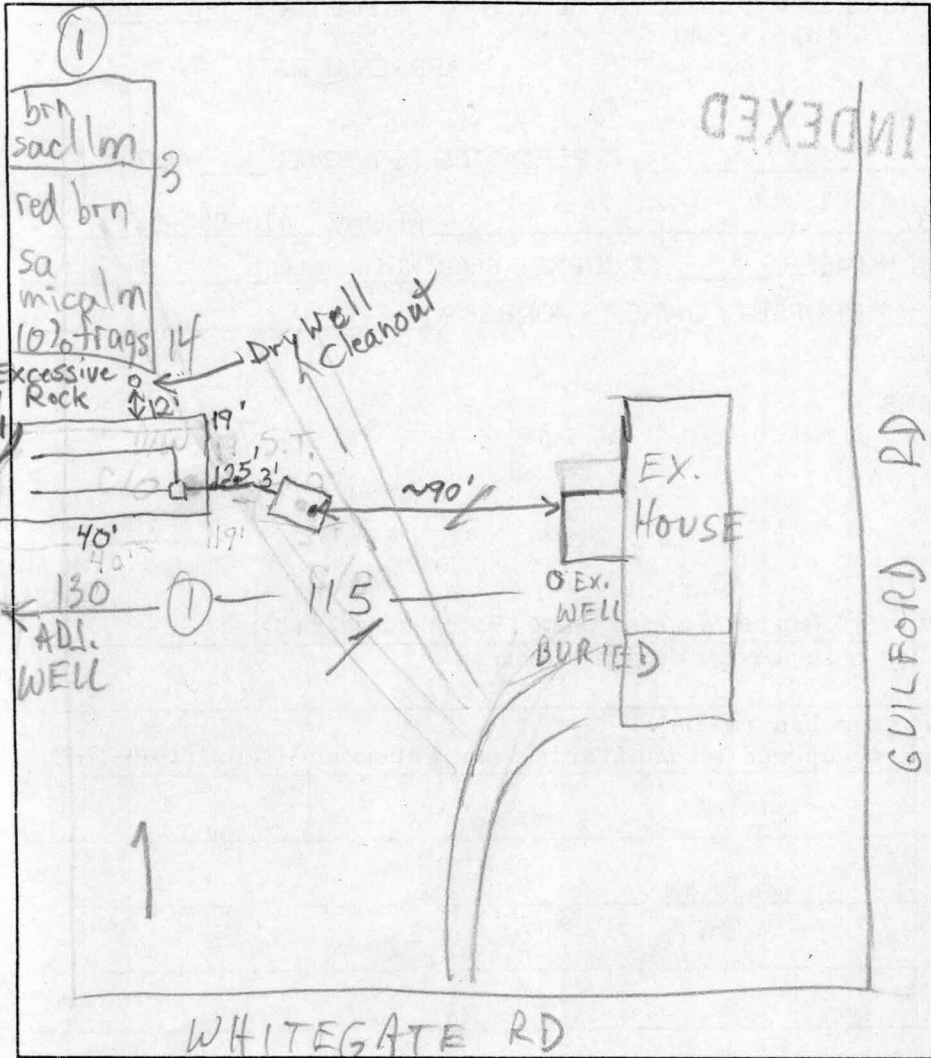

TRENCH DATA

TRENCH WIDTH 18' x 40'
TRENCH INLET DEPTH 3.5'-5.5'
TRENCH BOTTOM DEPTH 5.5'-7.5'
DEPTH OF STONE 2'
NUMBER OF TRENCHES Leaching Bed
TOTAL TRENCH LENGTH N/A
ABSORBENT AREA ~ 720 sq. ft.
DISTRIBUTION BOX LEVEL OK
BAFFLE IN DISTRIBUTION BOX Not Necessary

SEPTIC TANK DATA

SEPTIC TANK Ex. 1000 GALLONS
MANHOLE RISER No
6 INCH INSPECTION PORT Yes

PUMP CHAMBER DATA

PUMP CHAMBER GALLONS N/A
MANHOLE RISER N/A
ALARM N/A
PUMP PERFORMANCE TEST N/A

PRE-CONSTRUCTION INSPECTION: _____

INSPECTION COMMENTS: 8/15/01 Drywell disconnected but left intact for potential future use. Will have to be abandoned if public sewer becomes available. Inlet depth for bed was greater than 4' in areas to be able to use gravity from tank to box. To go to put new 6" cleanout on septic tank. O.K. to cover everything. One corner of bed contained excessive rock and wasn't used. BB

INSPECTOR B. Baker

DATE SYSTEM APPROVED 8/15/01