


SL. 4
2
1510

A 09295

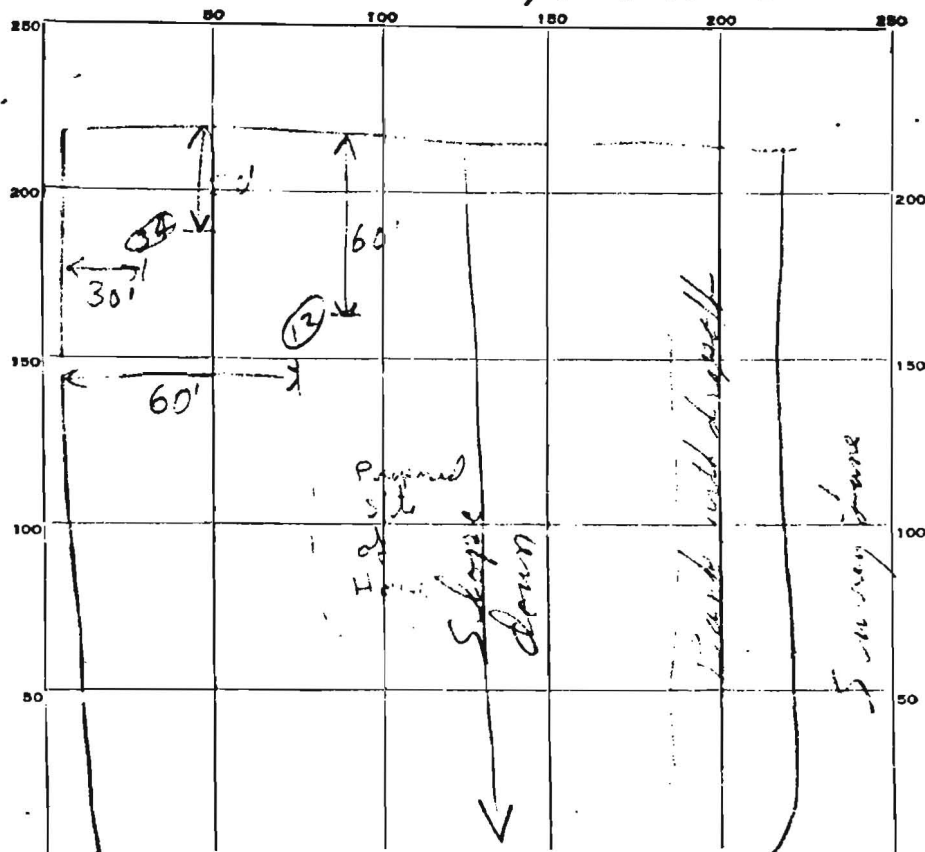

DATE	TEST NO.	DEPTH	PRE-WET		TEST - 1" DROP		TIME
			START	STOP	START	STOP	
1/5/14	1	9 ft	1040 1035	1045	1045	1050	5 min
	2	5 ft	1041	1043	1043	1046	3 min
	3	9 ft	1044	1050	1050	1100	10 min
	4	5 ft	1051	1059	1157	1105	6 min

SOIL AUGER FINDING

TESTED BY

R.D.F. 1/5/14

REMARKS

ALSO PRESENT

LOT NO.