

STATE OF MARYLAND
DEPARTMENT OF WATER RESOURCES
STATE OFFICE BLDG., ANNAPOLIS, MARYLAND 21401
WELL COMPLETION REPORT

THIS REPORT MUST BE SUBMITTED
WITHIN 30 DAYS AFTER COMPLETION
OF THE WELL
FILL IN THIS FORM COMPLETELY

SEQUENCE NO. 8307
DATE WELL COMPLETED June 9 - 70
DEPTH OF WELL 180
PERMIT NO. FROM PERMIT TO DRILL WELL 40-70-0170
DRILLERS IDENTIFICATION NO. 42

CORNER Cadellie Holmes
FIRST NAME A O 9295
STREET OR RFD POST OFFICE Belair Md

WELL LOG
NOTE THE KIND OF FORMATIONS PENETRATED, THEIR
COLOR, DEPTH, THICKNESS AND IF WATER BEARING

DESCRIPTION (USE ADDITIONAL SHEETS IF NECESSARY)	FEET FROM TO	CHECK IF WATER BEARING
Sy hail	0 3	
Sand	3 40	
Sand Rock	40 90	
Gray Rock	90 180	

Casing 49'
Grout 11' by top
Water at 4' - his point
Cement grout in to 20'

GROUTING RECORD
WELL HAS BEEN GROUTED (CIRCLE APPROPRIATE BOX)
YES NO
40 46
DEPTH OF GROUT SEAL (TO NEAREST FOOT)
FROM 0 FT. TO 47 FT.
(ENTER 0 IF FROM SURFACE)

CASING RECORD
CIRCLING TYPES
(INSERT APPROPRIATE CODE BELOW)
STEEL CONCRETE
PLASTIC OTHER
MAIN CASING TYPE
NOMINAL DIAMETER OF MAIN CASING (NEAREST INCH) 6
TOTAL DEPTH OF MAIN CASING (NEAREST FOOT) 49

OTHER CASING (IF USED)
DIAMETER (INCH) DEPTH (FEET)
FROM TO

SCREEN RECORD
SCREEN TYPE
(INSERT APPROPRIATE CODE BELOW)
STEEL BRASS OR BRONZE OPEN HOLE
PLASTIC OTHER
C 2

DEPTH (NEAREST WHOLE FOOT)
FROM TO
EACH CASING
SCREEN

PUMPING TEST
HOURS PUMPED (TO NEAREST HOUR) 1
PUMPING RATE (GALLONS PER MINUTE TO NEAREST GALLON) 6
METHOD USED TO MEASURE PUMPING RATE bucket

WATER LEVEL (DISTANCE FROM LAND SURFACE)
BEFORE PUMPING 30 (NEAREST FOOT)
WHEN PUMPING 180 (NEAREST FOOT)


TYPE OF PUMP USED (CIRCLE APPROPRIATE BOX)
A AIR D PISTON T TURBINE
C CENTRIFUGAL R ROTARY O OTHER (DESCRIBE BELOW)
J JET S SUBMERSIBLE

PUMP INSTALLED
TYPE OF PUMP (WRITE APPROPRIATE LETTER IN BOX - SEE ABOVE: A, C, J, P, R, S, T, O)
29

CAPACITY:
GALLONS PER MINUTE TO NEAREST GALLON 31 36
PUMP HORSE POWER 37 41
PUMP COLUMN LENGTH (NEAREST FOOT) 43 47

CASING HEIGHT (CIRCLE APPROPRIATE BOX AND ENTER CASING HEIGHT)
ABOVE BELOW
LAND SURFACE 2 (NEAREST FOOT)

LOCATION OF WELL ON LOT
SHOW PERMANENT STRUCTURAL SUCH AS BUILDINGS, SEPTIC TANKS, AND/OR OTHER LAND MARKS AND INDICATE NOT LESS THAN TWO DISTANCES (MEASUREMENTS TO WELL).

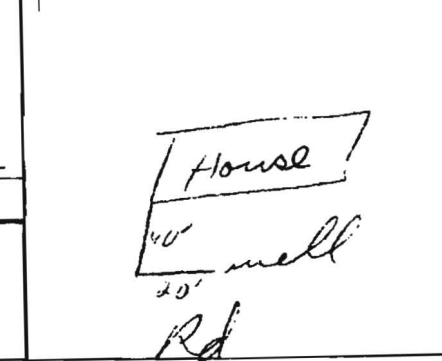

CIRCLE APPROPRIATE BOXES
A A WELL WAS ABANDONED AND SEALED WHEN THIS WELL WAS COMPLETED
E ELECTRIC LOG OBTAINED
C COPY OF ELECTRIC LOG ATTACHED
I HEREBY CERTIFY THAT I HAVE COMPLIED WITH ALL CONDITIONS STATED ON THE ABOVE-CAPTIONED "PERMIT TO DRILL WELL", AND THAT INFORMATION CONTAINED IN THIS REPORT IS TRUE, ACCURATE, AND COMPLETE TO THE BEST OF MY KNOWLEDGE, INFORMATION AND BELIEF.
DRILLERS NAME
SIGNATURE L. J. Es. Tontoy

SLOT SIZE 1. 2. 3. 4.
IF WELL DRILLED WAS A FLOWING WELL CIRCLE BOX 68 F
CAR USE ONLY (DO NOT BE FILLED IN BY DRILLER)
TELESCOPE CASING INDICATOR
N 9 OTHER DATA AVAILABLE
74 75 76

B 1 9316 (THIS NUMBER IS TO BE PUNCHED IN COLUMNS 3-6 ON ALL CARDS)		STATE OF MARYLAND DEPARTMENT OF WATER RESOURCES STATE OFFICE BLDG., ANNAPOLIS, MARYLAND 21401 APPLICATION FOR PERMIT TO DRILL WELL			APPLICATION MUST BE SUBMITTED AND PERMIT RECEIVED BEFORE DRILLING IS STARTED. FILL IN THIS FORM COMPLETELY	
DATE RECEIVED (DWR USE ONLY) A09295		OWNER: <u>Charles H. ...</u> COL 15 LAST NAME FIRST NAME COL 34 STREET OR RFD: <u>1114 A St</u> COL 36 COL 35 POST OFFICE: <u>...</u> COL 37 COL 80 HIO-70-0170				
B 2 DRILLER INFORMATION 1 2 3 (SEQ. NO.) 6 <u>...</u> FIRST NAME DRILLER LAST NAME 27 <u>...</u> STREET OR RFD: <u>...</u> POST OFFICE: <u>...</u> DATE OF APPLICATION: <u>May 15-70</u>		B 4 LOCATION OF WELL 1 2 3 (SEQ. NO.) 6 COUNTY: <u>...</u> SUBDIVISION: <u>...</u> SECTION: <u>3</u> LOT: <u>47</u> NEAREST TOWN: <u>...</u> MILES FROM TOWN (ENTER 0 IF IN TOWN): <u>2</u>				
B 3 WELL INFORMATION 1 2 3 (SEQ. NO.) 6 MAXIMUM PUMPING RATE (GALLONS PER MINUTE): <u>5</u> AVERAGE DAILY QUANTITY NEEDED (GALLONS PER DAY): <u>600</u> USE FOR WATER (CIRCLE APPROPRIATE BOX) ☒ DOMESTIC, HOME (SINGLE OR DOUBLE HOUSEHOLD UNIT ONLY) ☐ FARMING, AGRICULTURE, IRRIGATION ☐ INDUSTRIAL, COMMERCIAL, STATE AND FEDERAL GOVERNMENT ☐ MUNICIPAL WATER SUPPLY ☐ PRIVATE WATER COMPANY ☐ TEST		B 5 DIRECTION FROM TOWN (CIRCLE APPROPRIATE BOX) N NORTH E EAST NE NORTHEAST SE SOUTHEAST S SOUTH W WEST NW NORTHWEST SW SOUTHWEST ON WHICH SIDE OF ROAD (CIRCLE APPROPRIATE BOX): DISTANCE FROM ROAD (ENTER DISTANCE AND CIRCLE APPROPRIATE BOX): <u>1000</u>				
APPROXIMATE DEPTH OF WELL: <u>100</u> FEET METHOD OF DRILLING USED (CIRCLE APPROPRIATE METHOD) BORED (OR AUGERED) JETTED DRIVEN AIR-ROTARY AIR-PERCUSSION ROTARY (HYDRAULIC ROTARY) CABLE REVERSE ROTARY OTHER (DESCRIBE):		DRAW A SKETCH BELOW SHOWING LOCATION OF WELL IN RELATION TO NEARBY TOWNS, ROADS AND STREAMS WITH NORTH IN THE DIRECTION OF THE ARROW, AND GIVE DISTANCE FROM WELL TO NEAREST ROAD JUNCTION OR STREAM CROSSING SHOWN ON THE SKETCH. DISTANCE MAY BE APPROXIMATE, BUT MUST BE INDICATED. 				
REPLACEMENT OR DEEPENED WELLS (CIRCLE APPROPRIATE BOX) ☒ THIS WELL WILL NOT REPLACE AN EXISTING WELL ☐ THIS WELL WILL REPLACE A WELL THAT WILL BE ABANDONED AND SEALED ☐ THIS WELL WILL REPLACE A WELL THAT WILL BE USED AS A STANDBY ☐ THIS WELL WILL DEEPEN AN EXISTING WELL TO PERMIT NUMBER OF WELL TO BE REPLACED OR DEEPENED (IF AVAILABLE)						
NOT TO BE FILLED IN BY DRILLER (DWR USE ONLY) APPROPRIATION PERMIT NUMBER: <u>...</u> ENGINEER REVIEW (WRITE DISTRICT NO. IN BOX): <u>...</u> FORCE: <u>...</u> CONDITIONS: <u>...</u>						
B 5 CONTINUED STATE DEPARTMENT OF HEALTH MO. DAY YR. <u>5 18 70</u> APPROVED BY: <u>Howard</u> TITLE: <u>Director, Environmental Health</u>		HEALTH DEPARTMENT APPROVAL (NOT TO BE FILLED IN BY DRILLER) COUNTY DEPT. OF HEALTH: <u>Howard</u> LATITUDE: <u>39</u> DEG. <u>0</u> MIN. <u>0</u> SEC. LONGITUDE: <u>0</u> 7 57 58 59 60 61 62 63 ELEVATION AT WELL HEAD (FEET): <u>...</u>				

B 1		0416		STATE OF MARYLAND DEPARTMENT OF WATER RESOURCES STATE OFFICE BLDG., ANNAPOLIS, MARYLAND 21401 APPLICATION FOR PERMIT TO DRILL WELL		70-2484 APPLICATION MUST BE SUBMITTED AND PERMIT RECEIVED BEFORE DRILLING IS STARTED. FILL IN THIS FORM COMPLETELY	
DATE RECEIVED (DWR USE ONLY)		OWNER: <u>Tolson</u> COL 15 LAST NAME		FIRST NAME: <u>William E.</u> COL 34		COL 36	
STREET OR RFD: <u>Clarksville, Maryland</u>		POST OFFICE: <u>Clarksville, Maryland</u>		COL 55		COL 60	
B 2		DRILLER INFORMATION		B 4		LOCATION OF WELL	
1 2 3 (SEQ. NO.) 6		1 2 3 (SEQ. NO.) 6		1 2 3 (SEQ. NO.) 6		1 2 3 (SEQ. NO.) 6	
FIRST NAME: <u>Dewey</u> COL 8		LAST NAME: <u>Brown</u> COL 21		COUNTY: <u>Howard</u> COL 21		SUBDIVISION: <u>Clarksville Bridge</u> COL 42	
DRILLER NUMBER: <u>163</u> COL 29		STREET OR RFD: <u>Route 3</u> COL 53		SECTION: <u>3</u> COL 44		LOT: <u>47</u> COL 50	
POST OFFICE: <u>Mt Airy, Maryland</u> COL 55		ZIP CODE: <u>21770</u> COL 60		NEAREST TOWN: <u>Clarksville</u> COL 71		MILES FROM TOWN (ENTER 0 IF IN TOWN): <u>2 1/2</u> COL 73	
DATE OF APPLICATION: <u>April 28, 1970</u>		B 3		B 5		DIRECTION FROM TOWN (CIRCLE APPROPRIATE BOX)	
WELL INFORMATION		MAXIMUM PUMPING RATE (GALLONS PER MINUTE): <u>4</u> COL 12		AVERAGE DAILY QUANTITY NEEDED (GALLONS PER DAY): <u>1,000</u> COL 20		N NORTH E EAST NE NORTHEAST SE SOUTHEAST	
USE FOR WATER (CIRCLE APPROPRIATE BOX)		F FARMING, AGRICULTURE, IRRIGATION		I INDUSTRIAL, COMMERCIAL, STATE AND FEDERAL GOVERNMENT		M MUNICIPAL WATER SUPPLY	
P PRIVATE WATER COMPANY		T TEST		S SOUTH W WEST NW NORTHWEST SW SOUTHWEST		NEAR WHAT ROAD: <u>Whitegate Road</u>	
APPROXIMATE DEPTH OF WELL: <u>75</u> FEET		METHOD OF DRILLING USED (CIRCLE APPROPRIATE METHOD)		BORED (OR AUGERED) JETTED DRIVEN		ON WHICH SIDE OF ROAD (CIRCLE APPROPRIATE BOX): <u>S</u>	
30-37 AIR-ROTARY AIR-PERCUSSION ROTARY (HYDRAULIC ROTARY) REVERSE ROTARY		OTHER (DESCRIBE):		DISTANCE FROM ROAD (ENTER DISTANCE AND CIRCLE APPROPRIATE BOX): <u>75</u>		DRAW A SKETCH BELOW SHOWING LOCATION OF WELL IN RELATION TO NEARBY TOWNS, ROADS AND STREAMS WITH NORTH IN THE DIRECTION OF THE ARROW, AND GIVE DISTANCE FROM WELL TO NEAREST ROAD JUNCTION OR STREAM CROSSING SHOWN ON THE SKETCH. DISTANCE MAY BE APPROXIMATE, BUT MUST BE INDICATED.	
REPLACEMENT OR DEEPEINED WELLS (CIRCLE APPROPRIATE BOX)		THIS WELL WILL NOT REPLACE AN EXISTING WELL		THIS WELL WILL REPLACE A WELL THAT WILL BE ABANDONED AND SEALED		THIS WELL WILL REPLACE A WELL THAT WILL BE USED AS A STANDBY	
THIS WELL WILL DEEPEN AN EXISTING WELL		PERMIT NUMBER OF WELL TO BE REPLACED OR DEEPEINED (IF AVAILABLE):		NOT TO BE FILLED IN BY DRILLER (DWR USE ONLY)		HEALTH DEPARTMENT APPROVAL (NOT TO BE FILLED IN BY DRILLER)	
APPROPRIATION PERMIT NUMBER: <u>04</u>		ENGINEER REVIEW (WRITE DISTRICT NO. IN BOX): <u>05</u>		FORCE: <u>07</u>		LATITUDE: <u>39 09 100</u>	
CONDITIONS: <u>70 71 72 73 74 75 76 77 78 79</u>		WRITE INITIALS IN BOX: <u>06 08</u>		COUNTY DEPT. OF HEALTH: <u>Howard</u>		LONGITUDE: <u>07 66 40</u>	
B 5 CONTINUED		STATE DEPARTMENT OF HEALTH (CIRCLE BOX IF STATE HEALTH)		APPROVED BY: <u>Howard</u>		TITLE: <u>Director</u>	
DATE: <u>43 5 3 70</u>		SPECIAL CONDITIONS 8-63 (DWR USE ONLY)		ELEVATION AT WELL HEAD (FEET): <u>60 25 50</u>		B 6	
B 6		SPECIAL CONDITIONS 8-63 (DWR USE ONLY)		B 7		B 8	