

APPLICATION

PERCOLATION TESTING

A 50905 I

P _____

HOWARD COUNTY HEALTH DEPARTMENT

BUREAU OF ENVIRONMENTAL HEALTH

3525-H ELLICOTT MILLS DRIVE/ELLICOTT CITY, MARYLAND 21043
TELEPHONE: 313-2640

DISTRICT _____

DATE 10/12/95

TO: THE COUNTY HEALTH OFFICER
ELLICOTT CITY, MARYLAND

I HEREBY APPLY FOR THE NECESSARY TEST PRIOR TO APPLICATION FOR PERMIT TO CONSTRUCT (OR RECONSTRUCT) A SEWAGE DISPOSAL SYSTEM.

PROPERTY OWNER MR. TOM SCRIVENER
CONTRACT PURCHASER

ADDRESS 5026 VORSEY HALL DRIVE #204 PHONE 964-5522
ELLICOTT CITY, MD 21042

AGENT OR PROSPECTIVE BUYER DONALD R. KENNER JR. LAND DESIGN & DEVELOPMENT, INC.
DEVELOPER

ADDRESS 10805 HICKORY RIDGE ROAD PHONE 740-2100
COLUMBIA, MD 21045

PROPERTY LOCATION:

SUBDIVISION QUARTERFIELD III LOT NO. 10 8 on P.C.

ROAD AND DESCRIPTION PROPOSED WHITETAIL LANE - THIRD ELECTION DISTRICT,
ADJACENT TO QUARTERFIELD II OFF OF FOLLY QUARTER ROAD

TAX MAP 23 PARCEL # 84

SIZE OF LOT CLUSTER ONE ACRE TYPE BLDG. SINGLE FAMILY DWELLING
(SINGLE FAMILY DWELLING OR COMMERCIAL)

THE SYSTEM INSTALLED UNDER THIS APPLICATION IS ACCEPTABLE ONLY UNTIL PUBLIC FACILITIES BECOME AVAILABLE. I FULLY UNDERSTAND THE

FEE CONNECTED WITH THE FILING OF THIS PERC TEST APPLICATION IS NON-REFUNDABLE UNDER ANY CIRCUMSTANCES. I ALSO AGREE TO

COMPLY WITH ALL M.O.S.H.A. REQUIREMENTS IN TESTING THIS LOT. Robert H. Webster - AGENT - LTD. INC.
(SIGNATURE OF APPLICANT)

APPROVED BY _____ FOR _____ DATE _____

DISAPPROVED BY _____ FOR _____ DATE _____

HOLD PENDING FURTHER TESTS _____

REASONS FOR REJECTION OR HOLDING 12/27/95 PERC OK, HOLD FOR PLAT MR

PERCOLATION TEST PLAT/PRELIMINARY PLAT - TITLE OR I.D. # _____ DATE _____

SITE DEVELOPMENT PLAN/FINAL PLAT - TITLE OR I.D. # _____ DATE _____

THIS IS NOT A PERMIT

A50905 II


COUNTY #

SOIL PROFILE

0' ALL HORIZES

brn
sac
lm

4-5

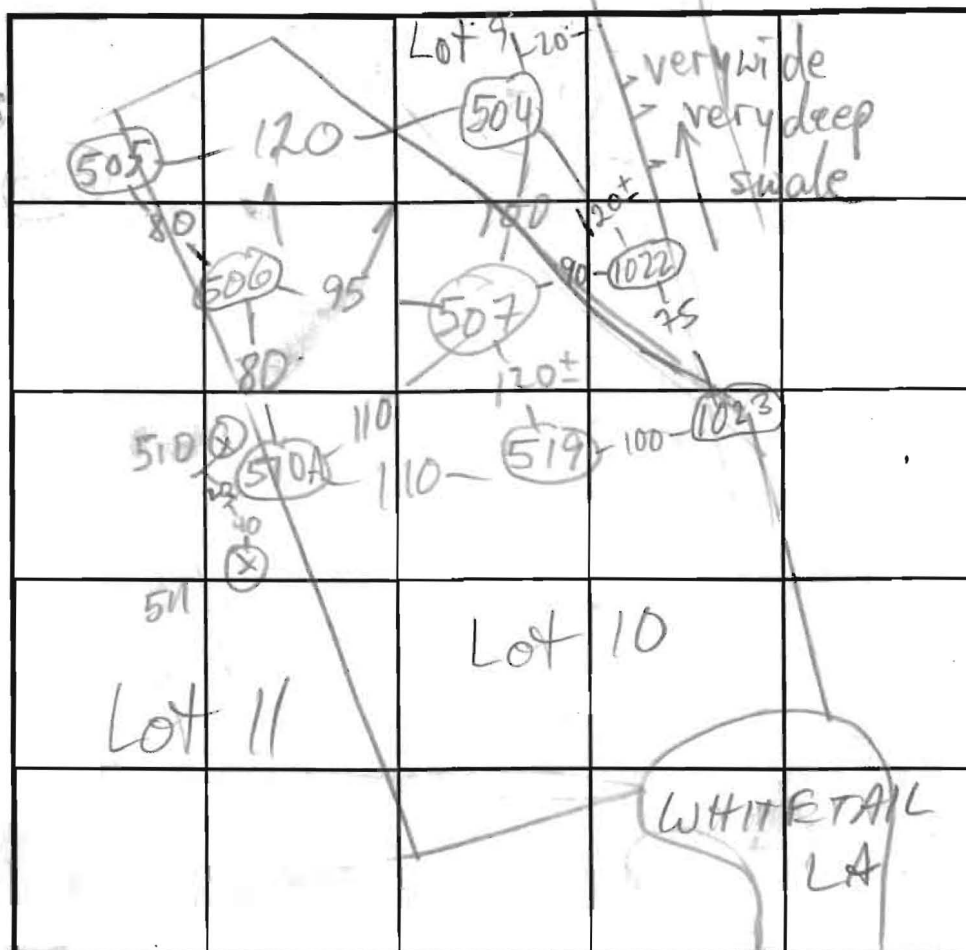beige
gray
tansa lm
10-15%
frag10-
11

SOIL PROFILE

0'

INDICATE NORTH - NAME ADJOINING ROADWAY AS BASE LINE.

DATE	TEST NO.	DEPTH	PRE-WET		TEST - 1" DROP		TIME
			START	STOP	START	STOP	
10/27/95	507s	5'	2:19	2:21	2:21	2:25	4
	507v	10 1/2	OK see profile				
	504s	6	2:28	2:31	2:31	2:36	5
	504v	11	OK see profile				
	505s	4	2:41	2:42	2:42	2:44	2
	505v	10	OK see profile				
	506s	5 1/2	2:46	2:48	2:48	2:51	3
	506v	11	OK see profile				
	510As	4 1/2	2:54	2:56	2:56	3:00	4
	516Av	11	OK see profile				

REMARKS

TYPE OF SOIL

TESTED BY

M. Ripkin

ALSO PRESENT

Assoc. Exec. Dir.

TRENCH DESIGN DATA: AVERAGE PERCOLATION TIME

3 1/2

TRENCH WIDTH

3

INLET DEPTH


4

MAXIMUM BOTTOM DEPTH

6

SQ. FT./BEDROOM

180

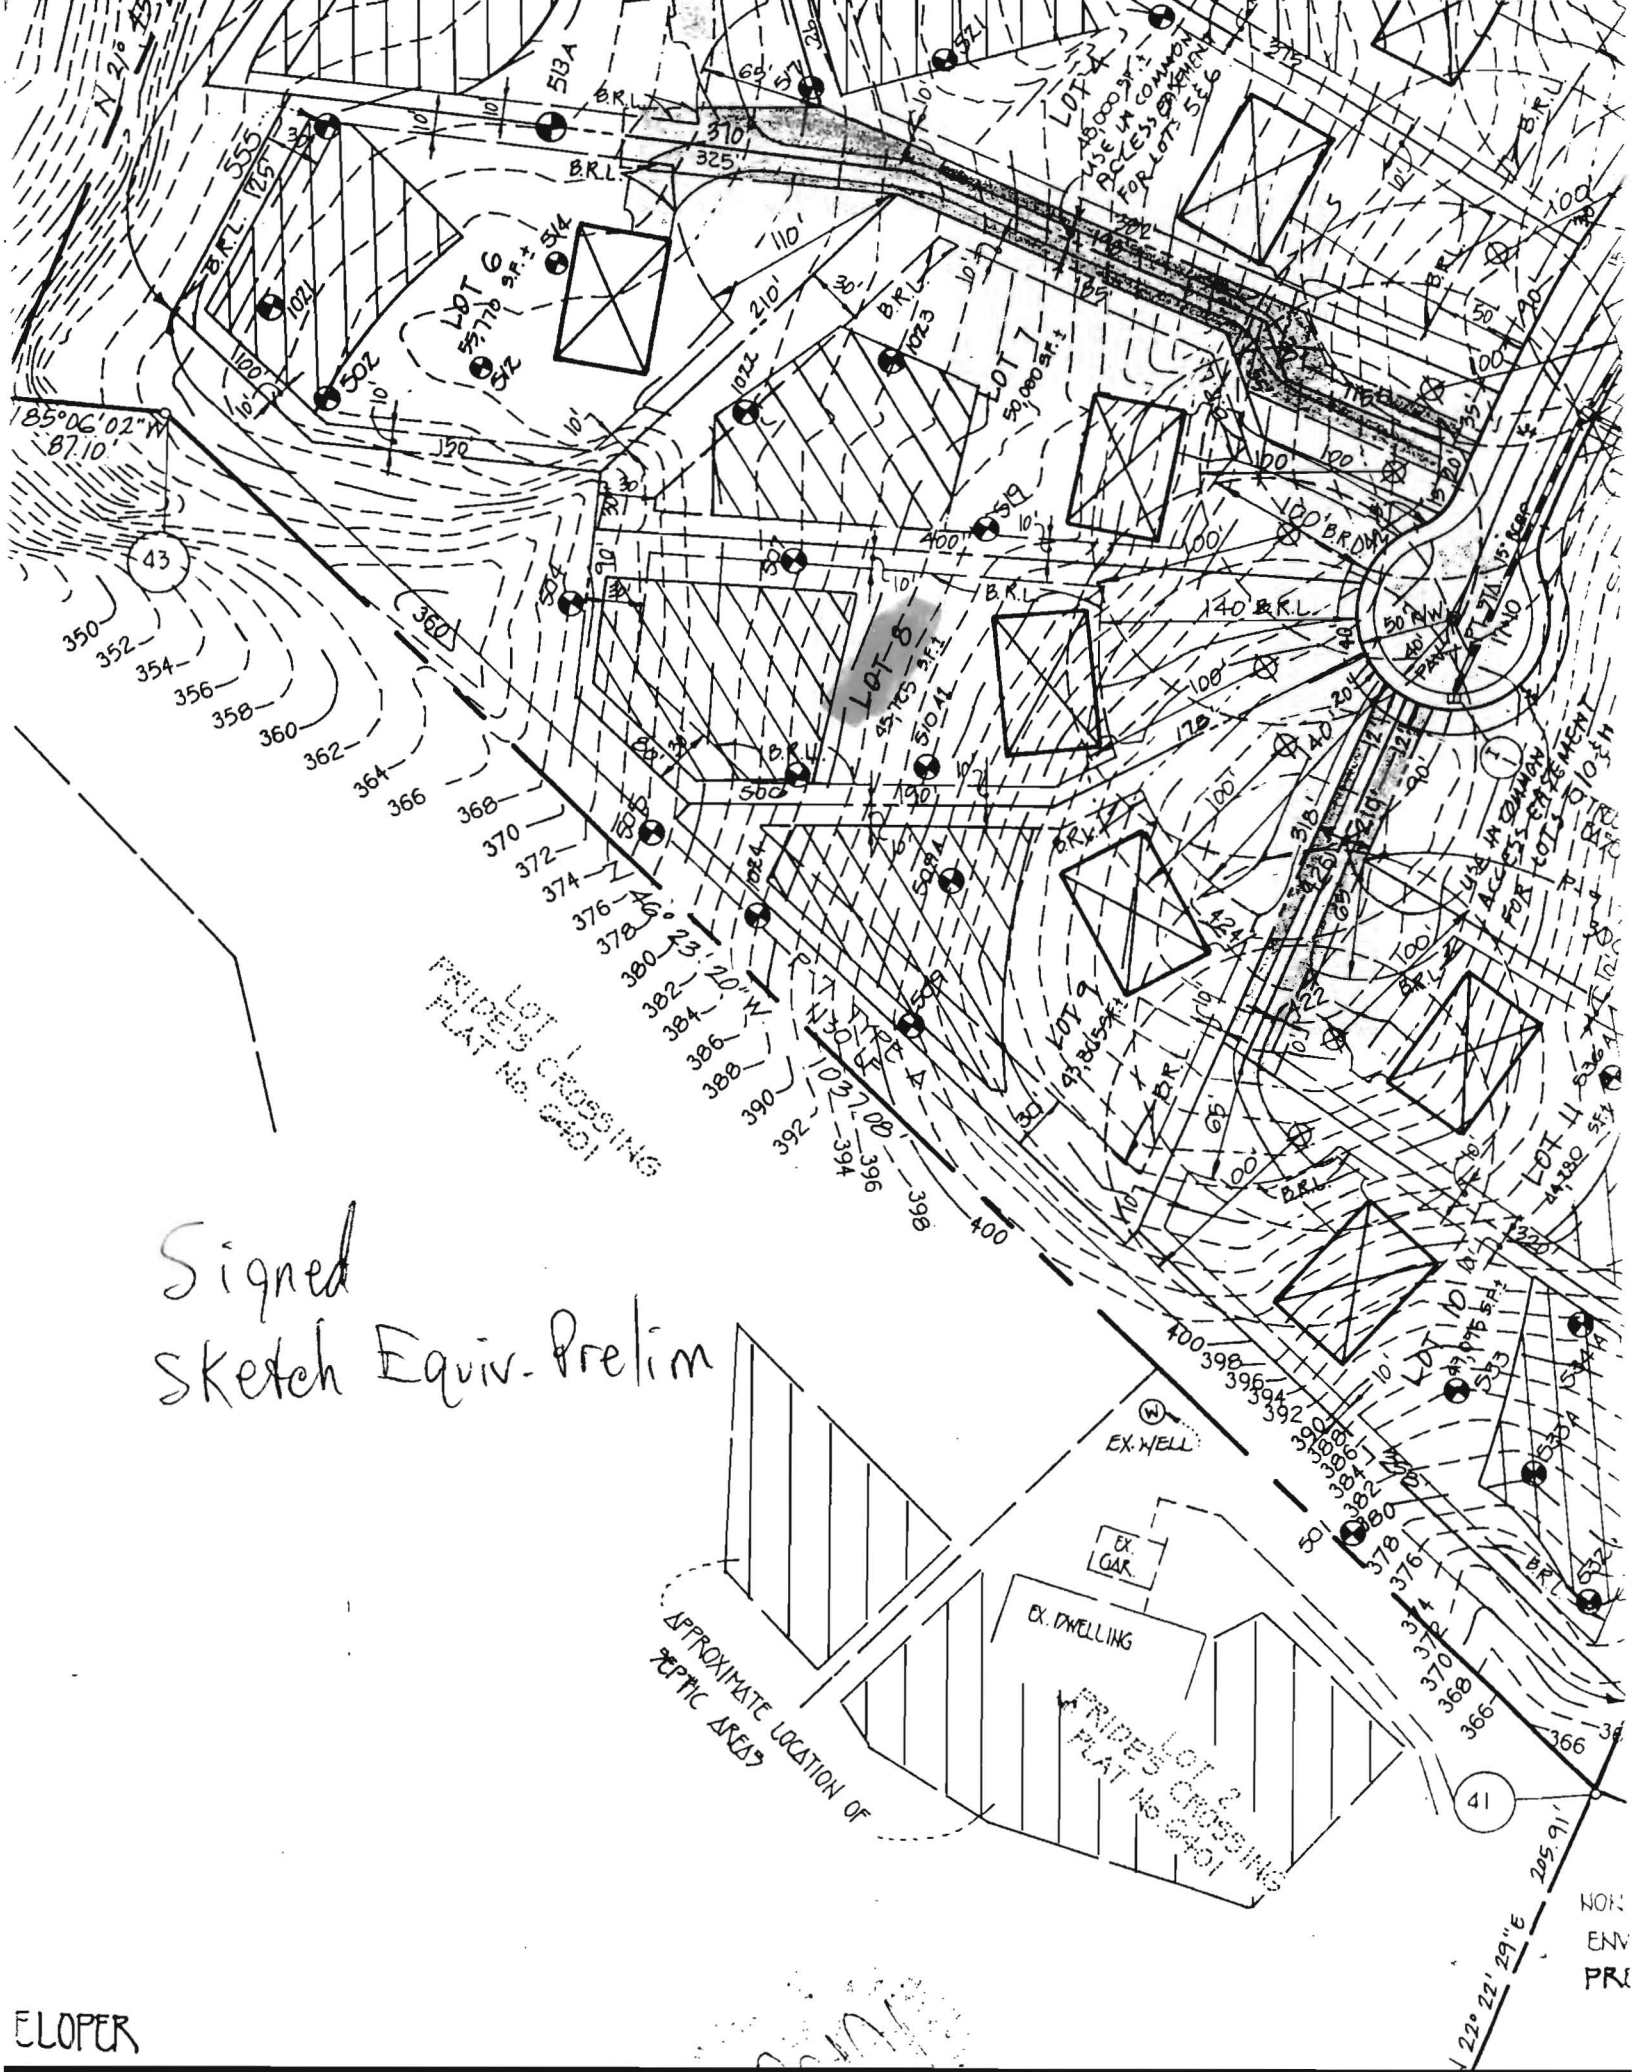

Signed
Sketch Equiv. Prelim

APPROXIMATE LOCATION OF
REPTIC AREA

EX. DWELLING
EX. GAR.
PRIDELOT CROSSING
PLAT No. 6401

41

NON
ENV
PRI

ELOPER

SIGNED
FINAL


PRESERVATION PARCEL 3B PLAT No. 12244

METRIC
407510.41
E 1337000

Non-Preservation
AREA

Forest
Easement
Area

ISSING
401

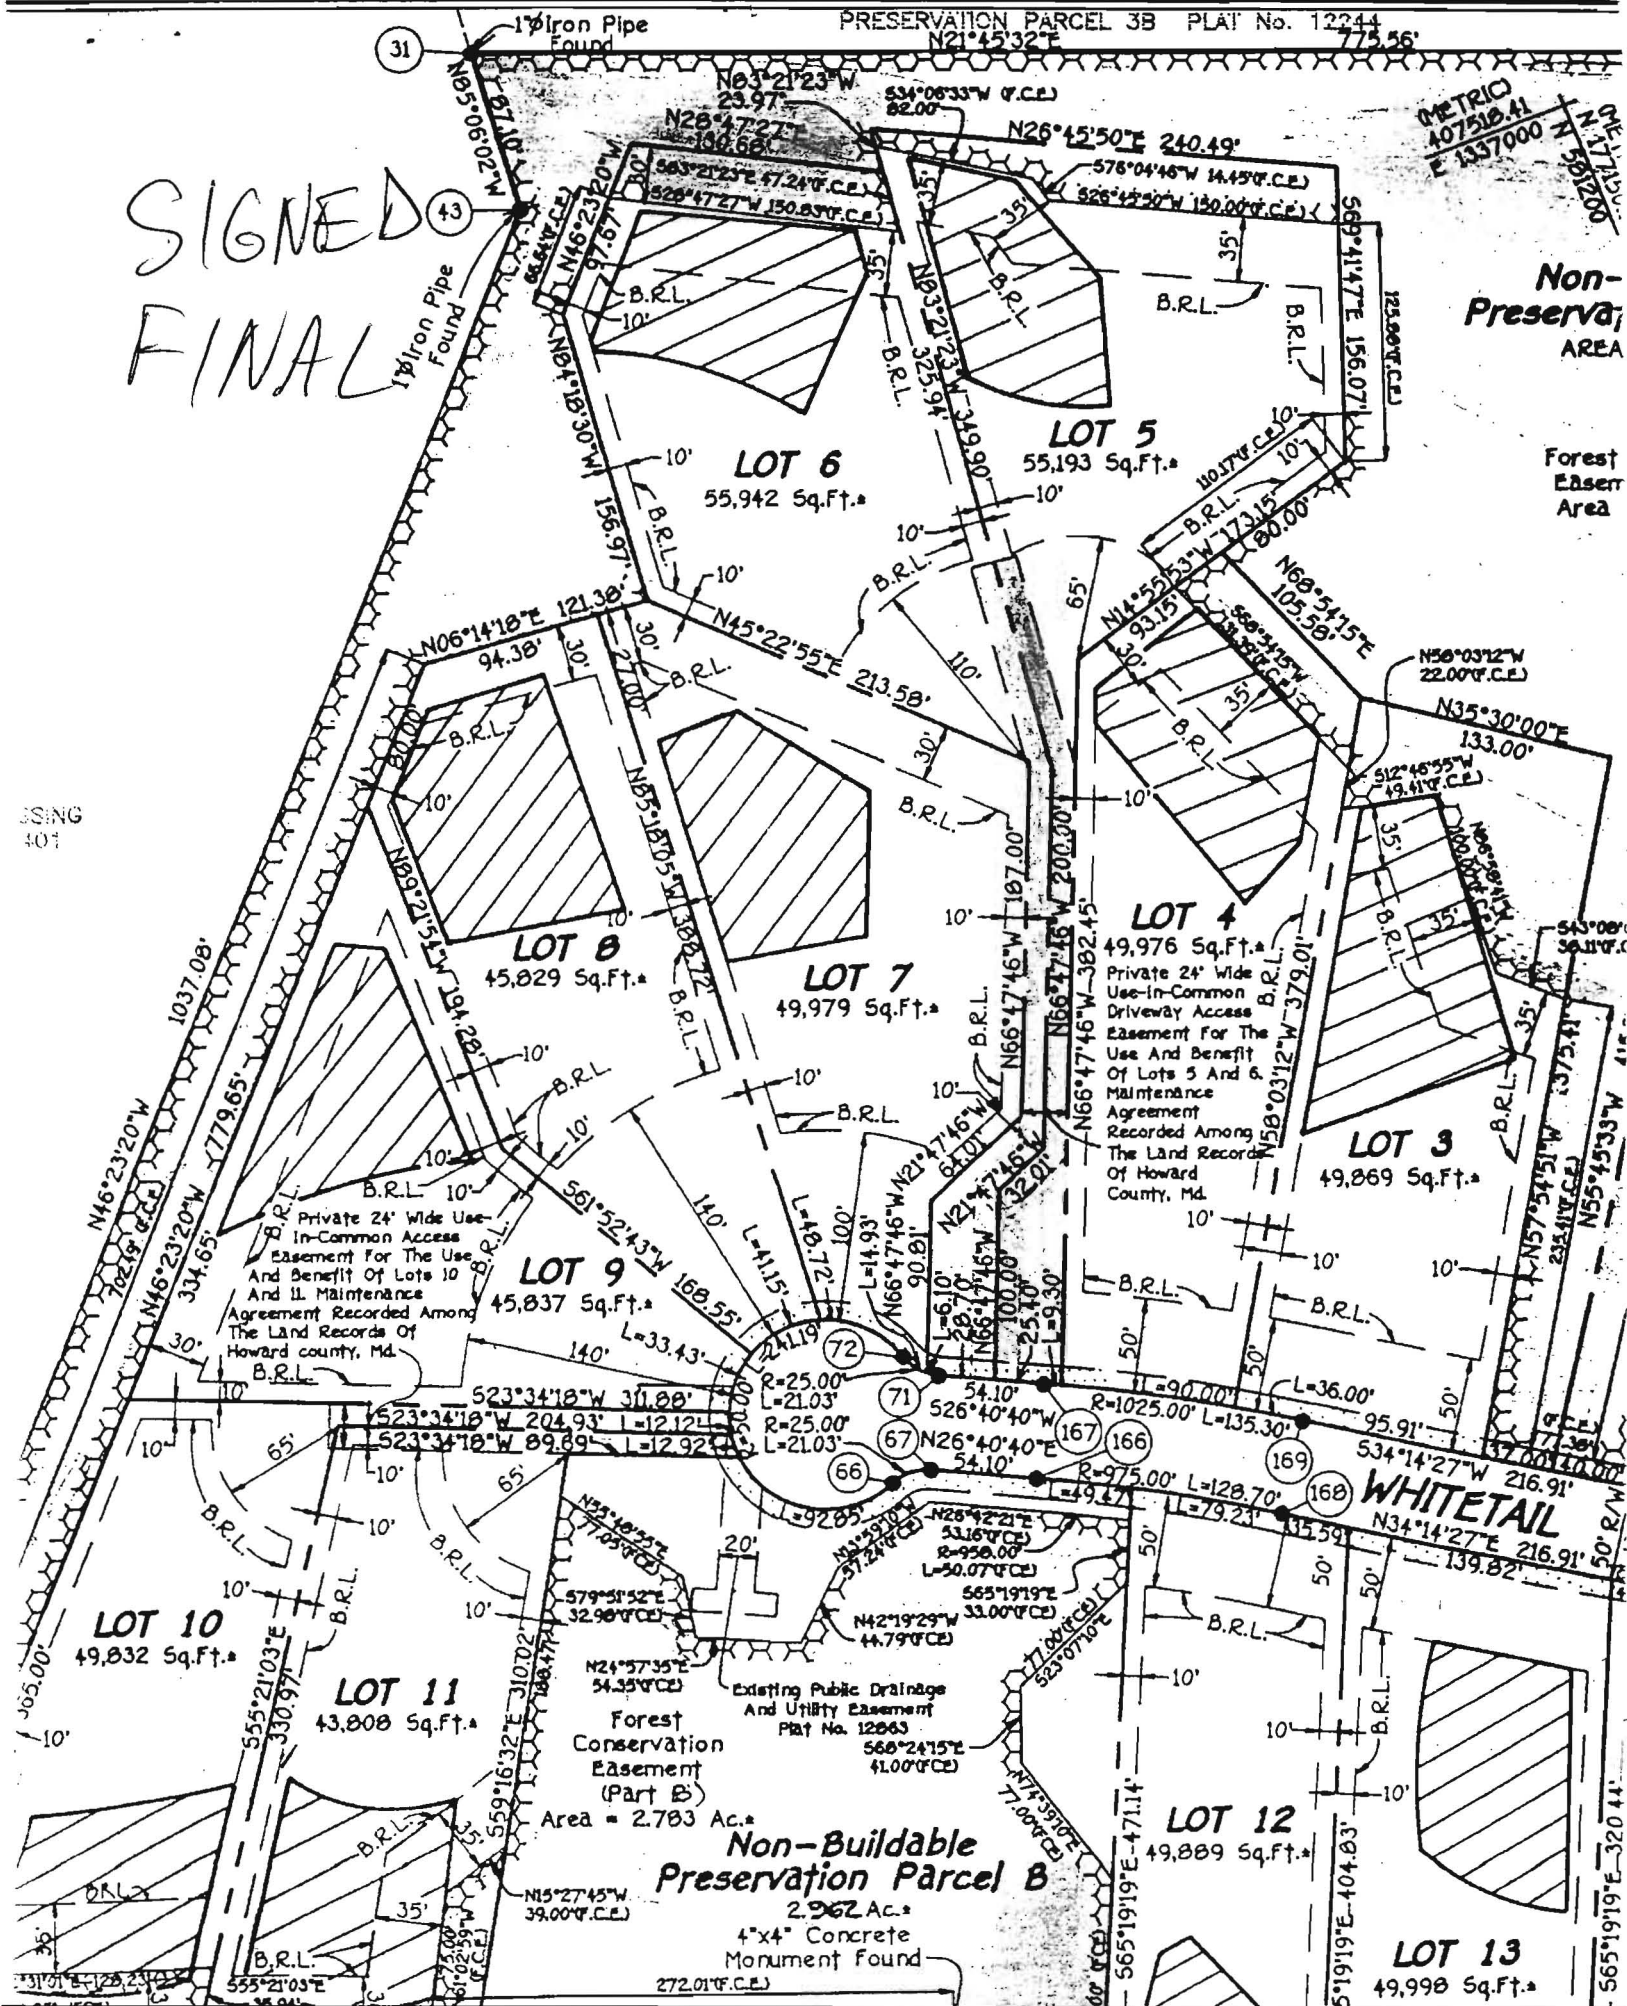

~~Private Use-In-Common Access~~
~~Esm't. for Lots 9-11~~

