

9/12/01
Layout
11:00

9/13/01
Anytime

ISSUE DATE: 9/5/2001

APPROVAL DATE: 9/13/01

PERMIT
INDEXED

P 516018-B

A 50905-I

ON-SITE SEWAGE DISPOSAL SYSTEM
HOWARD COUNTY HEALTH DEPARTMENT
BUREAU OF ENVIRONMENTAL HEALTH

03-325679

Fogles Septic Clean, Inc

IS PERMITTED TO INSTALL ☒ ALTER ☐

ADDRESS: 580 Obrecht Road, Sykesville

PHONE NUMBER: 410-795-5670

SUBDIVISION: Quarterfield III

LOT NUMBER: 8

ADDRESS: 11652 Whitetail Lane

PROPERTY OWNER: Darryl & Donna Stokes

SEPTIC TANK CAPACITY (GALLONS): 1250

PUMP CHAMBER CAPACITY (GALLONS): N/A

NUMBER OF BEDROOMS: 4

SQUARE FEET PER BEDROOM: 180

LINEAR FEET OF TRENCH REQUIRED: 240

| | |
|-----------|-------------------------------------------------------------------------------------------------------------------------------------------------------------------------------------------------------------------------|
| TRENCHES: | Trench to be 3.0 feet wide. Inlet 4.0 feet below original grade. Bottom maximum depth 6.0 feet below original grade. Effective area begins at 4.0 feet below original grade. 2.0 feet of stone below distribution pipe. |
| LOCATION: | Starting at the intersection of the 168.55' and 194.28' lot lines, place the distribution box 105' feet down the 194.28' lot line and 10' off this same lot line. Run (3) 80' trenches on contour to right side of lot. |
| NOTES: | |

PLANS APPROVED: MER OK SRM 8/30/01 DATE: 5/7/01

NOTE: PERMIT VOID AFTER 2 YEARS

NOTE: CONTRACTOR RESPONSIBLE FOR SCHEDULING A PRE-CONSTRUCTION INSPECTION FOR ALL INSTALLATIONS

NOTE: WATERTIGHT SEPTIC TANKS REQUIRED


NOTE: ALL PARTS OF SEPTIC SYSTEM SHALL BE 100 FEET FROM ANY WATER WELL

NOTE: MANHOLE RISERS REQUIRED ON ALL SEPTIC TANKS AND PUMP CHAMBERS

**NEITHER THE HOWARD COUNTY COUNCIL NOR THE HEALTH DEPARTMENT IS
RESPONSIBLE FOR THE SUCCESSFUL OPERATION OF ANY SYSTEM
PERMITTEE RESPONSIBLE FOR OBTAINING FINAL APPROVAL ON THIS PERMIT
CALL 410-313-2640 FOR INSPECTION OF SEPTIC SYSTEM**

P516018-B

NOT TO SCALE

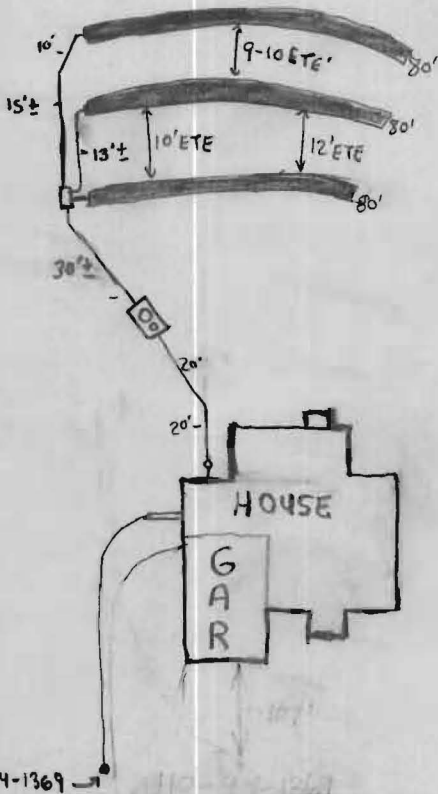

TRENCH DATA

TRENCH WIDTH 3
TRENCH INLET DEPTH 4'
TRENCH BOTTOM DEPTH 6'
DEPTH OF STONE 2'
NUMBER OF TRENCHES 3
TOTAL TRENCH LENGTH 240'
ABSORBENT AREA 720 ft²
DISTRIBUTION BOX LEVEL ☒
BAFFLE IN DISTRIBUTION BOX ☒

SEPTIC TANK DATA

SEPTIC TANK 1250TS GALLONS
MANHOLE RISER on center
6 INCH INSPECTION PORT on front

PUMP CHAMBER DATA

PUMP CHAMBER GALLONS NA
MANHOLE RISER NA
ALARM NA
PUMP PERFORMANCE TEST NA

White Tail Lane
PRE-CONSTRUCTION INSPECTION: 9/12/01 O.K. to install system as per
B.P. plan BB

INSPECTION COMMENTS: 9/12/01 WPS O.K. BB
9/13/01- ON TO COVER ALL WORK (SRK)

INSPECTOR Steven R. Krieg DATE SYSTEM APPROVED 9/13/01