


Approved Septic System Plan
Howard County Health Department
REVISED

SEPTIC SYSTEM ELEVS.

INV. @ HOUSE 568.9
INV. IN-TANK 568.5
INV. OUT-TANK 568.2
INV. DIST. BOX 568.0
INV. TRENCH 568.0

Andy McMill 12/15/00
Signature Date

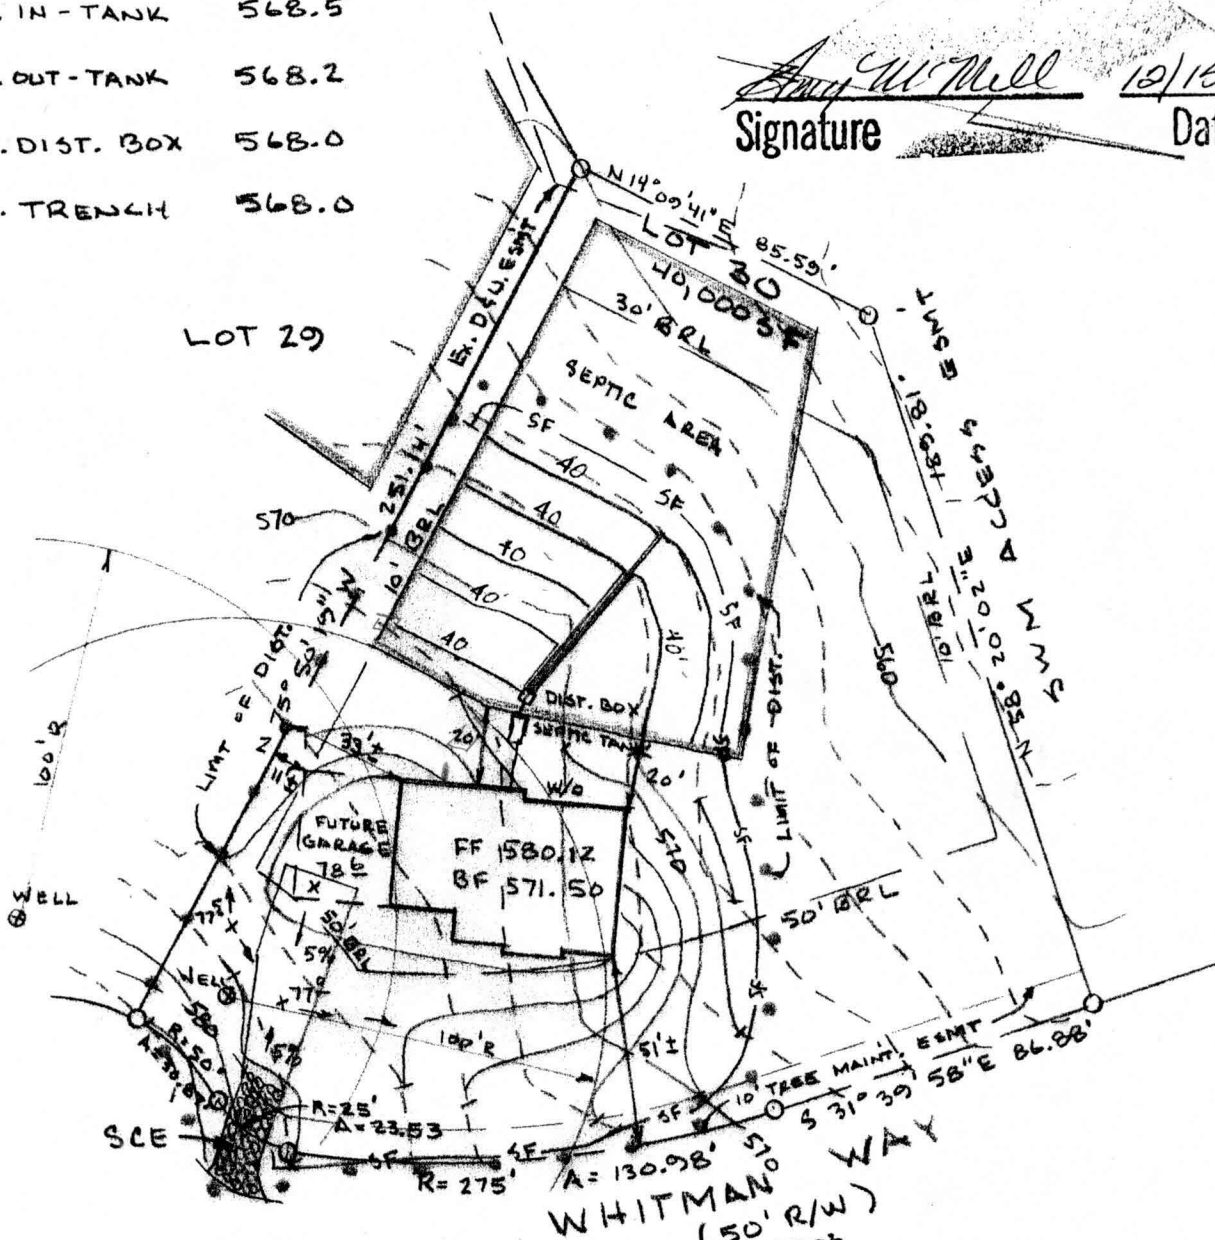


Total linear feet of trench required 240 feet

Width of trench(es) 2.0 feet

Depth of trench(es) 6.0 feet

Depth of stone required below distribution pipe 3.0 feet

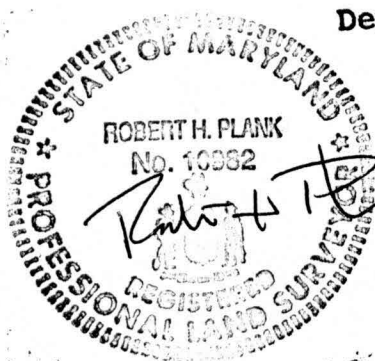

12-12-00

PLAT PLAN
LOT 30
LYNDONBROOK
SITUATED ON
WHITMAN WAY
3RD ELECTION DISTRICT
HOWARD COUNTY
MARYLAND
SCALE: 1"=50' DEC., 2000

REF. F97-126 / SEPTIC REVISED

I CERTIFY THIS PLAT TO BE CORRECT; IT IS THE RESULT OF AN ACTUAL FIELD SURVEY BASED ON DATA FOUND AMONG THE LAND RECORDS OF HOWARD COUNTY, MARYLAND, AS REFERENCED HEREON.

REFERENCE

JOB NO.

PLAT 13073


090540

NH NASSAUX-HEMSLEY, INC.

204 S. MAIN STREET
MOUNT AIRY, MARYLAND 21771
(301) 829-2296

12/7/00
Shown adjustment to SBA OK as
shown. Advised Rob Dorsey that
he should tell homeowners that
they are limited to a 10.0' wide
deck w/ this change. A McMill

Handwritten signature: *[Signature]*

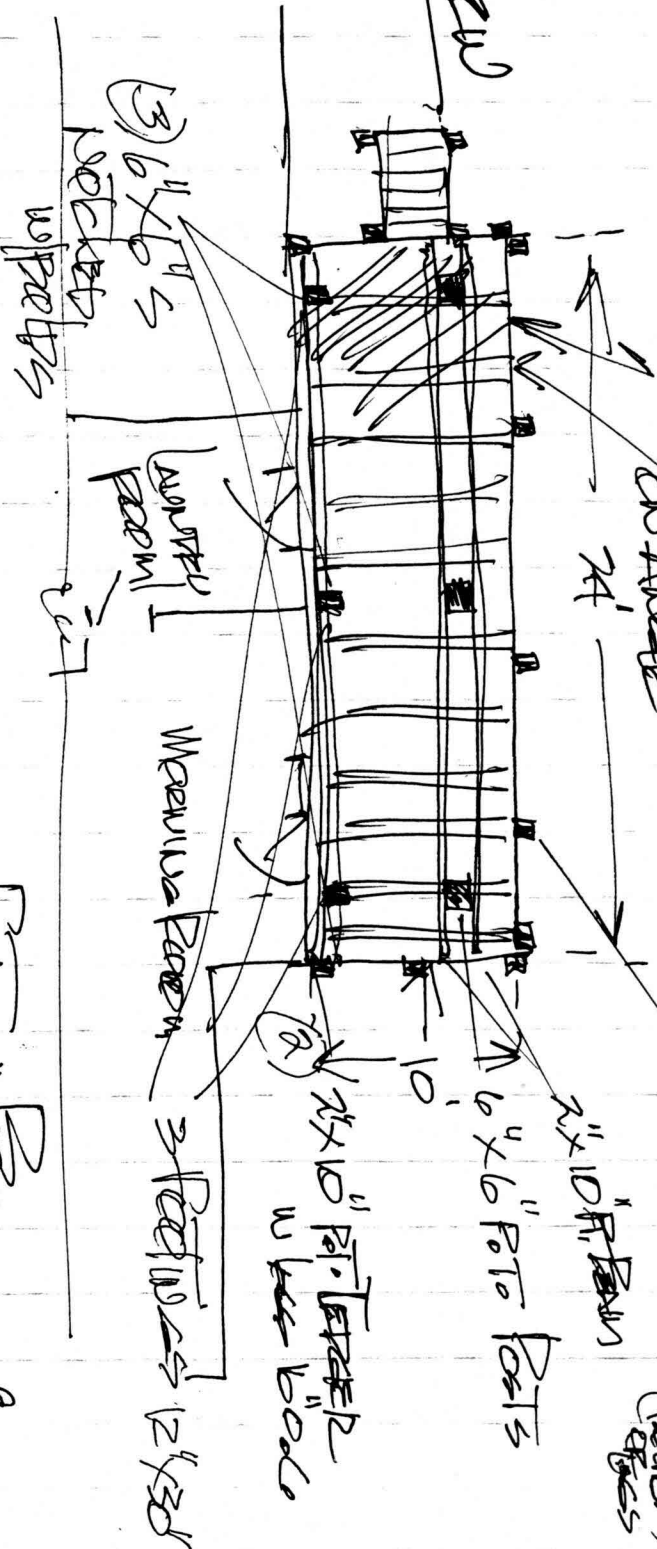

③ 6/10/19
10/10/19
10/10/19

~~Room~~

~~Menuis Papan~~

Part 1
of 10
12/30

for

Wet Park, Denver
#21088 Ultimate bet

Def - Partnership

Heaven

