


WOODSTOCK ROAD

Scale: 1"=40'

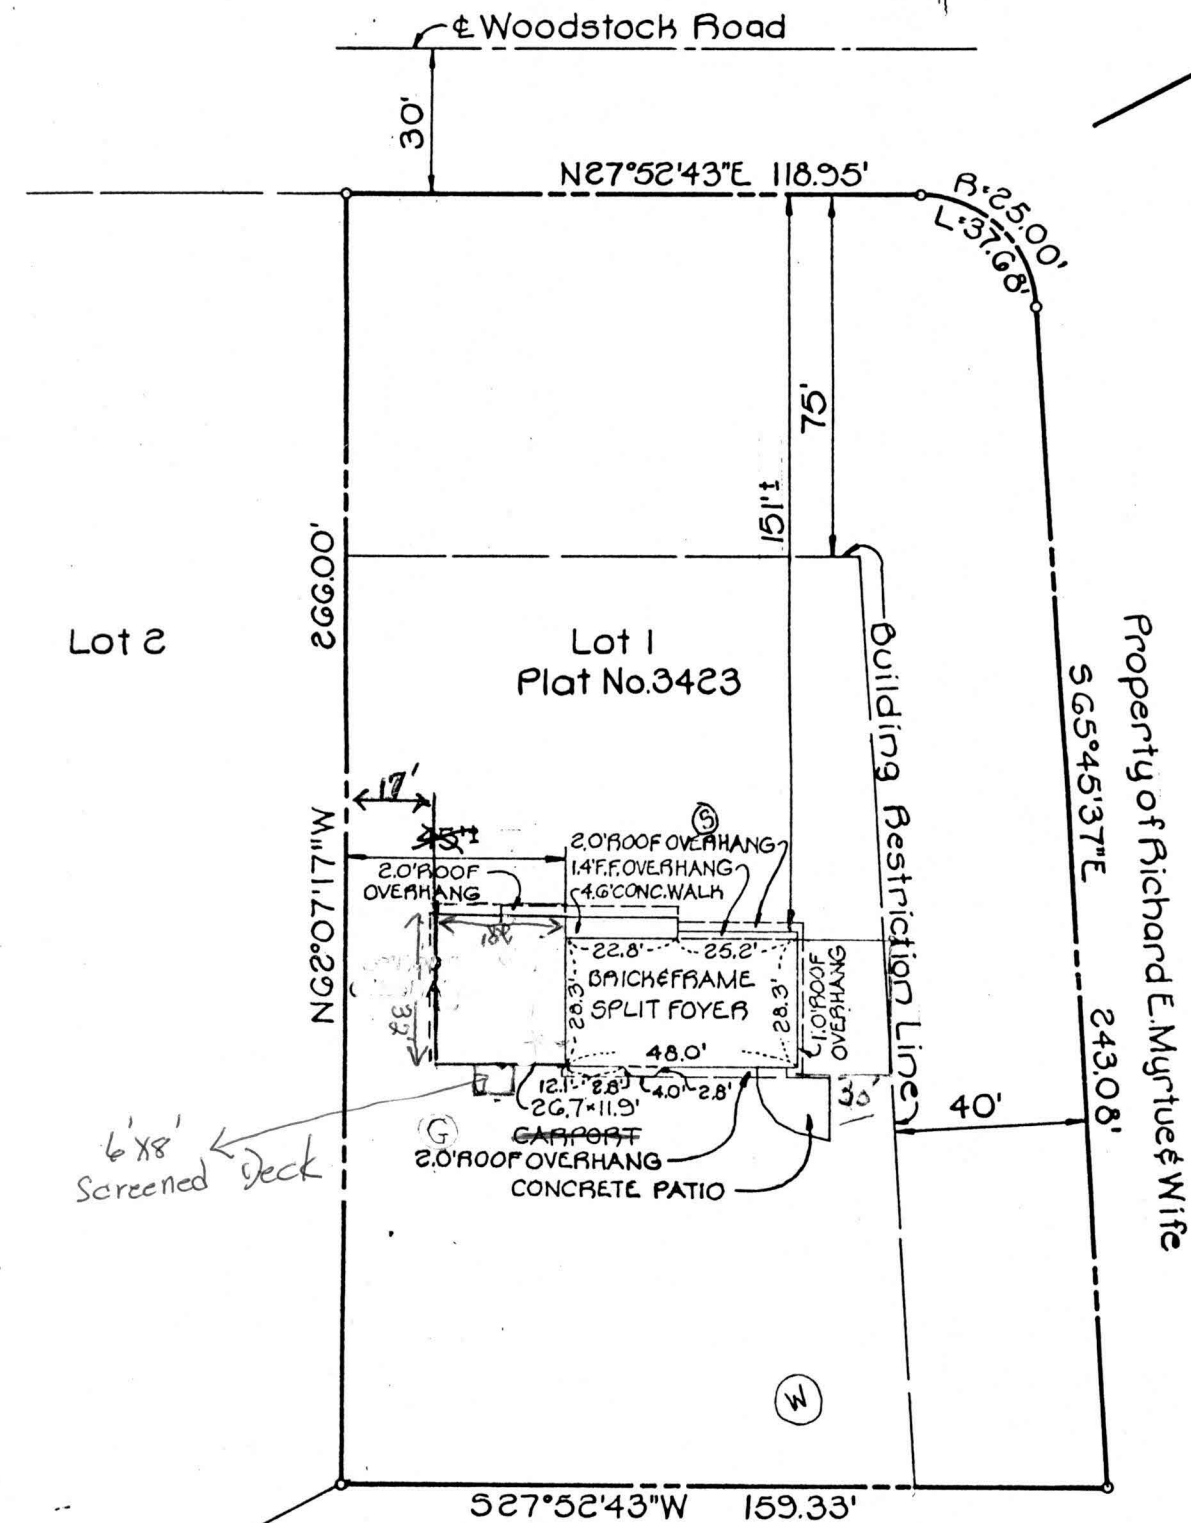

This is to certify that I have surveyed the property known as: Lot 1, Property of Richard E. Myrtue & Wife, 2nd Election District, Howard County, Maryland for the purpose of locating the improvements thereon, and the improvements are located as shown.

Signed this 11th day of May 1976

Walter Park


Walter Park, Land Surveyor
Md. Reg. No. 5539

Note: This plat is not intended for use in the establishment of property lines

CROVO & LEONARD
CIVIL ENGINEERING &
LAND SURVEYING
8669 OAK ROAD
BALTO., MARYLAND 21234

WOODSTOCK ROAD

Scale: 1"=40'

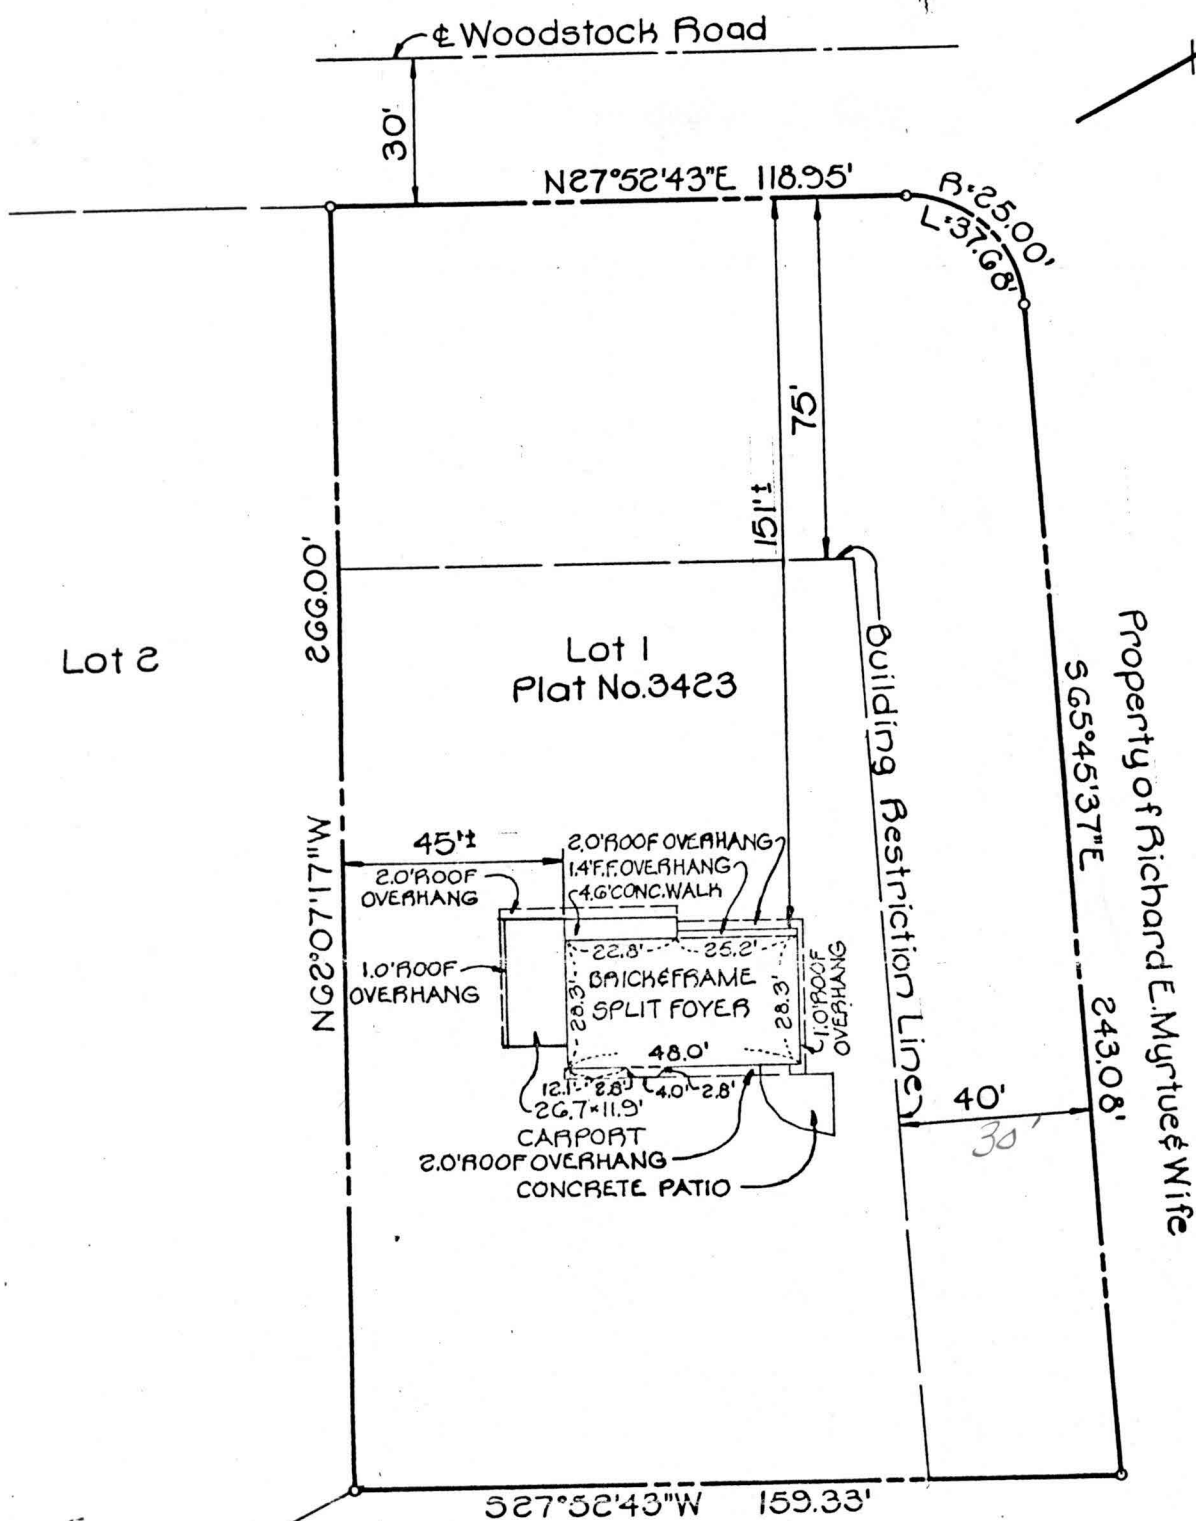

This is to certify that I have surveyed the property known as: Lot 1, Property of Richard E. Myrtue & Wife, 2nd Election District, Howard County, Maryland for the purpose of locating the improvements thereon, and the improvements are located as shown.

Signed this 11th day of May 1976

Walter Park


Walter Park, Land Surveyor
Md. Reg. No. 5539

Note: This plat is not intended for use in the establishment of property lines

BOVO & LEONARD
CIVIL ENGINEERING &
SURVEYING
669 OAK ROAD
ALTO, MARYLAND 21234

WOODSTOCK ROAD

Scale: 1"=40'

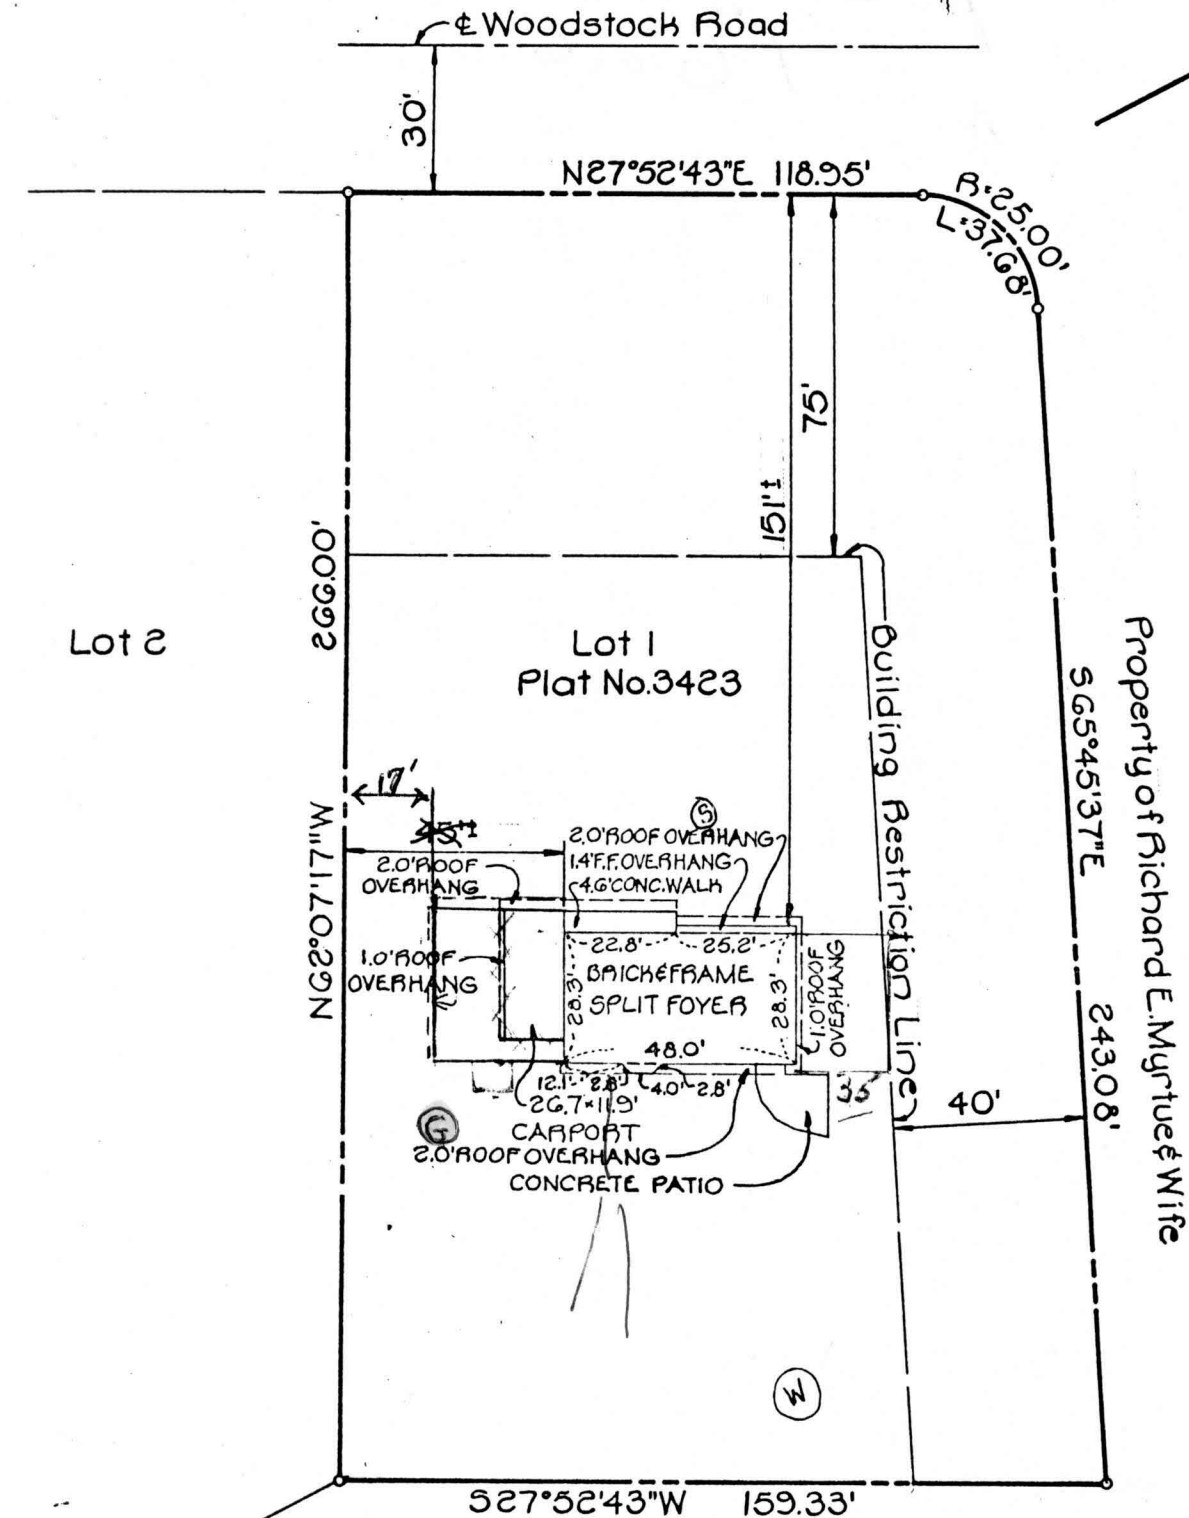

This is to certify that I have surveyed the property known as: Lot 1, Property of Richard E. Myrtue & Wife, 2nd Election District, Howard County, Maryland for the purpose of locating the improvements thereon, and the improvements are located as shown.

Signed this 11th day of May 1976

Walter Park

Walter Park, Land Surveyor
Md. Reg. No. 5539

Note: This plat is not intended for use in the establishment of property lines

CROVO & LEONARD
CIVIL ENGINEERING &
LAND SURVEYING
8669 OAK ROAD
BALTO., MARYLAND 21234

Frank C. Woods

1779 Woodstock Rd.

Woodstock, MD 21163-1330

410-465-9236


- ① Plan, with South Carol, to increase size of Septic field. Septic Tank?
- ② Do we a permit to move Propane Tank?

Future building
outlined in RED

*

(Septic) *

2 Car Garage under

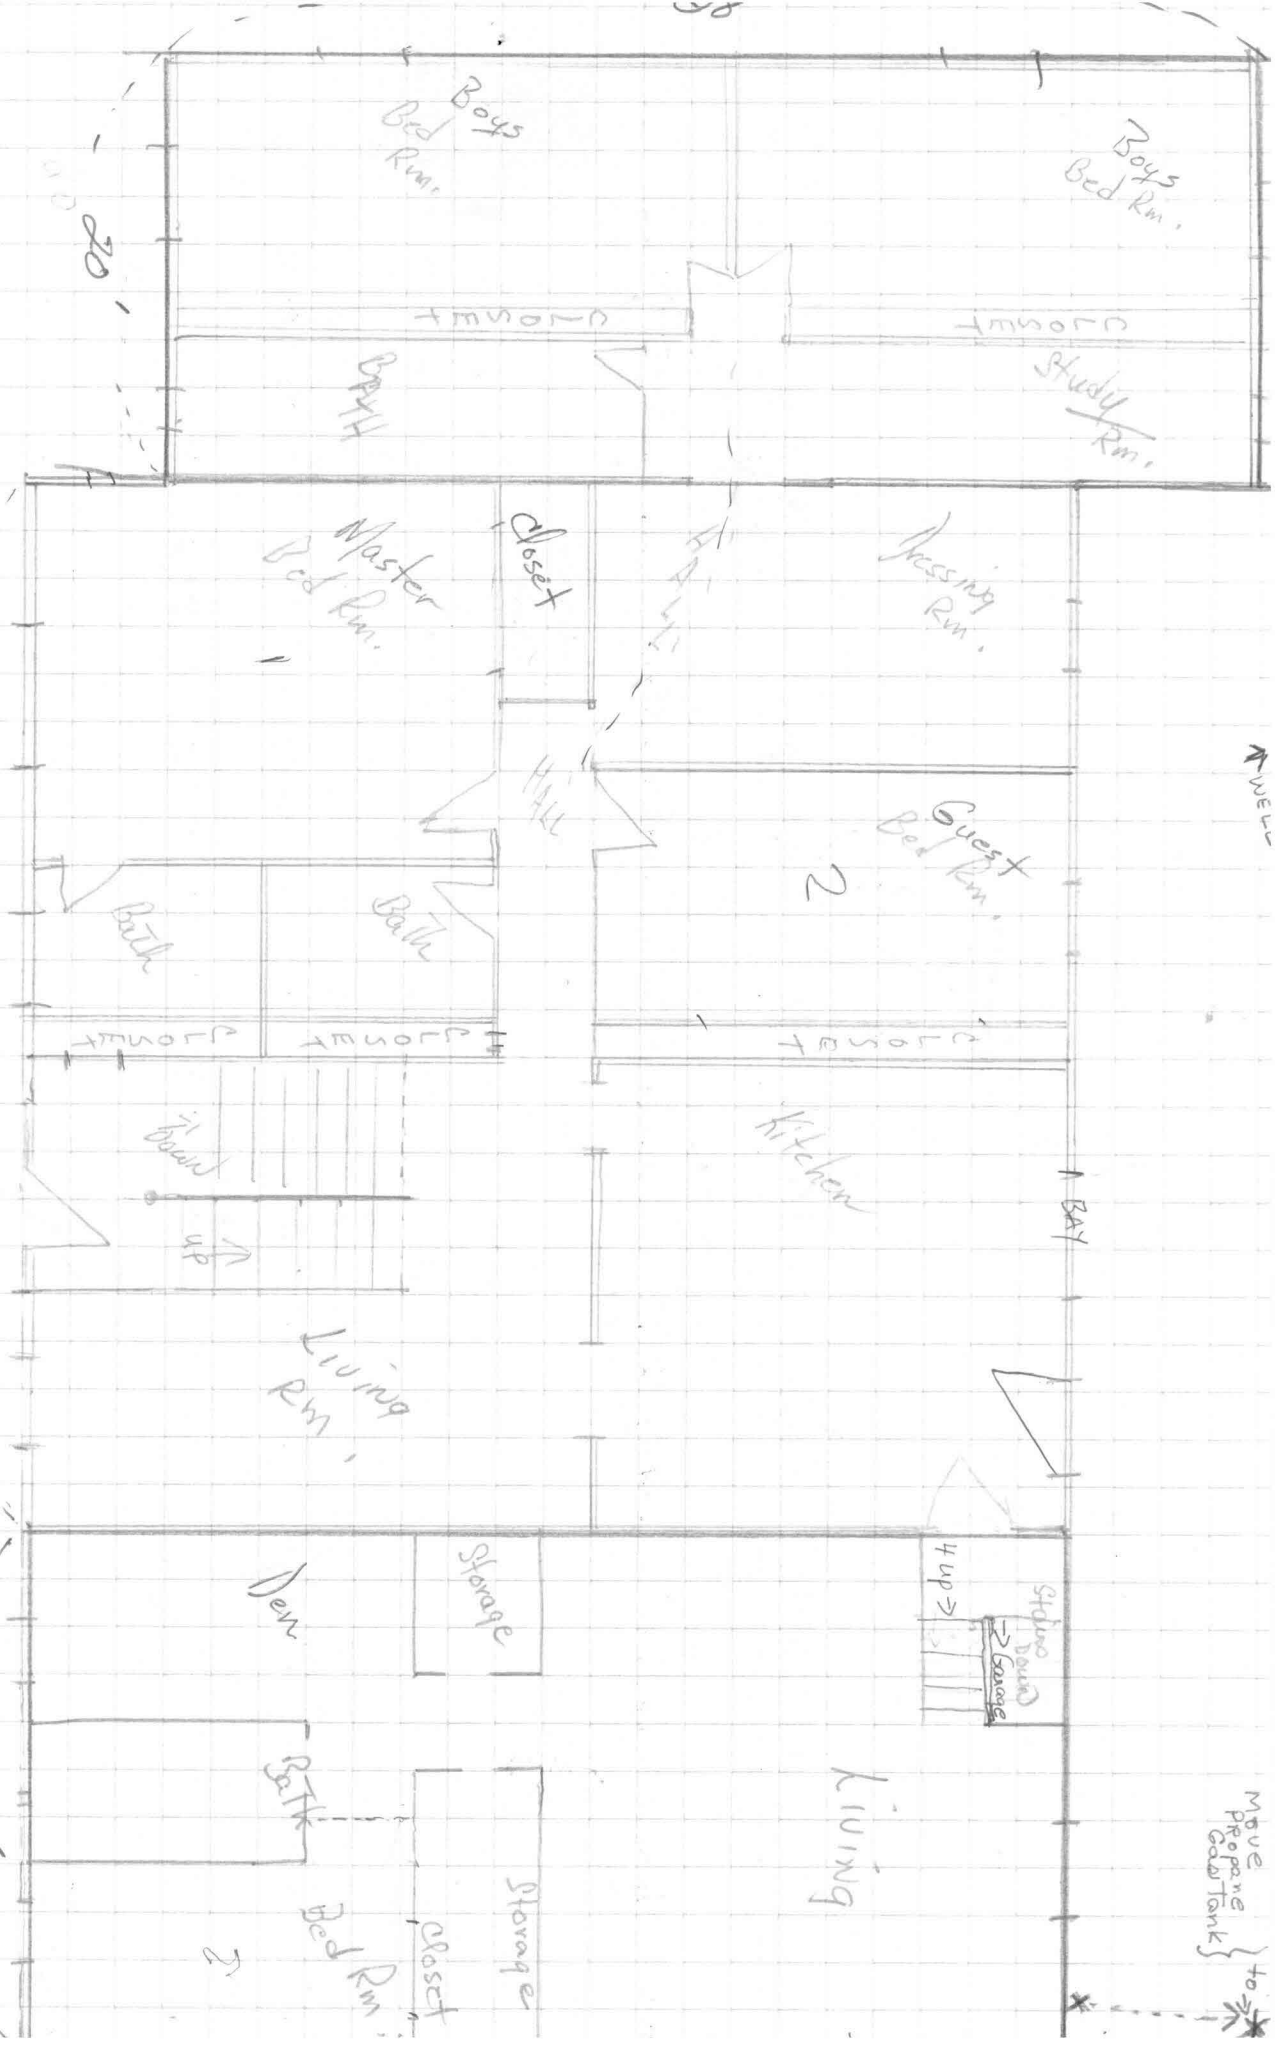

Move Propane Gas Tank to

WOODS, FRANK C. ←

1779 Woodstock Road ←

Woodstock, MD. 21163

410 465 9236