

03-292452  
**PERMIT**

**SEWAGE DISPOSAL SYSTEM**

HOWARD COUNTY HEALTH DEPARTMENT  
BUREAU OF ENVIRONMENTAL HEALTH  
410-313-2640

P 515380

A REPAIR

ISSUE DATE 5/8/2000

APPROVAL DATE 7/14/00

INDEXED

Collins Company

IS PERMITTED TO INSTALL ☐ ALTER ☒

ADDRESS 7702 Gaither Road, Sykesville, MD 21784 PHONE 410-795-8618

DIVISION LOT NUMBER ADDRESS 1970 Woodstock Road

PROPERTY OWNER Miller PROPERTY OWNER'S ADDRESS Same

SEPTIC TANK CAPACITY GALLONS

PUMP CHAMBER CAPACITY GALLONS

NUMBER OF BEDROOMS

SQUARE FEET PER BEDROOM

DEPT. FEET OF TRENCH REQUIRED

REMARKS: Trenches to be feet wide. Inlet feet below original grade. Bottom maximum depth feet below original grade. feet of stone below distribution box.

NOTES: To move septic tank so that the 10' minimum distance between the tank and the proposed addition is maintained. To demonstrate a reserve repair area capable of handling the existing 4 bedrooms and the bedroom addition.

PERMIT APPROVED DATE

PERMIT VOID AFTER 2 YEARS

NOTE: CONTRACTOR RESPONSIBLE FOR SCHEDULING A PRE-CONSTRUCTION INSPECTION FOR ALL INSTALLATIONS

NOTE: TOP OF SEPTIC TANKS ARE TO BE NO DEEPER THAN 3.0 FEET BELOW FINISH GRADE

NOTE: WATERTIGHT SEPTIC TANKS REQUIRED

NOTE: CLEANOUT REQUIRED EVERY 70 FEET OF SEWER LINE AND/OR AT 90° SWEEPS IN LINES FROM HOUSE TO DRAIN FIELDS, 90° ELBOWS ARE NOT ACCEPTABLE

NOTE: ALL PARTS OF SEPTIC SYSTEMS (I.E. TANK, DISTRIBUTION BOX, DRAINFIELDS) TO BE 100 FEET FROM ANY WATER WELL UNLESS OTHERWISE SPECIFICALLY AUTHORIZED

NOTE: NO ABSORPTION TRENCH TO EXCEED 100 FEET IN LENGTH UNLESS SPECIFICALLY AUTHORIZED

NOTE: ALL PIPE FROM HOUSE TO SEPTIC TANK MUST BE CAST IRON OR SCHEDULE 35/40 PVC OR ABS

NOTE: MANHOLE RISERS REQUIRED ON ALL SEPTIC TANKS AND PUMP CHAMBERS

NOTE: DISTRIBUTION BOXES MUST HAVE BAFFLES

NOTE: IF PUMPED SEPTIC SYSTEM REQUIRED, (1) SEPTIC PUMP DETAIL TO BE PROVIDED BY INSTALLER PRIOR TO ISSUANCE OF SEPTIC PERMIT (2) PUMP PERFORMANCE TEST IS NECESSARY PRIOR TO HEALTH DEPARTMENT APPROVAL OF SEPTIC PERMIT


NEITHER THE HOWARD COUNTY COUNCIL NOR THE HEALTH DEPARTMENT IS RESPONSIBLE FOR THE SUCCESSFUL OPERATION OF ANY SYSTEM

PERMITTEE RESPONSIBLE FOR OBTAINING FINAL APPROVAL ON THIS PERMIT

CALL 410-313-2640 FOR INSPECTION OF SEPTIC SYSTEM

P 515380

Red Brown Clay Loam 7' → 5 1/2 minutes  
 Light Br Sa Loam 5% Rock  
 Light Br Sa Loam 35% Rock  
 NOT TO SCALE  
 Light Br Si Loam 5% Rock  
 13.5'  
 Med. Brk Sa Loam 5% Rock  
 11'  
 3' / 13.5' V → 5 minutes  
 1 min → repair 2 1/4 min

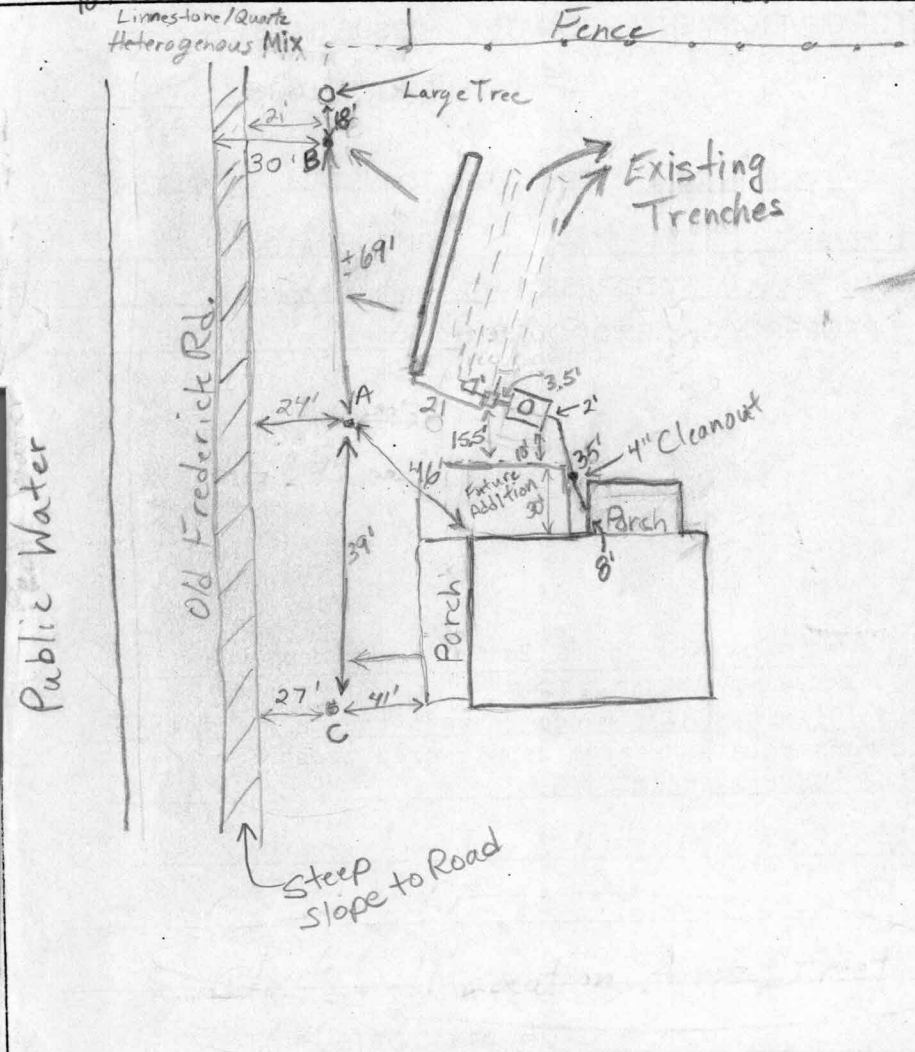

### TRENCH DATA - New Trench

TRENCH WIDTH 2.0'  
 TRENCH INLET DEPTH 3.0'  
 TRENCH BOTTOM DEPTH 8.0'  
 DEPTH OF STONE 5.0'  
 NUMBER OF TRENCHES 1  
 TOTAL TRENCH LENGTH 60'  
 ABSORBENT AREA 300 sq. ft.  
 DISTRIBUTION BOX LEVEL OK  
 BAFFLE IN DISTRIBUTION BOX Yes

### SEPTIC TANK DATA

SEPTIC TANK 1500 MS GALLONS  
 MANHOLE RISER Yes  
 6 INCH INSPECTION PORT No

### PUMP CHAMBER DATA

PUMP CHAMBER GALLONS \_\_\_\_\_  
 MANHOLE RISER \_\_\_\_\_  
 ALARM \_\_\_\_\_  
 PUMP PERFORMANCE TEST \_\_\_\_\_

PRE-CONSTRUCTION INSPECTION: \_\_\_\_\_

INSPECTION COMMENTS: 6/8/00 Tank set, connected to house. Part of both existing trenches will be destroyed after new tank and distribution are set. Another trench to be installed adjacent to trench closest to Old Frederick Rd. to compensate difference. (BB)  
7/11/00 One 60' trench with stone from 3'-8' to be added to make up difference for loss of 5-10' from existing trenches. New trench started. Connection of all 3 trenches to distribution box needs to be confirmed. (BB)


INSPECTOR B. Baber

DATE SYSTEM APPROVED 7/14/00

7/14/00 Everything satisfactory. Trench closest to tank may be slightly less than 20' from addition, ~18'. Approximately 900 sq. ft. in all three trenches. (BB)

Survey of Property known as # 1970 Woodstock Road. Being the residue of a 10 acre tract of land recorded among the Land Records of Howard County in Liber 137 Folio 25. Saving & Excepting from the said 10 acres those parcels of land recorded in Liber 199 Folio 410; Liber 207 Folio 354, Liber 597 Folio 731, Liber 222 Folio 545 & Liber 343 Folio 677.

\*\*\*NOTE: THIS HOUSE IS NOT LOCATED IN THE FLOOD PLAIN.

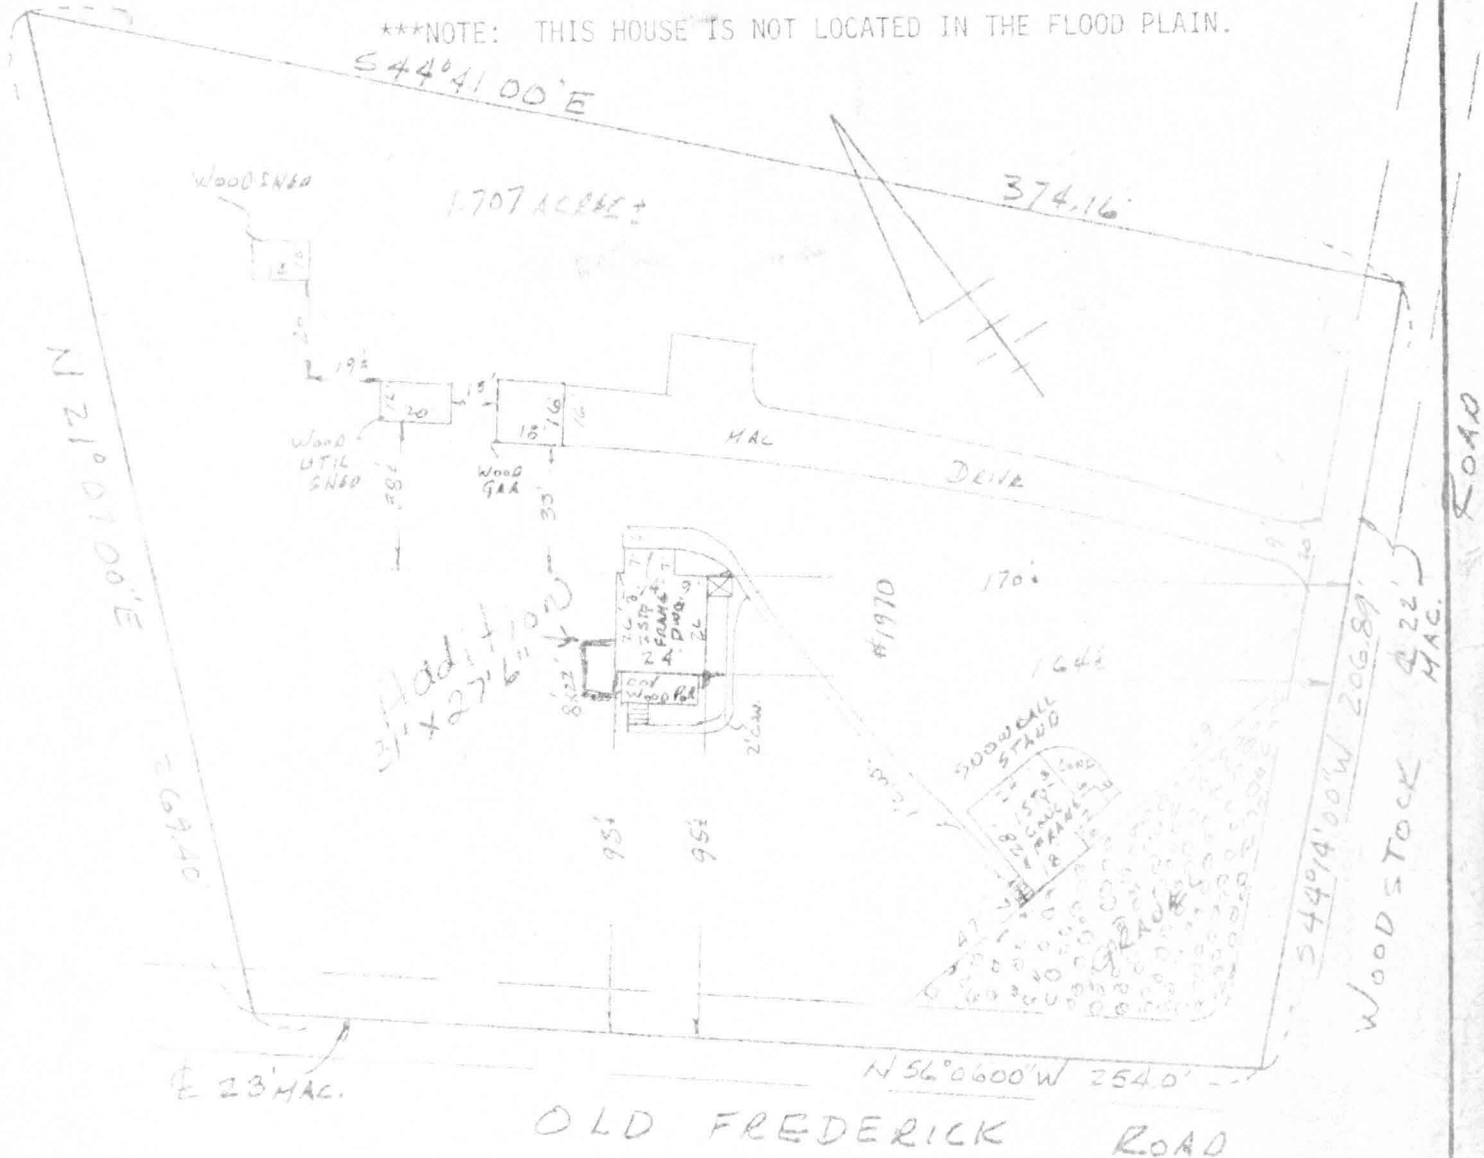

THIS PLAT IS NOT INTENDED FOR THE USE  
IN THE ESTABLISHMENT OF PROPERTY LINES.

This is to certify that the improvements  
indicated hereon are located as shown. This is  
not a property line survey and should not be  
used as such.



*Sourabh Menon*

**DON LYNCH ASSOC., INC.**  
**4907 HARFORD ROAD**  
**BALTIMORE, MD. 21214**

Scale: 1" = 50'

Date: 5/21/91