

APPLICATION

PERCOLATION TESTING

A 516057

P _____

HOWARD COUNTY HEALTH DEPARTMENT

BUREAU OF ENVIRONMENTAL HEALTH

3525-H ELLICOTT MILLS DRIVE/ELLICOTT CITY, MARYLAND 21043

TELEPHONE: 313-2640

DISTRICT _____

DATE 10/5/01

TO: THE COUNTY HEALTH OFFICER
ELLICOTT CITY, MARYLAND

I HEREBY APPLY FOR THE NECESSARY TEST PRIOR TO APPLICATION FOR PERMIT TO CONSTRUCT (OR RECONSTRUCT) A SEWAGE DISPOSAL SYSTEM.

PROPERTY OWNER JOHN C BEWLEY, REVOCABLE TRUST

15359 UNION CHAPEL RD.
ADDRESS WOODBINE MD 21797 PHONE _____

AGENT OR PROSPECTIVE BUYER GRAYSON DEV. CO. LLC. c/o KOREN DEV. CO.

815 CENTER PARK DR. STE 104
ADDRESS COLUMBIA MD 21045 PHONE _____

PROPERTY LOCATION:

DIVISION BEWLEY PROPERTY LOT NO. 9

ROAD AND DESCRIPTION UNION CHAPEL RD

TAX MAP 14 PARCEL # 166

SIZE OF LOT ±1 AC TYPE BLDG. SF. DWELLING
(SINGLE FAMILY DWELLING OR COMMERCIAL)

THE SYSTEM INSTALLED UNDER THIS APPLICATION IS ACCEPTABLE ONLY UNTIL PUBLIC FACILITIES BECOME AVAILABLE. I FULLY UNDERSTAND THE

FEE CONNECTED WITH THE FILING OF THIS PERC TEST APPLICATION IS NON-REFUNDABLE UNDER ANY CIRCUMSTANCES. I ALSO AGREE TO

COMPLY WITH ALL M.O.S.H.A. REQUIREMENTS IN TESTING THIS LOT.

David B. Yanny GRAYSON DEVELOPMENT
DAVID B. YANNOY (SIGNATURE OF APPLICANT) COMPANY, LLC

APPROVED BY _____ FOR _____ DATE _____

DISAPPROVED BY _____ FOR _____ DATE _____

HOLD PENDING FURTHER TESTS _____

REASONS FOR REJECTION OR HOLDING Needs Wet Season tests

PERCOLATION TEST PLAT/PRELIMINARY PLAT - TITLE OR I.D. # _____ DATE _____

SITE DEVELOPMENT PLAN/FINAL PLAT - TITLE OR I.D. # _____ DATE _____





THIS IS NOT A PERMIT

516051

COUNTY #


NOT TO SCALE

SOIL PROFILE

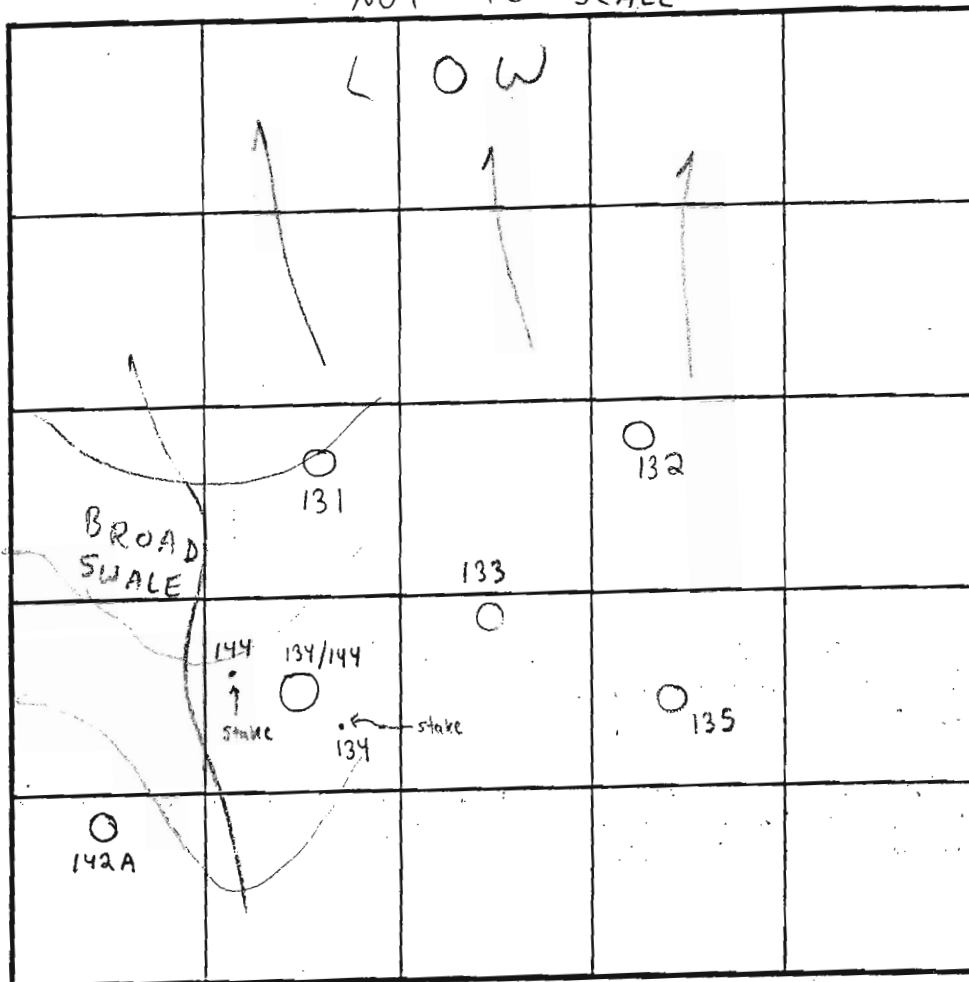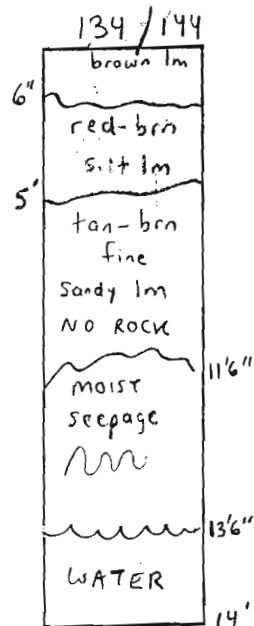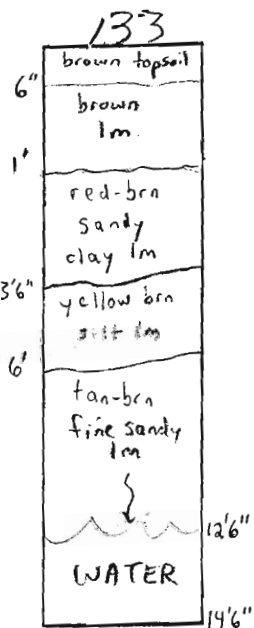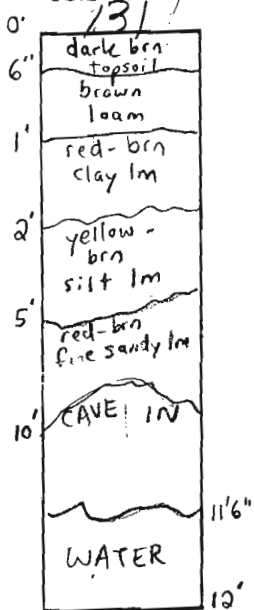

INDICATE NORTH - NAME ADJOINING ROADWAY AS BASE LINE.

SOIL PROFILE

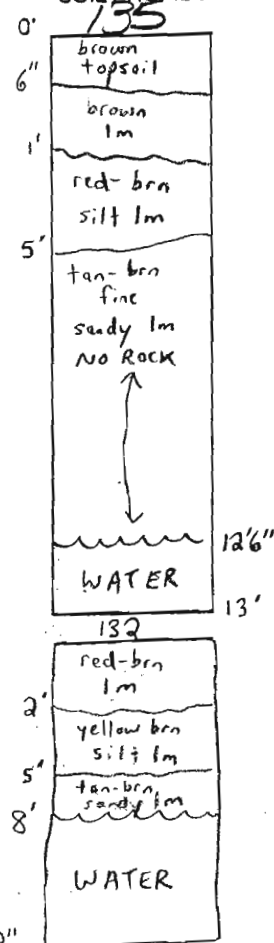

DATE	TEST NO.	DEPTH	PRE-WET		TEST - 1" DROP		TIME	
			START	STOP	START	STOP		
4/17/03	131	4'6" T / 10' V	3:26 pm	3:42 pm	3:42 pm	4:11 pm	29 min	OK
	132	4' T / 8' V	3:03 pm	3:10 pm	3:10 pm	3:19 pm	9 min	OK
	134/144	5'2" T / 11'6" V	2:35 pm	2:41 pm	2:41 pm	2:52 pm	11 min	OK
	135	12'6" V	(VISUAL OK)	(SEE SOIL PROFILE)			NA	OK
	133	12'6" V	(VISUAL OK)	(SEE SOIL PROFILE)			NA	OK
		(WILL PERC AT 5')						

REMARKS Visual holes textured & picked w/ trowel

TYPE OF SOIL Glenelg Arg. Wet Season Water Levels

TESTED BY FA/SRK

ALSO PRESENT Todd Parks = Buckbee

TRENCH DESIGN DATA: AVERAGE PERCOLATION TIME

TRENCH WIDTH 3'

INLET DEPTH 2

MAXIMUM BOTTOM DEPTH 4

SQ. FT. BEDROOM

(SHALLOW SYSTEM ONLY)

Bottom area only may need open trench inspection

RC-DEO

SIGNED RC.
11/21/03

GnA

PRESERVATION PARCEL "A"
NON BUILDABLE

PRE

HOWARD COUNTY MAJOR COLLECTOR & SCENIC ROAD

UNION

CHAPEL

ROAD

PLACE "D"

OPEN SPACE
0.3 AC +/-

47

8

12

10

11

22

23

24

"C"

"A"

PROPOSED 30'
1/2 R.O.W.

40'
R.O.W.

520

40'
R.O.W.

PROPOSED 30'
1/2 R.O.W.

ACCESS PLACE
ACCESS STREET

40'
R.O.W.

40'
R.O.W.

W

W

