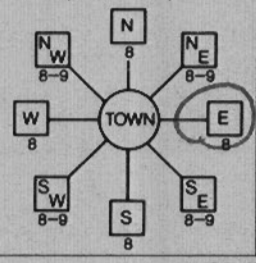
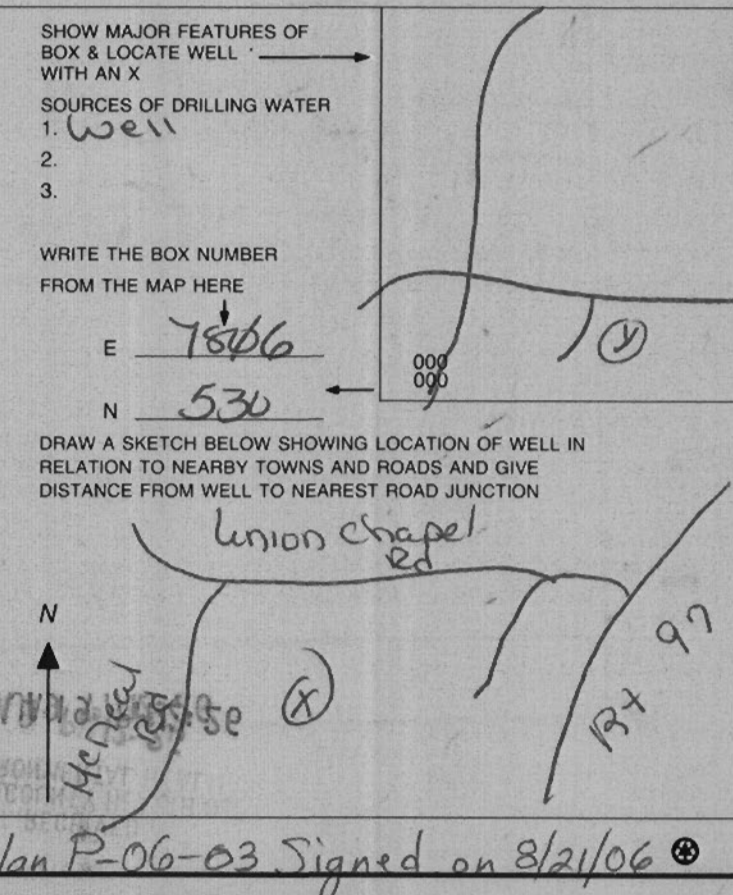


C1 8646	SEQUENCE NO. (MDE USE ONLY)	STATE OF MARYLAND WELL COMPLETION REPORT FILL IN THIS FORM COMPLETELY PLEASE TYPE	THIS REPORT MUST BE SUBMITTED WITHIN 45 DAYS AFTER WELL IS COMPLETED.
1 2 3 6 (THIS NUMBER IS TO BE PUNCHED IN COLS. 3-6 ON ALL CARDS)			COUNTY NUMBER (13) A516057
ST/CO USE ONLY DATE Received MM DO YY 8 13	DATE WELL COMPLETED 06 29 07	Depth of Well 22 300 26 9/7/07 (TO NEAREST FOOT) 0 K BB	PERMIT NO. FROM "PERMIT TO DRILL WELL" H0-95-0654 28 29 30 31 32 33 34 35 36 37
OWNER Bewley STREET OR RFD Sweetbay Street SUBDIVISION Belle Haven Estates		TOWN Woodbine SECTION 46	

WELL LOG Not required for driven wells STATE THE KIND OF FORMATIONS PENETRATED, THEIR COLOR, DEPTH, THICKNESS AND IF WATER BEARING <table border="1" style="width:100%; border-collapse: collapse;"> <thead> <tr> <th rowspan="2">DESCRIPTION (Use additional sheets if needed)</th> <th colspan="2">FEET</th> <th rowspan="2">check if water bearing</th> </tr> <tr> <th>FROM</th> <th>TO</th> </tr> </thead> <tbody> <tr> <td>Soil</td> <td>0</td> <td>10</td> <td></td> </tr> <tr> <td>Brown shale</td> <td>10</td> <td>30</td> <td></td> </tr> <tr> <td>Gray Rock</td> <td>30</td> <td>300 x</td> <td></td> </tr> <tr> <td>Water at</td> <td>73</td> <td>+210'</td> <td></td> </tr> </tbody> </table>	DESCRIPTION (Use additional sheets if needed)	FEET		check if water bearing	FROM	TO	Soil	0	10		Brown shale	10	30		Gray Rock	30	300 x		Water at	73	+210'		GROUTING RECORD (yes no) WELL HAS BEEN GROUTED (Circle appropriate box) TYPE OF GROUTING MATERIAL (Circle one) CEMENT CM BENTONITE CLAY BC NO. OF BAGS 9 NO. OF POUNDS 900 GALLONS OF WATER 54 DEPTH OF GROUT SEAL (to nearest foot) from 0 ft. to 34 ft. (enter 0 if from surface) CASING RECORD casing types insert appropriate code below <table border="1" style="width:100%; border-collapse: collapse;"> <tr> <td>ST STEEL</td> <td>CO CONCRETE</td> </tr> <tr> <td>PL PLASTIC</td> <td>OT OTHER</td> </tr> </table> MAIN CASING TYPE PL Nominal diameter top (main) casing (nearest inch) 6 Total depth of main casing (nearest foot) 34 60 61 63 64 66 70 OTHER CASING (if used) diameter inch depth (feet) from to EACH CASING screen type or open hole insert appropriate code below <table border="1" style="width:100%; border-collapse: collapse;"> <tr> <td>ST STEEL</td> <td>BR BRASS</td> <td>HO OPEN HOLE</td> </tr> <tr> <td>PL PLASTIC</td> <td>OT OTHER</td> <td></td> </tr> </table>	ST STEEL	CO CONCRETE	PL PLASTIC	OT OTHER	ST STEEL	BR BRASS	HO OPEN HOLE	PL PLASTIC	OT OTHER		C3 PUMPING TEST HOURS PUMPED (nearest hour) 3 PUMPING RATE (gal. per min.) 13.6 METHOD USED TO MEASURE PUMPING RATE Submersible WATER LEVEL (distance from land surface) BEFORE PUMPING 28 ft. WHEN PUMPING 60 ft. TYPE OF PUMP USED (for test) <table border="1" style="width:100%; border-collapse: collapse;"> <tr> <td>A air</td> <td>P piston</td> <td>T turbine</td> </tr> <tr> <td>C centrifugal</td> <td>R rotary</td> <td>O other (describe below)</td> </tr> <tr> <td>J jet</td> <td>S submersible</td> <td></td> </tr> </table>	A air	P piston	T turbine	C centrifugal	R rotary	O other (describe below)	J jet	S submersible	
DESCRIPTION (Use additional sheets if needed)		FEET			check if water bearing																																						
	FROM	TO																																									
Soil	0	10																																									
Brown shale	10	30																																									
Gray Rock	30	300 x																																									
Water at	73	+210'																																									
ST STEEL	CO CONCRETE																																										
PL PLASTIC	OT OTHER																																										
ST STEEL	BR BRASS	HO OPEN HOLE																																									
PL PLASTIC	OT OTHER																																										
A air	P piston	T turbine																																									
C centrifugal	R rotary	O other (describe below)																																									
J jet	S submersible																																										
NUMBER OF UNSUCCESSFUL WELLS: 0 WELL HYDROFRACTURED Y N CIRCLE APPROPRIATE LETTER A A WELL WAS ABANDONED AND SEALED WHEN THIS WELL WAS COMPLETED E ELECTRIC LOG OBTAINED P TEST WELL CONVERTED TO PRODUCTION WELL I HEREBY CERTIFY THAT THIS WELL HAS BEEN CONSTRUCTED IN ACCORDANCE WITH COMAR 26.04.04 "WELL CONSTRUCTION" AND IN CONFORMANCE WITH ALL CONDITIONS STATED IN THE ABOVE CAPTIONED PERMIT, AND THAT THE INFORMATION PRESENTED HEREIN IS ACCURATE AND COMPLETE TO THE BEST OF MY KNOWLEDGE. DRILLERS LIC. NO. M SD 162 DRILLERS SIGNATURE (MUST MATCH SIGNATURE ON APPLICATION) Daniel Tab LIC. NO. AW D 766 SITE SUPERVISOR (sign. of driller or journeyman responsible for sitework if different from permittee)			C2 DEPTH (nearest ft.) 1 2 3 100 H0 34 300 E A C H S C R E E N SLOT SIZE 1 2 3 DIAMETER OF SCREEN (NEAREST INCH) 56 60 from to GRAVEL PACK IF WELL DRILLED WAS FLOWING WELL INSERT F IN BOX 68 MDE USE ONLY (NOT TO BE FILLED IN BY DRILLER) T (E.R.O.S.) W Q 70 72 74 75 76 TELESCOPE CASING LOG INDICATOR OTHER DATA																																								

PUMP INSTALLED DRILLER INSTALLED PUMP YES NO IF DRILLER INSTALLS PUMP, THIS SECTION MUST BE COMPLETED FOR ALL WELLS. TYPE OF PUMP INSTALLED PLACE (A,C,J,P,R,S,T,O) IN BOX 29 CAPACITY: GALLONS PER MINUTE (to nearest gallon) 31 35 PUMP HORSE POWER 37 41 PUMP COLUMN LENGTH (nearest ft.) 43 47 CASING HEIGHT (circle appropriate box and enter casing height) + above } LAND SURFACE (nearest foot) - below } LOCATION OF WELL ON LOT SHOW PERMANENT STRUCTURE SUCH AS BUILDING, SEPTIC TANKS, AND /OR LANDMARKS AND INDICATE NOT LESS THAN TWO DISTANCES (MEASUREMENTS TO WELL) 85' 15' Prop Line

B 1 1 2 3 6 9194	SEQUENCE NO. (MDE USE ONLY)	STATE OF MARYLAND APPLICATION FOR PERMIT TO DRILL WELL 526193 please type	STATE PERMIT NUMBER HO-95-0654 70 fill in this form completely 79
Date Received (APA) 8 MM DD YY 13 Grayson Homes 15 Last Name Owner First Name 34 9025 Chevrolet Drive 36 Street or RFD 55 Ellicott City MD 21043 57 Town 70 State 72 Zip 76		B 3 LOCATION OF WELL 8 COUNTY 21 Howard Belle Haven Est 23 SUBDIVISION 42 SECTION 44 46 LOT 46 48 50 Woodbine 52 NEAREST TOWN 71 MILES FROM TOWN (enter 0 if in town) 2 M I 73 76 77 78	
DRILLER INFORMATION Michael D. Isom MWS D 162 Driller's Name 76 License No. 81 G. Edgar Harr Sons' Corp. Firm Name 12047 Falls Road, Cockeysville 21030 Address Signature 1/10/07 Date		B 4 1 2 DIRECTION OF WELL FROM TOWN (CIRCLE BOX)  Sweetbay Street Union Chapel Road 11 NEAR WHAT ROAD 30 ON WHICH SIDE OF ROAD (CIRCLE APPROPRIATE BOX) 375 34 37 DISTANCE FROM ROAD ENTER FT OR MI Ft 38 39 TAX MAP: 14 BLK: 20 PARCEL 66	
B 2 WELL INFORMATION 1 2 APPROX. PUMPING RATE (GAL. PER MIN.) 5 8 12 750 AVERAGE DAILY QUANTITY NEEDED (GAL. PER DAY) 14 20		NOT TO BE FILLED IN BY DRILLER HEALTH DEPARTMENT APPROVAL Howard (13) A516057 COUNTY NAME COUNTY NO. STATE SIGNATURE INSERT S → 41 DATE ISSUED 2/13/2007 Brian Baber 2/13/2008 43 MM DD YY 48 CO SIGNATURE EXP. DATE NORTH GRID 530 0 0 0 EAST GRID 786 0 0 0 50 55 57 63	
USE FOR WATER (CIRCLE APPROPRIATE BOX) <input checked="" type="radio"/> D DOMESTIC POTABLE SUPPLY & RESIDENTIAL IRRIGATION <input type="radio"/> F FARMING (LIVESTOCK WATERING & AGRICULTURAL IRRIGATION) 22 <input type="radio"/> I INDUSTRIAL, COMMERCIAL, DEWATERING <input type="radio"/> P PUBLIC WATER SUPPLY WELL <input type="radio"/> T TEST, OBSERVATION, MONITORING <input type="radio"/> G GEO-THERMAL		SHOW MAJOR FEATURES OF BOX & LOCATE WELL WITH AN X SOURCES OF DRILLING WATER 1. Well 2. 3. WRITE THE BOX NUMBER FROM THE MAP HERE E 7866 N 530 000 000 DRAW A SKETCH BELOW SHOWING LOCATION OF WELL IN RELATION TO NEARBY TOWNS AND ROADS AND GIVE DISTANCE FROM WELL TO NEAREST ROAD JUNCTION 	
APPROXIMATE DEPTH OF WELL 300 FEET 24 28 APPROXIMATE DIAMETER OF WELL 6 NEAREST INCH			
METHOD OF DRILLING (circle one) BORED (or Augered) JETTED Jetted & DRIVEN 30 AIR-ROTARY AIR-PERCussion ROTARY (Hydraulic Rotary) 37 CABLE REVERSE-ROTARY Drive-POINT other			
REPLACEMENT OR DEEPEMED WELLS (CIRCLE APPROPRIATE BOX) <input checked="" type="radio"/> N THIS WELL WILL NOT REPLACE AN EXISTING WELL <input checked="" type="radio"/> Y THIS WELL WILL REPLACE A WELL THAT WILL BE ABANDONED AND SEALED 39 <input type="radio"/> S THIS WELL WILL REPLACE A WELL THAT WILL BE USED AS A STANDBY-CONTACT LOCAL APPROVING AUTHORITY FOR POLICY ON STANDBY WELLS <input type="radio"/> D THIS WELL WILL DEEPEMED AN EXISTING WELL PERMIT NUMBER OF WELL TO BE REPLACED OR DEEPEMED (IF AVAILABLE) 41 52			
Not to be filled in by driller (MDE OR COUNTY USE ONLY) APPROP. PERMIT NUMBER H02007.0002 PERMIT No. HO-95-0654 70 71 72 73 74 75 76 77 78 79			
SPECIAL CONDITIONS NOTE - APPROVING AUTHORITIES SHOULD USE SEPARATE SHEET IF NEEDED Well to be Drilled Per Plan P-06-03 Signed on 8/21/06			

HARR WELL DRILLING

12047 FALLS ROAD
COCKEYSVILLE, MD 21030
410-252-4588

HOWARD COUNTY WELL YIELD TEST REPORT


Date Test Performed: 6-29-07
Address: Union Chapel Rd
Owner Name: Grayson Homes
Well Depth: 300 Ft

Permit Number: HO-95-0654
Subdivision: Belle Haven Estates lot 46
Election District:
Static Water Level: 28 ft

Time	Water Level	PSI Existing Pump	Pumping Rate Seconds to fill 5gallon bucket	Calculated Flow-Gallons Per Minute
0845	28 ft		22 sec	13.63 gpm
0900	59		22	13.63
0915	60		22	13.63
0930	60		22	13.63
0945	60		22	13.63
1000	60		22	13.63
1015	60		22	13.63
1030	60		22	13.63
1045	60		22	13.63
1100	60		22	13.63
1115	60		22	13.63
1130	60		22	13.63
1145	60		22	13.63

SWEETBAY ST.

2/23/07 Wellsite
 Staked by DMW.
 Copy of plan P-06-03.
 Existing well must be
 sealed if not already
 done. (BB)

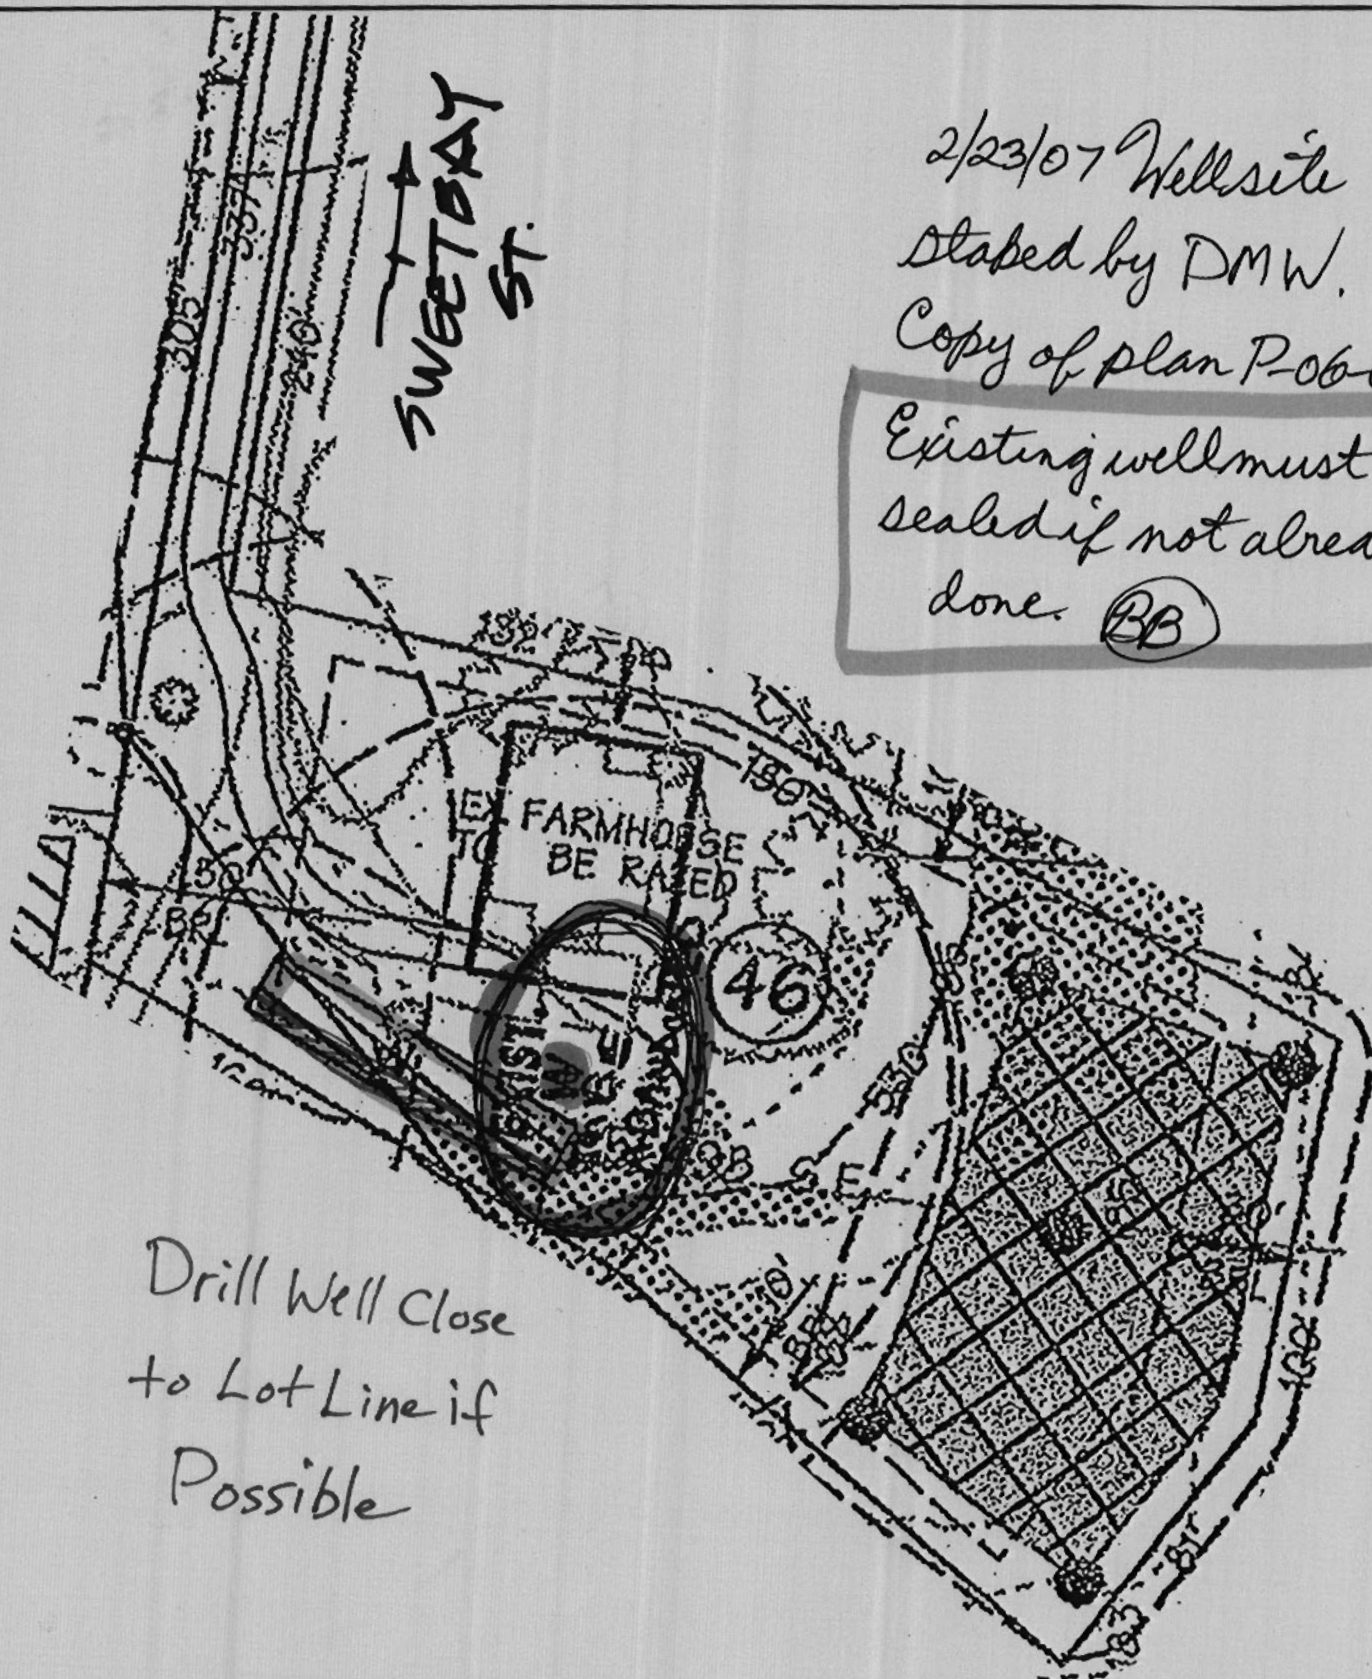

Drill Well Close
 to Lot Line if
 Possible

BELLE HAVEN ESTATES

LOT 46

DMW

Daft-McCune-Walker, Inc.

200 East Pennsylvania Avenue
 Towson, Maryland 21286
 (410) 296-3333
 Fax 296-4705

A Team of Land Planners,
 Landscape Architects,
 Engineers, Surveyors &
 Environmental Professionals

Job No. 01067 Scale: 1"=50' Date: 12/26/06 Drawn By: MDT

N:\01067\01067FLot Wells\FINAL\Lot46.dgn

Tue Feb 13 11:05:24 2007

HOWARD COUNTY HEALTH DEPARTMENT
BUREAU OF ENVIRONMENTAL HEALTH
WELL & SEPTIC PROGRAM
TEL: (410)313-1771 FAX: (410)313-2648

Information Form for the Installation of the Well Pump, Pitless Adapter, and Supply Piping

NOTE: The installer is responsible for requesting an inspection prior to 9 am on the day of the desired inspection. No work is to be covered until approved by the Health Department. All installations must comply with the National Standard Plumbing Code (NSPC, as amended locally) and COMAR 26.04.04 (MD Well Construction Regulations). Submission of a complete form is required prior to Use and Occupancy approval.

Company Name: Northern Virginia Drilling Telephone #: 703-361-6259
Address: 11351a Industrial Rd. O
MANASSAS VA 20109

(Must circle one) Licensed Plumber Licensed Well Driller Licensed Well Pump Installer
License # and name of individual responsible for the field installation: License# MSD216
Name (Print): SHAWN MILLER
*A licensed individual must perform the actual installation. Apprentices must be under the supervision of a licensed journeyman or master plumber, pump installer or well driller. Licenses may be subjected to field verification. Unlicensed individuals may be reported to the appropriate licensing agency.

Name of Property Owner: K. Harnanian Homes Telephone #: 240-882-7662
Subdivision: Belle Haven Lot #: 46 Well Tag #: HO-95-0654
Site Address: 15289 Sweetbay St.
Woodbine MD 21797

Submersible Pump Data

Make: Flint and Walling

Model #: 4F10S10

Pump Capacity 10 GPM

Well Yield: 13.6 GPM

Depth of well encountered at time of pump installation: 300 (feet)

If pump capacity exceeds well yield, a low water cut off switch is required by NSPC 1990 Section 17.8.4

Torque arrestors, Cable guards, or other acceptable method used— Must circle one

Safety rope, if used, attached to brass rope adapter or other acceptable method inside of well casing ✓

Pitless Adapter

Make: Bost Hart

Model #: P10255

Depth: 36" (36" min)

NSF/WSC approved: ✓

Well Cap and Electric Conduit

Two piece watertight cap: ✓

Screened, vented well cap: ✓

Cap secured to casing: ✓

Conduit min 18" B.G.: ✓

Conduit secured to well cap: ✓

Piping to house

Type: Polyethylene

PSI: 200 (160 psi min)

Depth of supply line: 36" (36" min)

House Connection

PVC sleeve to undisturbed soil at wall penetration: ✓

Length of sleeve(s' minimum from foundation): 10' +

Sleeve sealed properly: ✓

The water supply line is required to be at least ten feet from the septic tank, pump chamber, sewage piping, distribution box, drainfields, and sewage reserve area. If this cannot be accomplished, contact this office for approval prior to installation.

Signature of company representative responsible for installation: Shawn Miller

date: 8-8-13

For Health Department Use Only – Not to be completed by Installer

Date Insp. Requested: _____ Date Insp. Approved: _____ Inspector: _____

Inspection Data: Pitless adapter watertight & water supply line at least 36" below grade _____

Two piece cap installed and attached to casing securely _____

Elec. conduit extends at least 18" below grade/attached to cap properly _____

Safety rope not outside of well cap/casing _____

Correct well tag attached properly and casing 8" above finished grade _____

Water supply line sleeved adequately at house connection _____

Adequate grout observed below pitless adapter _____

HOWARD COUNTY HEALTH DEPARTMENT
BUREAU OF ENVIRONMENTAL HEALTH
WELL & SEPTIC PROGRAM
TEL: (410)313-1771 FAX: (410)313-2648

Information Form for the Installation of the Well Pump, Pitless Adapter, and Supply Piping

NOTE: The installer is responsible for requesting an inspection prior to 9 am on the day of the desired inspection. No work is to be covered until approved by the Health Department. All installations must comply with the National Standard Plumbing Code (NSPC, as amended locally) and COMAR 26.04.04 (MD Well Construction Regulations). Submission of a complete form is required prior to Use and Occupancy approval.

Company Name: _____ Telephone #: _____
Address: _____

(Must circle one) Licensed Plumber Licensed Well Driller Licensed Well Pump Installer
License # and name of individual responsible for the field installation:

Name (Print): _____ License# _____

***A licensed individual must perform the actual installation. Apprentices must be under the supervision of a licensed journeyman or master plumber, pump installer or well driller. Licenses may be subjected to field verification. Unlicensed individuals may be reported to the appropriate licensing agency.**

Name of Property Owner: _____ Telephone #: _____
Subdivision: _____ Lot #: 46 Well Tag #: HO 95-0654
Site Address: 15289 Sweetbay St.

Submersible Pump Data

Make: _____
Model #: _____
Pump Capacity _____ GPM
Well Yield: _____ GPM

Pitless Adapter

Make: _____
Model#: _____
Depth: _____ (36" min)
NSF/WSC approved: _____

Well Cap and Electric Conduit

Two piece watertight cap: _____
Screened, vented well cap: _____
Cap secured to casing: _____
Conduit min 18" B.G.: _____
Conduit secured to well cap: _____

Depth of well encountered at time of pump installation: _____ (feet)
If pump capacity exceeds well yield, a low water cut off switch is required by NSPC 1990 Section 17.8.4

Torque arrestors, Cable guards, or other acceptable method used- Must circle one

Safety rope, if used, attached to brass rope adapter or other acceptable method inside of well casing

Piping to house

Type: _____
PSI: _____ (160 psi min)
Depth of supply line: _____ (36" min)

House Connection

PVC sleeve to undisturbed soil at wall penetration: _____
Length of sleeve (5' minimum from foundation): _____
Sleeve sealed properly: _____

The water supply line is required to be at least ten feet from the septic tank, pump chamber, sewage piping, distribution box, drainfields, and sewage reserve area. If this cannot be accomplished, contact this office for approval prior to installation.

Signature of company representative responsible for installation _____ date _____

For Health Department Use Only - Not to be completed by Installer

Date Insp. Requested: _____ Date Insp. Approved: 8/16/2013 Inspector: BB

Inspection Data: Pitless adapter watertight & water supply line at least 36" below grade ☒

Two piece cap installed and attached to casing securely ☒

Elec. conduit extends at least 18" below grade/attached to cap properly ☒

Safety rope not outside of well cap/casing ☒

Correct well tag attached properly and casing 8" above finished grade ☒

Water supply line sleeved adequately at house connection ☒

Adequate grout observed below pitless adapter ☒

Sleeved
Under
Driveway

MARYLAND DEPARTMENT OF THE ENVIRONMENT, WATER MANAGEMENT ADMINISTRATION

1800 Washington Blvd., Baltimore, Maryland 21230 (410) 537-3784

WATER WELL ABANDONMENT-SEALING REPORT FORM

SUBMIT COPIES OF COMPLETED FORM TO:


- * COUNTY ENVIRONMENT AGENCY (contact MDE, WMA if address needed)
- * WELL OWNER
- * MDE, WATER MANAGEMENT ADMINISTRATION, WELL PROGRAM

DATE WELL ABANDONED: 5-11-07 (month/day/year)

- * PERMIT NUMBER OF ABANDONED WELL (if any)
- * PERMIT NUMBER OF REPLACEMENT WELL
- * PERSON ABANDONING WELL: Michael Isom
- * OWNER'S NAME: Grayson Homes

WELL DRILLERS LICENSE NUMBER: 162
CIRCLE: MWD/MSD/MGD

SITE LOCATION MAP

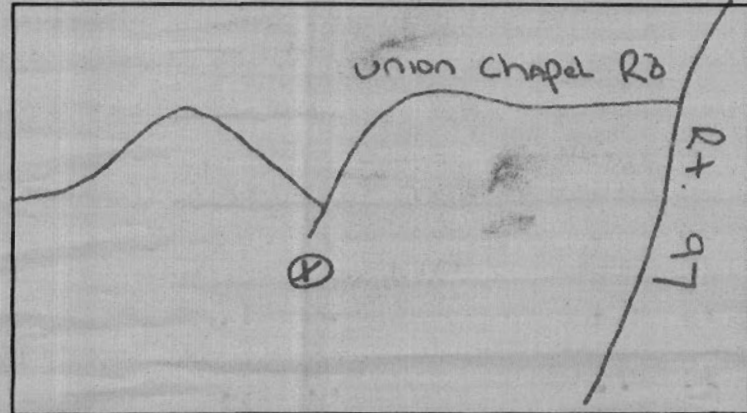

- * WELL LOCATION:
- COUNTY: Howard
- NEAREST TOWN: Woodbine
- TAX MAP BLOCK PARCEL
- SUBDIVISION: Belle Haven Est
- SECTION: LOT: 46
- NEAREST ROAD: 15359 Union Chapel Rd
Sweetbay St.

TYPE OF WELL BEING ABANDONED:

- ☒ DRILLED ☐ JETTED
- ☐ BORED/AUGERED ☐ HAND DUG
- ☐ OTHER (specify)

USE CODE:

- ☒ DOMESTIC ☐ MUNICIPAL/PUBLIC
- ☐ IRRIGATION ☐ INDUSTRIAL
- ☐ TEST/OBSERVATION ☐ GEOTHERMAL

TYPE OF CASING:

- ☒ STEEL ☐ PLASTIC
- ☐ CONCRETE ☐ OTHER (specify)

SIZE OF CASING: 6 INCHES IN DIAMETER

DEPTH OF WELL: 85 FEET DEEP

WAS ANY CASING REMOVED? ☐ YES ☒ NO
if yes, length removed, in feet:

WAS CASING RIPPED OR PERFORATED? ☐ YES ☒ NO

LOG OF SEALING MATERIAL

MATERIAL	FEET	
	FROM	TO
Portland Cement	85	0
VOLUME OF MATERIAL USED		

SIGNATURE-MASTER WELL DRILLER OR SUPERVISING SANITARIAN

LICENSE #

162 MWD/MSD/MGD
CIRCLE ONE

5-11-07
DATE