

# APPLICATION

PERCOLATION TESTING

A 516057

P \_\_\_\_\_

HOWARD COUNTY HEALTH DEPARTMENT

BUREAU OF ENVIRONMENTAL HEALTH

3525-H ELLICOTT MILLS DRIVE/ELLICOTT CITY, MARYLAND 21043

TELEPHONE: 313-2640

DISTRICT \_\_\_\_\_

DATE 10 / 5 / 01

TO: THE COUNTY HEALTH OFFICER  
ELLICOTT CITY, MARYLAND

I HEREBY APPLY FOR THE NECESSARY TEST PRIOR TO APPLICATION FOR PERMIT TO CONSTRUCT (OR RECONSTRUCT) A SEWAGE DISPOSAL SYSTEM.

PROPERTY OWNER JOHN C BEWLEY, REVOCABLE TRUST  
15359 UNION CHAPEL RD.  
ADDRESS WOODBINE MD 21797 PHONE \_\_\_\_\_

AGENT OR PROSPECTIVE BUYER GRAYSON DEV. CO. LLC. c/o KOREN DEV. CO.  
815 CENTER PARK DR. STE 104  
ADDRESS COLUMBIA MD 21045 PHONE \_\_\_\_\_

PROPERTY LOCATION:

DIVISION BEWLEY PROPERTY LOT NO. 46

ROAD AND DESCRIPTION UNION CHAPEL RD

TAX MAP 14 PARCEL # 166

SIZE OF LOT ± 1 AC TYPE BLDG. SF DWELLING  
(SINGLE FAMILY DWELLING OR COMMERCIAL)

THE SYSTEM INSTALLED UNDER THIS APPLICATION IS ACCEPTABLE ONLY UNTIL PUBLIC FACILITIES BECOME AVAILABLE. I FULLY UNDERSTAND THE

FEE CONNECTED WITH THE FILING OF THIS PERC TEST APPLICATION IS NON-REFUNDABLE UNDER ANY CIRCUMSTANCES. I ALSO AGREE TO

COMPLY WITH ALL M.O.S.H.A. REQUIREMENTS IN TESTING THIS LOT. DAVID B. YANNOY (SIGNATURE OF APPLICANT) GRAYSON DEVELOPMENT COMPANY, LLC

APPROVED BY \_\_\_\_\_ FOR \_\_\_\_\_ DATE \_\_\_\_\_

DISAPPROVED BY \_\_\_\_\_ FOR \_\_\_\_\_ DATE \_\_\_\_\_

HOLD PENDING FURTHER TESTS \_\_\_\_\_

REASONS FOR REJECTION OR HOLDING Needs Wet Season Tests

PERCOLATION TEST PLAT/PRELIMINARY PLAT - TITLE OR I.D. # \_\_\_\_\_ DATE \_\_\_\_\_

SITE DEVELOPMENT PLAN/FINAL PLAT - TITLE OR I.D. # \_\_\_\_\_ DATE \_\_\_\_\_

## THIS IS NOT A PERMIT

COUNTY #

### SOIL PROFILE

0'

182

red-  
org  
brn  
fine  
sandy  
lm

14'

183

SEE  
182


184

brown  
top soil  
org - brn  
clay lm  
org - brn  
silt lm  
org - brn  
sandy  
lm  
org - brn  
fine  
sandy lm  
No Rock

WATER

13'

NOT TO SCALE

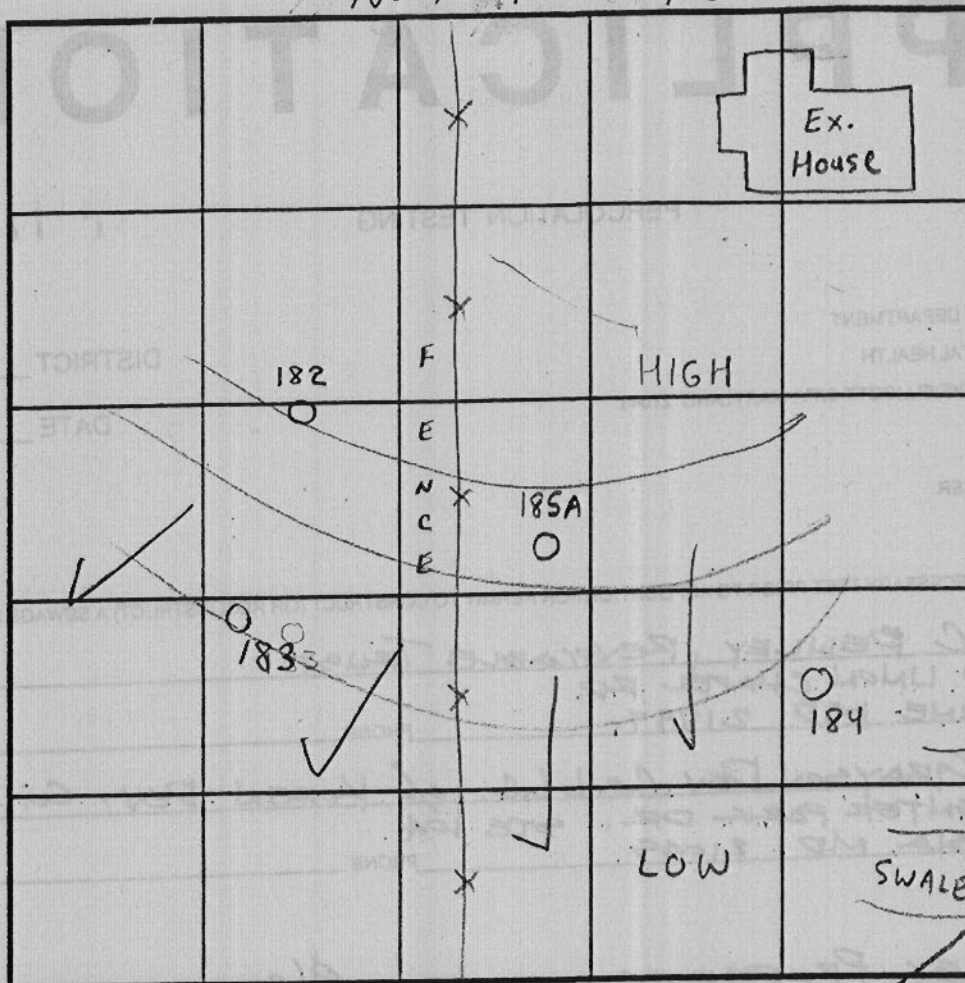

INDICATE NORTH - NAME ADJOINING ROADWAY AS BASE LINE.

### SOIL PROFILE

185A

0'

org-ben  
sitt  
lm

brown-  
tan  
powdery  
fine  
sandy  
lm

NO ROCK

119

| DATE    | TEST NO. | DEPTH        | PRE-WET     |          | TEST - 1' DROP   |      | TIME    |
|---------|----------|--------------|-------------|----------|------------------|------|---------|
|         |          |              | START       | STOP     | START            | STOP |         |
| 7/23/03 | 182      | 14'V         | (VISUAL OK) |          | SEE SOIL PROFILE | NA   | OK      |
| ↓       |          |              |             |          |                  |      |         |
|         | 183      | 14'V         | "           | "        | " "              | "    | NA OK   |
|         |          |              |             |          |                  |      |         |
| 4/22/03 | 184      | 5'T<br>106"V | 3:00        | 3:02     | 3:02             | 3:04 | 2min OK |
| ↓       |          |              |             |          |                  |      |         |
|         | 185      | NOT          | EXCLAV.     |          |                  |      |         |
|         |          |              |             |          |                  |      |         |
| ↓       | 185A     | 14'V         | (VISUAL OK) | SEE SOIL | PROFILE)         | NA   | OK      |
|         |          |              |             |          |                  |      |         |

REMARKS

TYPE OF SOIL Glenelg

TESTED BY SRK

ALSO PRESENT Todd Parks - 4/22/03  
Jeff Allen - 7/23/03

TRENCH DESIGN DATA: AVERAGE PERCOLATION TIME \_\_\_\_\_ TRENCH WIDTH \_\_\_\_\_

INLET DEPTH \_\_\_\_\_ MAXIMUM BOTTOM DEPTH \_\_\_\_\_ SQ. FT./BEDROOM \_\_\_\_\_

# APPLICATION

PERCOLATION TESTING

A 42213

P \_\_\_\_\_

HOWARD COUNTY HEALTH DEPARTMENT  
BUREAU OF ENVIRONMENTAL HEALTH  
P.O. BOX 476 ELLICOTT CITY, MARYLAND 21043  
TELEPHONE 461-9933

DISTRICT \_\_\_\_\_

DATE July 29, 1988

TO: THE COUNTY HEALTH OFFICER  
ELLICOTT CITY, MARYLAND

I, HEREBY, APPLY FOR THE NECESSARY TEST IN ORDER TO CONSTRUCT (OR RECONSTRUCT) A SEWAGE DISPOSAL SYSTEM.

check for 200'  
from STREAM

PROPERTY OWNER JOHN D. BEWLEY

ADDRESS 15359 UNION CHAPEL ROAD PHONE 489-4916  
Woodbine, md. 21797

PROSPECTIVE BUYER \_\_\_\_\_

ADDRESS \_\_\_\_\_ PHONE \_\_\_\_\_

PROPERTY LOCATION:

SUBDIVISION 15359 LOT NO. EXISTING LOT

ROAD AND DESCRIPTION UNION CHAPEL ROAD - 1 1/2 miles from Rt. 97

TAX MAP 14 PARCEL # Q 20 P/O P. 66

SIZE OF LOT \_\_\_\_\_ TYPE BLDG. \_\_\_\_\_  
(SINGLE FAMILY DWELLING OR COMMERCIAL)

THE SYSTEM INSTALLED UNDER THIS APPLICATION IS ACCEPTABLE ONLY UNTIL PUBLIC FACILITIES BECOME AVAILABLE. I FULLY UNDERSTAND THE FEE CONNECTED WITH THE FILING OF THIS PERC TEST APPLICATION IS NON-REFUNDABLE UNDER ANY CIRCUMSTANCES. I ALSO AGREE TO COMPLY WITH ALL M.O.S.H.A. REQUIREMENTS IN TESTING THIS LOT.

(SIGNATURE OF APPLICANT)

APPROVED BY \_\_\_\_\_ FOR \_\_\_\_\_ DATE \_\_\_\_\_

REJECTED BY \_\_\_\_\_ FOR \_\_\_\_\_ DATE \_\_\_\_\_



HOLD PENDING FURTHER TESTS \_\_\_\_\_ DATE \_\_\_\_\_

REASONS FOR REJECTION OR HOLDING 10-24-88 For perc hole location and plat approval. well casing should be extended 8 inches above grade if new additions are proposed of E Nadeau.

HD-216

## THIS IS NOT A PERMIT

A 42213

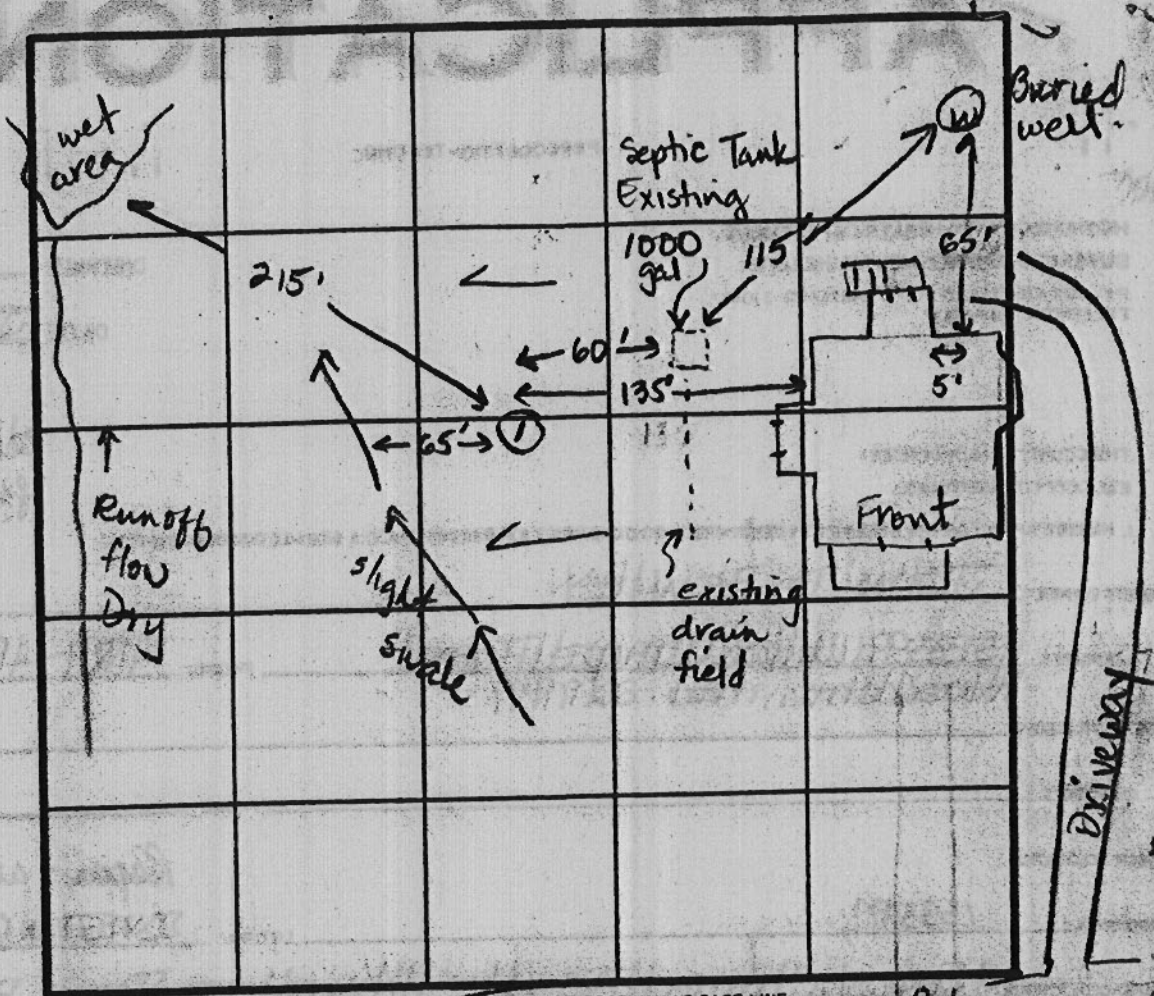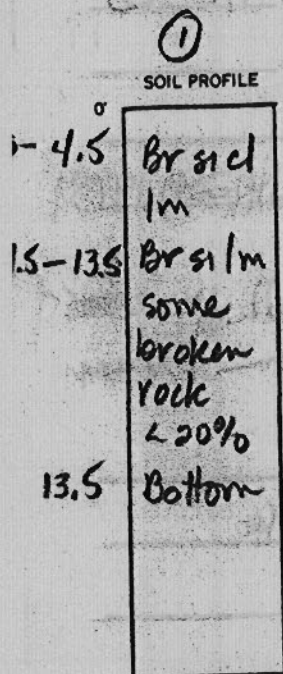

$\bar{X} = 9 \text{ min}$   
Inlet 4.0 ft  
Bottom 6.0 ft,  
210 sq ft/  
bedroom

| DATE     | TEST NO. | DEPTH  | PRE-WET              |       | TEST - 1" DROP |      | TIME  |
|----------|----------|--------|----------------------|-------|----------------|------|-------|
|          |          |        | START                | STOP  | START          | STOP |       |
| 10/24/88 | 1        | 4.5 S  | 12:49                | 12:53 | 12:53          | 1:02 | 9 min |
| ↓        |          | 13.5 D | Bottom (see profile) |       |                |      | ok    |
|          |          |        |                      |       |                |      |       |
|          |          |        |                      |       |                |      |       |
REMARKS: Existing 1000 gal tank is pumped every 2 yrs. Repair area ok.

TYPE OF SOIL: 0-4.5 Br si cl lm, 4.5-13.5 Br si lm, ≤ 20% broken rock

TESTED BY: J. E. Nadeau

ALSO PRESENT: J. Bewley

847  
2.0  
188  
94  
112  
255  
2.4  
100  
50  
257  
2.4  
108  
54  
64

*copy of signed Preliminary Plan*

WELLINGTON WEST  
SECTION 2, AREA 2, PARCEL 69  
RC-DEO

