


NOT TO SCALE

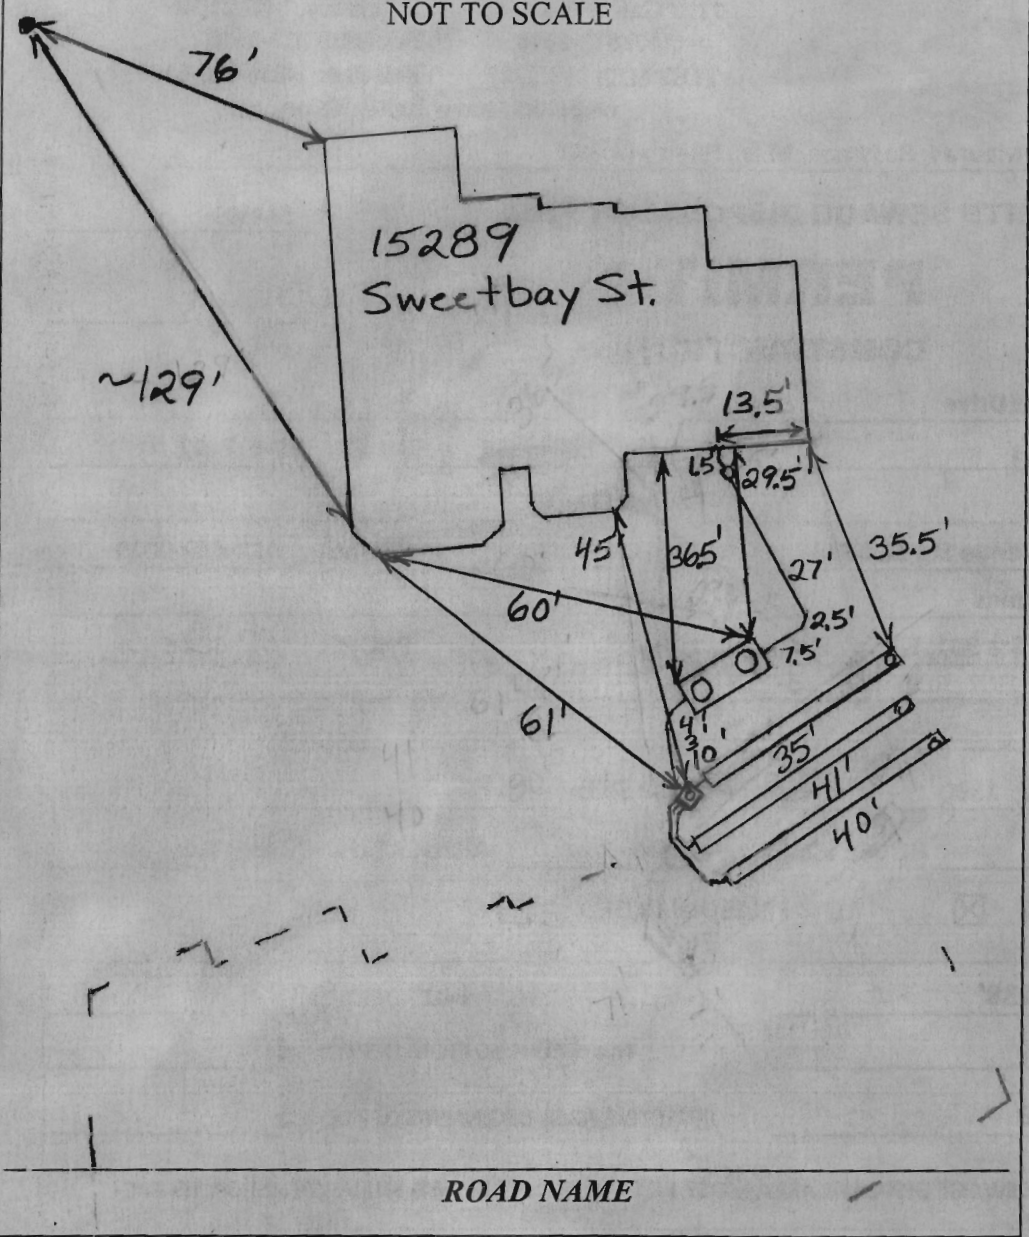

TRENCH/DRAINFIELD DATA

WIDTH	INLET	BOTTOM
3	4.5	6.5

NUMBER OF TRENCHES 3

TOTAL LENGTH 116'

ABSORPTION AREA 348 + Sidewalk

DISTRIBUTION BOX LEVEL Levelers

DISTRIBUTION BOX BAFFLE Brick

DISTRIBUTION BOX PORT Yes

SEPTIC TANK DATA

SEPTIC TANK 1 LEVEL Yes

MANUFACTURER Babylon

CAPACITY 2000 GAL

SEAM LOC Top

TANK LID DEPTH 0.5-1.5

BAFFLES Yes

BAFFLE FILTER No

MANHOLE LOC Front + Rear

6" PORT LOC None

WATERTIGHT TEST No

SLOTTED Yes

DATE ON LID Dry

PUMP/SEPTIC TANK LEVEL N/A

MANUFACTURER _____

CAPACITY _____ GAL

SEAM LOC _____

TANK LID DEPTH _____

BAFFLES _____

BAFFLE FILTER _____

MANHOLE LOC _____

6" PORT LOC _____

WATERTIGHT TEST _____

SLOTTED _____

DATE ON LID _____

PRE-CONSTRUCTION:

9/19/2013 Set the dist. box near the upper right pool setback. Install a 31, 36 + 36' trench on contour towards the northeast. (BB)


INSTALLATION: 9/25/2013 Everything finished except for plumbing from box to house and tank. (BB)

10/1/2013 System finished. O.K. to backfill. (BB)

FINAL INSPECTOR B. Baker

DATE OF APPROVAL 10/1/2013

NOT TO SCALE

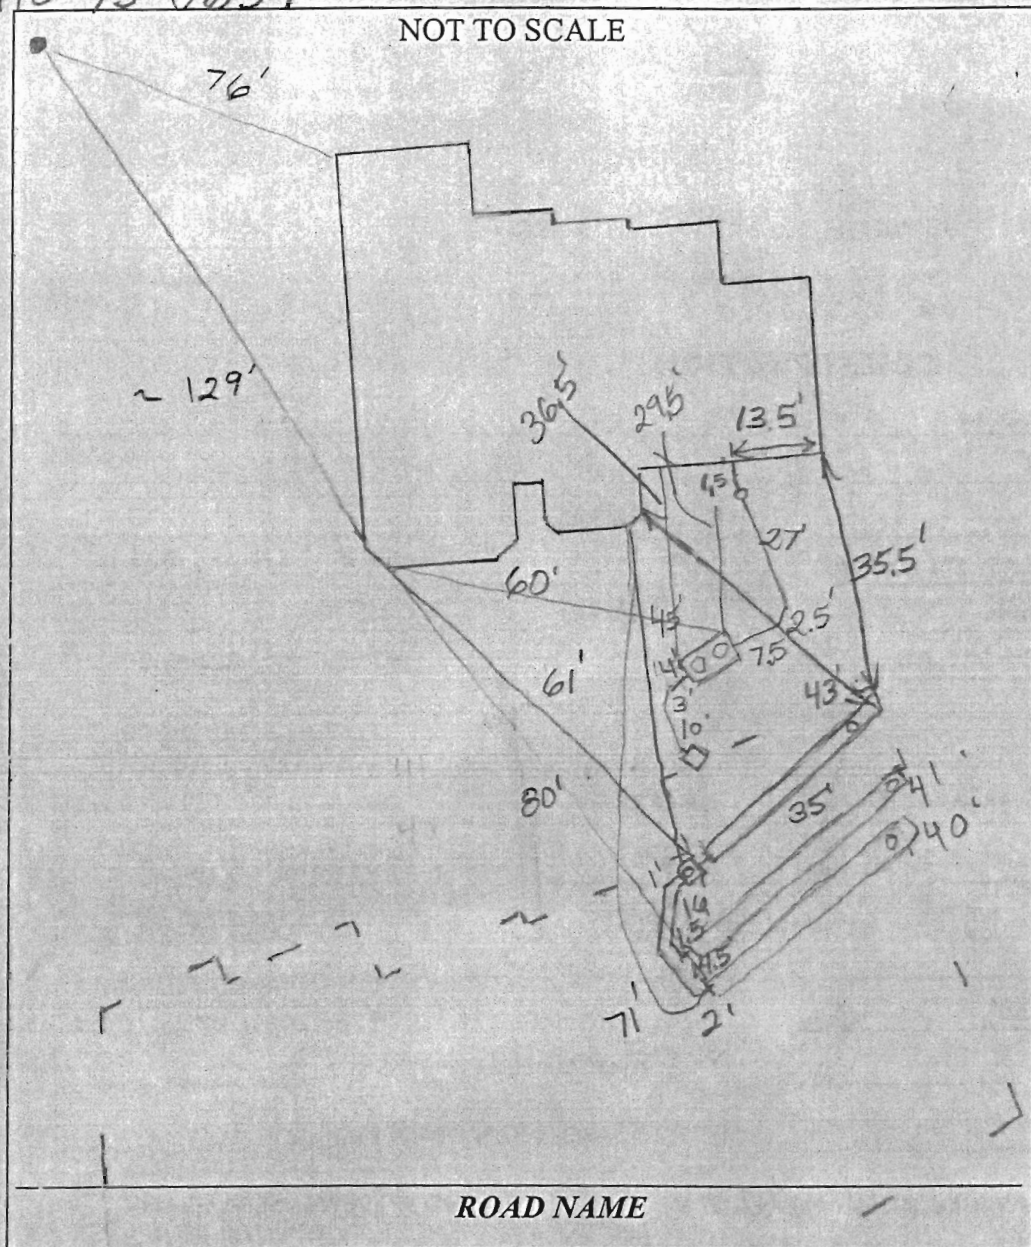

TRENCH/DRAINFIELD DATA

WIDTH	INLET	BOTTOM
3	4.5	6.5

NUMBER OF TRENCHES 3

TOTAL LENGTH 116'

ABSORPTION AREA 348+Sidewalk

DISTRIBUTION BOX LEVEL Level 1

DISTRIBUTION BOX BAFFLE Brick

DISTRIBUTION BOX PORT Yes

SEPTIC TANK DATA

SEPTIC TANK 1 LEVEL Yes

MANUFACTURER Babylon

CAPACITY 2000 GAL

SEAM LOC TOPTANK LID DEPTH 0.5-1.5BAFFLES YesBAFFLE FILTER NoMANHOLE LOC. Front + Rear

6" PORT LOC None

WATERTIGHT TEST No

SLOTTED Yes

DATE ON LID DFV

PUMP/SEPTIC TANK LEVEL N/A

MANUFACTURER

CAPACITY _____ GAL

SEAM LOC _____

TANK LID DEPTH BAFFLES

BAFFLE FILTER

MANHOLE LOC _____

6" PORT LÖC _____

WATERTIGHT TEST _____

SLOTTED _____

DATE ON LID _____

PRE-CONSTRUCTION:

PRE-CONSTRUCTION:
9/19/2013 Set the dist. box near the upper right pool setback. Install a 31, 36 + 36' trench on contour towards the northeast. (BIB)

INSTALLATION:

INSTALLATION: 9/25/2013 Everything finished except for plumbing from box to house and tank. (BB)


9/27/2013 System finished O.K to backfill. BB


FINAL INSPECTOR

B. Baker

DATE OF APPROVAL

9/27/2013

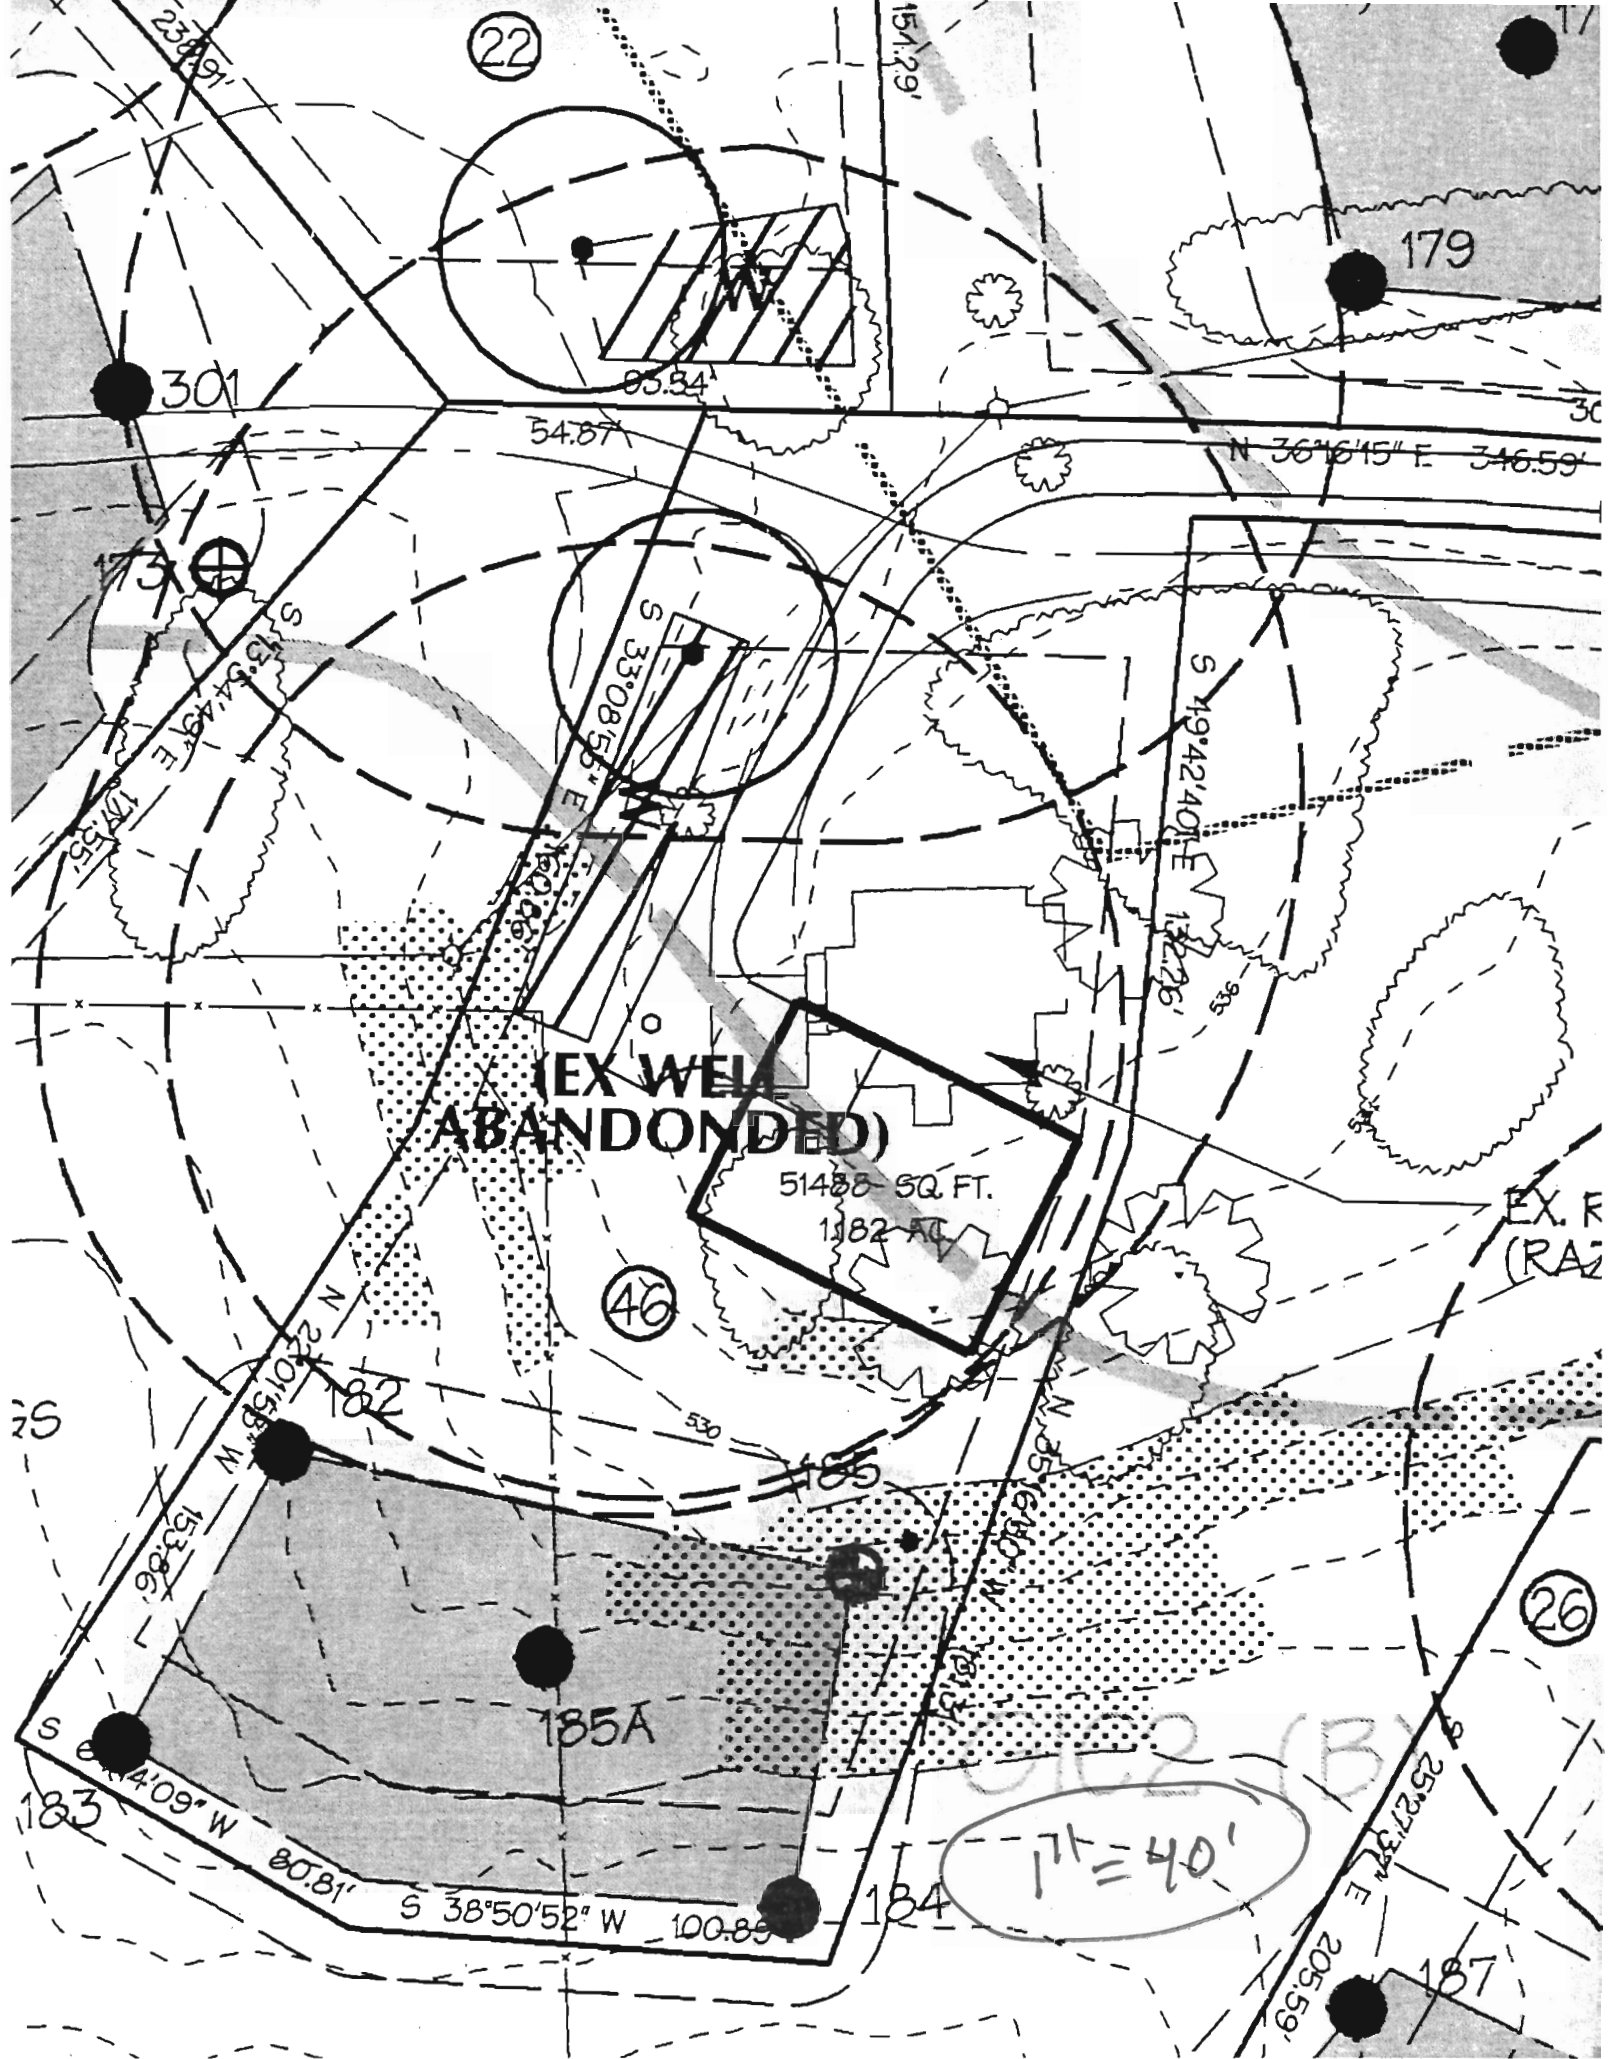

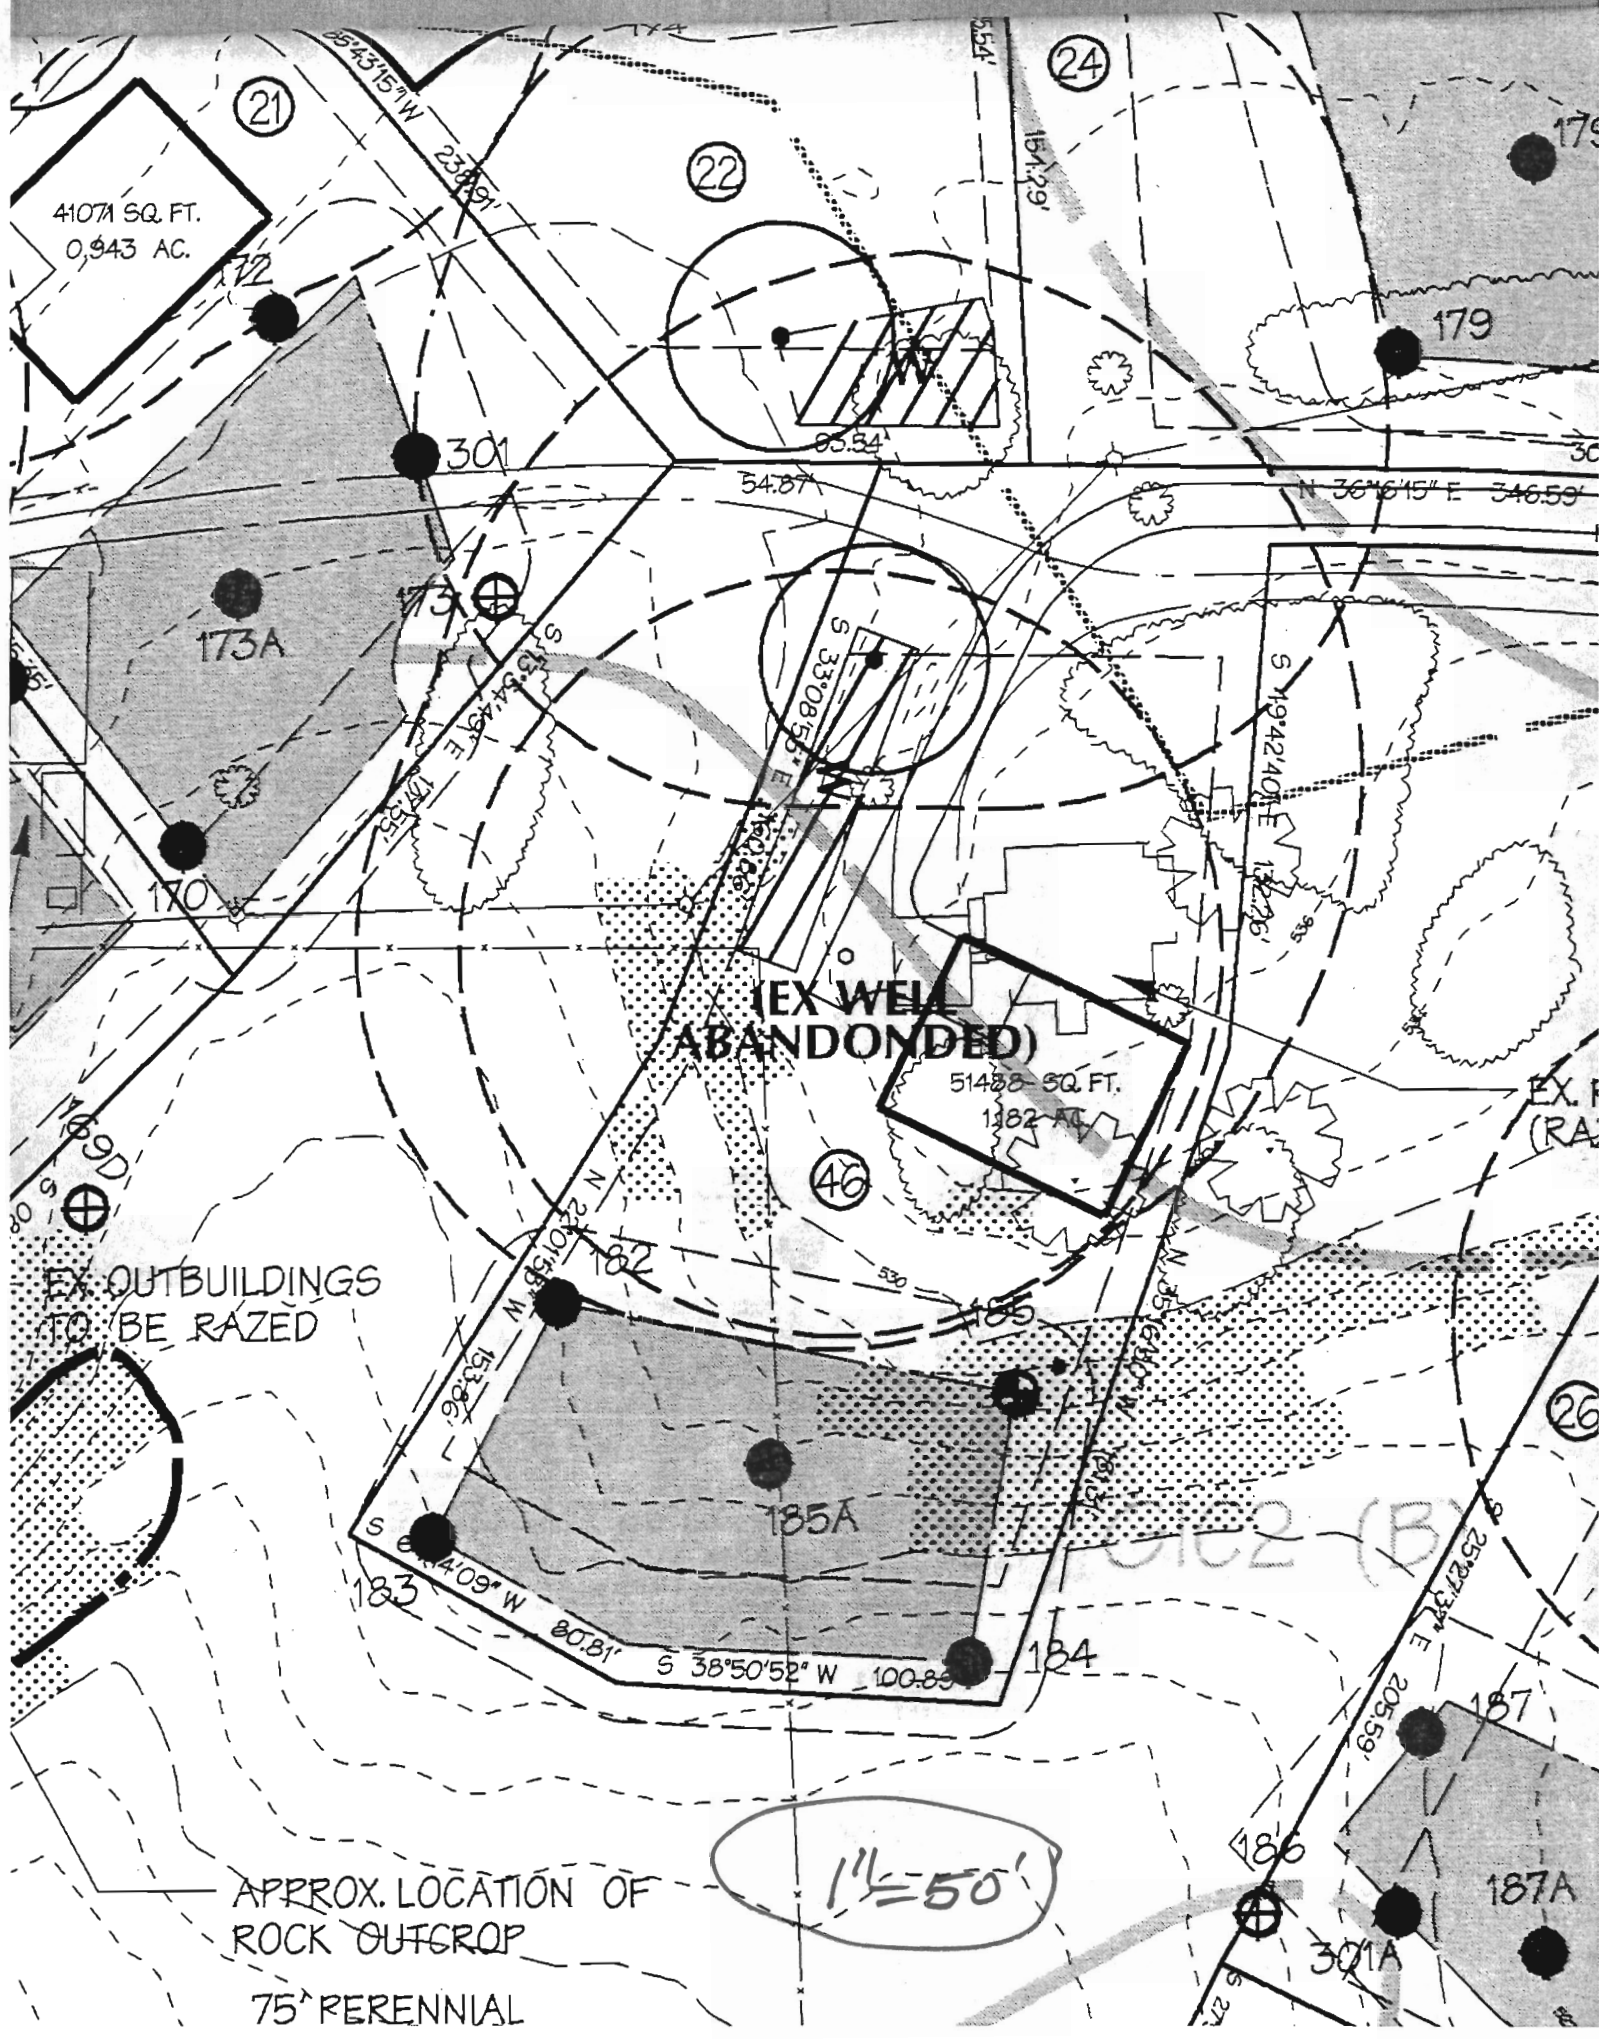

41071 SQ. FT.
0.943 AC.

(EX WELL
ABANDONED)

51488 SQ. FT.
1382 AC.

EX OUTBUILDINGS
TO BE RAZED

APPROX. LOCATION OF
ROCK OUTCROP

75' PERENNIAL

1" = 50'

Click here for a plain text ADA compliant screen.



Maryland Department of Assessments and Taxation
HOWARD COUNTY
Real Property Data Search

[Go Back](#)
[View Map](#)
[New Search](#)

STR

Account Identifier: District - 04 Account Number - 309804

Owner Information

Owner Name: BEWLEY JOHN C
BEWLEY GEORGE E
Use: AGRICULTURAL
Principal Residence: YES
Mailing Address: 15359 UNION CHAPEL RD
WOODBINE MD 21797-7717
Deed Reference: 1) / 2785/ 395
2)

Location & Structure Information

Premises Address			Zoning		Legal Description				
15359 S UNION CHAPEL RD WOODBINE 21797			RCDEO		98.0318 A 15359 UNION CHAPEL RD WOODBINE				
Map	Grid	Parcel	Sub District	Subdivision	Section	Block	Lot	Group	Plat No: Plat Ref:
14	20	66						81	
Special Tax Areas			Town Ad Valorem Tax Class	NO A/V, NO M/P, RURAL FIRE TAX					
Primary Structure Built			Enclosed Area	Property Land Area		County Use			
1925			3,229 SF	98.03 AC					
Stories		Basement	Type		Exterior				
2 1/2		NO	STANDARD UNIT		ASBESTOS SHINGLE				

Value Information

	Base Value	Value As Of 01/01/2002	Phase-in Assessments As Of 07/01/2002	As Of 07/01/2003	
Land:	114,560	134,560			PREFERENTIAL LAND VALUE INCLUDED IN LAND VALUE
Improvements:	98,770	135,640			
Total:	213,330	270,200	232,286	251,242	
Preferential Land:	34,560	34,560	34,560	34,560	

Transfer Information

Seller: BEWLEY JOHN D	Date: 02/03/1993	Price: \$0
Type: NOT ARMS-LENGTH	Deed1: / 2785/ 395	Deed2:
Seller:	Date:	Price:
Type:	Deed1:	Deed2:
Seller:	Date:	Price:
Type:	Deed1:	Deed2:

Exemption Information

Partial Exempt Assessments	Class	07/01/2002	07/01/2003
County	000	0	0
State	000	0	0
Municipal	000	0	0


Tax Exempt: NO
Exempt Class:

Special Tax Recapture:
AGRICULTURAL TRANSFER TAX

P515023

5349

NOT TO SCALE

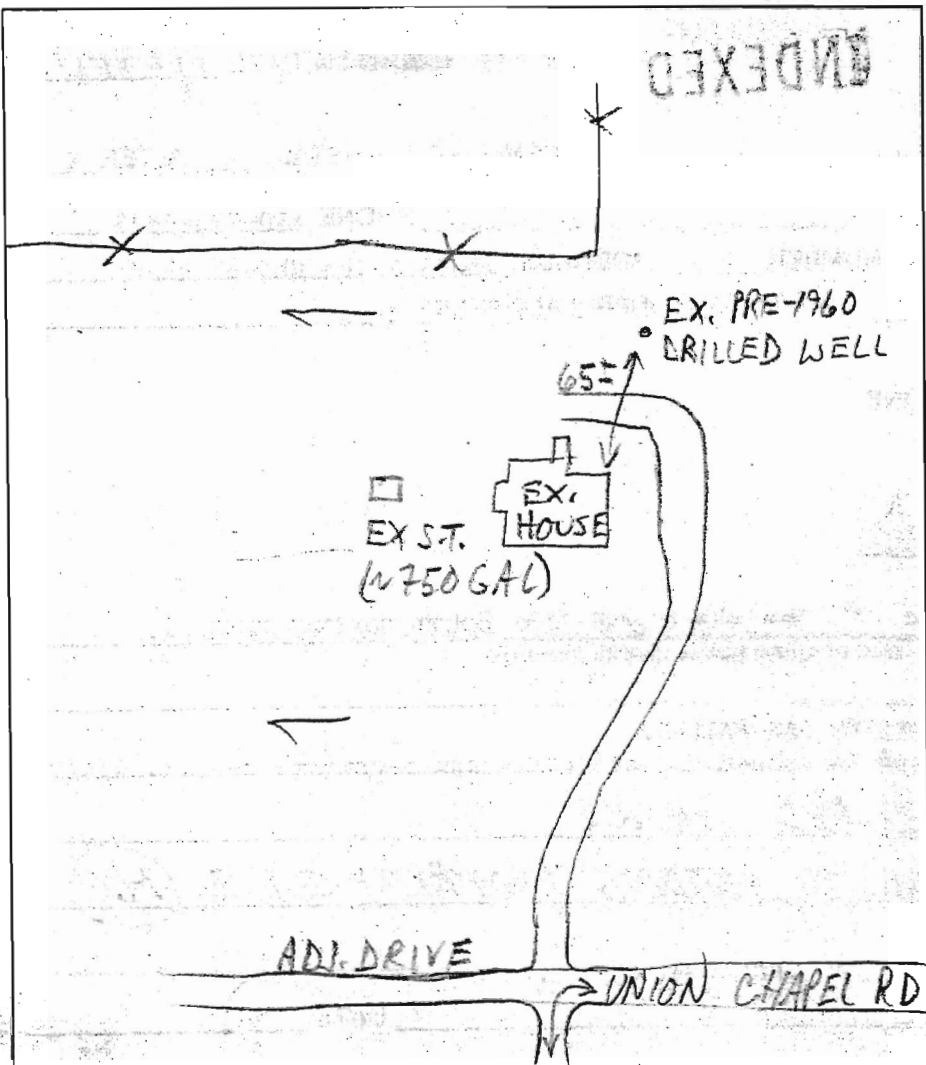

TRENCH DATA

TRENCH WIDTH _____

TRENCH INLET DEPTH _____

TRENCH BOTTOM DEPTH _____

DEPTH OF STONE _____

NUMBER OF TRENCHES _____

TOTAL TRENCH LENGTH _____

ABSORBENT AREA _____

DISTRIBUTION BOX LEVEL _____

BAFFLE IN DISTRIBUTION BOX _____

SEPTIC TANK DATA

SEPTIC TANK _____ GALLONS

MANHOLE RISER _____

6 INCH INSPECTION PORT _____

PUMP CHAMBER DATA

PUMP CHAMBER
GALLONS _____

MANHOLE RISER _____

ALARM _____

PUMP PERFORMANCE TEST _____

PRE-CONSTRUCTION INSPECTION: _____

INSPECTION COMMENTS: 7/26/01 UNSCHEDULED SITE INSP: OWNER
REPORTS HOUSE SEWER LINE REPLACED; NO DISCH OBS'D
TODAY, FILE CLOSED (MR)

INSPECTOR _____

DATE SYSTEM APPROVED _____