



Building Permit Application

Howard County Maryland
Department of Inspections, Licenses and Permits
3430 Court House Drive
Permits: 410-313-2455
www.howardcountymd.gov

Date Received: _____

Permit No.: _____

Building Address: 2650 Winfield Rd
City: West Friendship State: MD Zip Code: 21794
Suite/Apt. #: _____ SDP/WP/BA #: _____
Census Tract: _____ Subdivision: _____
Section: _____ Area: _____ Lot: _____
Tax Map: _____ Parcel: _____ Grid: _____
Zoning: _____ Map Coordinates: _____ Lot Size: _____

Existing Use: _____
Proposed Use: Storage for lawn equipment
Estimated Construction Cost: \$ 18,000.00
Description of Work: pour a concrete slab (14 x 32), build a shed

Occupant or Tenant: N/A
Was tenant space previously occupied? ☐ Yes ☐ No
Contact Name: _____
Address: _____
City: _____ State: _____ Zip Code: _____
Phone: _____ Fax: _____
Email: _____

| Commercial Building Characteristics | Residential Building Characteristics |
|--|--|
| Height: _____ | <input type="checkbox"/> SF Dwelling <input type="checkbox"/> SF Townhouse |
| No. of stories: _____ | Depth _____ Width _____ |
| Gross area, sq. ft./floor: _____ | 1 st floor: _____ |
| Area of construction (sq. ft.): _____ | 2 nd floor: _____ |
| Use group: _____ | Basement: _____ |
| | <input type="checkbox"/> Finished Basement |
| | <input type="checkbox"/> Unfinished Basement |
| | <input type="checkbox"/> Crawl Space |
| Construction type: | <input type="checkbox"/> Slab on Grade |
| <input type="checkbox"/> Reinforced Concrete | No. of Bedrooms: _____ |
| <input type="checkbox"/> Structural Steel | Multi-family Dwelling |
| <input type="checkbox"/> Masonry | No. of efficiency units: _____ |
| <input type="checkbox"/> Wood Frame | No. of 1 BR units: _____ |
| <input type="checkbox"/> State Certified Modular | No. of 2 BR units: _____ |
| | No. of 3 BR units: _____ |
| | Other Structure: _____ |
| | Dimensions: _____ |
| > Roadside Tree Project Permit | Footings: _____ |
| <input type="checkbox"/> Yes <input type="checkbox"/> No | Roof: _____ |
| Roadside Tree Project Permit # | <input type="checkbox"/> State Certified Modular |
| | <input type="checkbox"/> Manufactured Home |

Property Owner's Name: Charles & Kelli Moses
Address: 2650 Winfield Rd
City: West Friendship State: MD Zip Code: 21794
Phone: _____ Fax: _____
Email: chuck@jackson.org

Applicant's Name & Mailing Address, (If other than stated herein)
Applicant's Name: Surewood Builders
Address: 4267 Arthur Shipley Rd
City: Westminster State: MD Zip Code: 21157
Phone: 410-913-0834 Fax: _____
Email: ginger@surewoodbuilders.com

Contractor Company: Surewood Builders
Contact Person: Mark Cavallaro
Address: 4267 Arthur Shipley Rd
City: Westminster State: MD Zip Code: 21157
License No.: 104343
Phone: 410-913-0834 Fax: N/A
Email: markcavallaro@comcast.net

Engineer/Architect Company: G.B.L. Custom Homes
Responsible Design Prof.: Greg Little
Address: PO Box 237
City: Finksburg State: MD Zip Code: 21048
Phone: 410-839-8324 Fax: _____
Email: gblphh@99is.net

| Utilities |
|---|
| Water Supply |
| <input type="checkbox"/> Public |
| <input type="checkbox"/> Private |
| Sewage Disposal |
| <input type="checkbox"/> Public |
| <input type="checkbox"/> Private |
| Electric: <input type="checkbox"/> Yes <input type="checkbox"/> No |
| Gas: <input type="checkbox"/> Yes <input type="checkbox"/> No |
| Heating System |
| <input type="checkbox"/> Electric <input type="checkbox"/> Oil |
| <input type="checkbox"/> Natural Gas <input type="checkbox"/> Propane Gas |
| <input type="checkbox"/> Other: _____ |
| Sprinkler System: |
| <input type="checkbox"/> Yes <input type="checkbox"/> No |
| Grading Permit Number: |
| Building Shell Permit Number: |

THE UNDERSIGNED HEREBY CERTIFIES AND AGREES AS FOLLOWS: (1) THAT HE/SHE IS AUTHORIZED TO MAKE THIS APPLICATION; (2) THAT THE INFORMATION IS CORRECT; (3) THAT HE/SHE WILL COMPLY WITH ALL REGULATIONS OF HOWARD COUNTY WHICH ARE APPLICABLE THERETO; (4) THAT HE/SHE WILL PERFORM NO WORK ON THE ABOVE REFERENCED PROPERTY NOT SPECIFICALLY DESCRIBED IN THIS APPLICATION; (5) THAT HE/SHE GRANTS COUNTY OFFICIALS THE RIGHT TO ENTER ONTO THIS PROPERTY FOR THE PURPOSE OF INSPECTING THE WORK PERMITTED AND POSTING NOTICES.

Applicant's Signature: Ginger B. Little Print Name: Virginia B. Little
Email Address: ginger@surewoodbuilders.com Date: 9/17/13
Title/Company: Surewood

Checks Payable to: DIRECTOR OF FINANCE OF HOWARD COUNTY

PLEASE WRITE NEATLY & LEGIBLY
-FOR OFFICE USE ONLY-

| AGENCY | DATE | SIGNATURE OF APPROVAL |
|--------------------|------|-------------------------|
| State Highways | | |
| Building Officials | | |
| PSZA (Zoning) | | |
| PSZA (Engineering) | | |
| Health | | <u>1/19 B. R. Rieck</u> |

Is Sediment Control approval required for issuance? ☐ Yes ☐ No
☐ CONTINGENCY CONSTRUCTION START

| DPZ SETBACK INFORMATION |
|---|
| Front: _____ |
| Rear: _____ |
| Side: _____ |
| Side St.: _____ |
| All minimum setbacks met? <input type="checkbox"/> Yes <input type="checkbox"/> No |
| Is Entrance Permit Required? <input type="checkbox"/> Yes <input type="checkbox"/> No |
| Historic District? <input type="checkbox"/> Yes <input type="checkbox"/> No |
| Lot Coverage for New Town Zone: _____ |
| SDP/Red-line approval date: _____ |

| | |
|----------------|----|
| Filing Fee | \$ |
| Permit Fee | \$ |
| Tech Fee | \$ |
| Excise Tax | \$ |
| PSFS | \$ |
| Guaranty Fund | \$ |
| Add'l per Fee | \$ |
| Total Fees | \$ |
| Sub-Total Paid | \$ |
| Balance Due | \$ |
| Check | # |

Distribution of Copies: White: Building Officials Green: PSZA, Zoning Yellow: PSZA, Engineering Pink: Health Gold: SHA

N43° 21' 56" E 170.33

LOT 1 (5457) FINAL PLAT
SECTION 2 "WYNFIELD"
LOTS No 1 THRU No 15
SHEET 1 of 3
3RD ELECT. DIST HOWARD CO. MD

BUILDING RESTRICTION
LINE

N67° 00' 00" W

APPROVED

WALK-THRU BUILDING PERMIT


BP#

A#

R. Buckner DATE 9/9/13
14' x 32' Addition pushed
on concrete slab.

* MALADAM DRIVE
APPEARS TO PARTIALLY
CROSS PROPERTY LINE.

N50° 00' 00" W

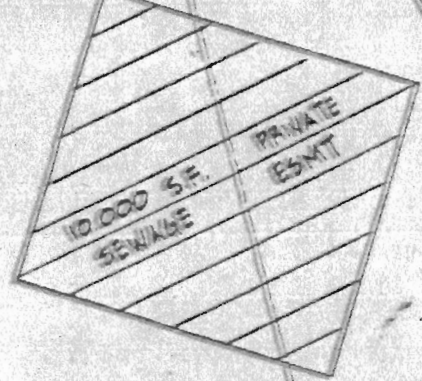

WOOD STEPS
WOOD PATIO
WOOD PORCH
BRICK WALK
WOOD STEPS
WOOD PATIO
WOOD PORCH
BRICK WALK

SEPTIC

#2650 Wynfield Road

BUILDING RESTRICTION
LINE

* MALADAM DRIVE

BAY WINDOW
BRICK PORCH
BRICK WALK

261.26

WYNFIELD ROAD
(~ 50' R/W)