

Building Permit Application

Howard County Maryland
Department of Inspections, Licenses and Permits
3430 Court House Drive
Permits: 410-313-2455
www.howardcountymd.gov

Date Received: 1-22-14

Permit No.: B14000215

Building Add s: 11821 Triadelphia Rd.
City: Ellicott City State: MD Zip Code: 21042
Suite/Apt. #: SDP/WP/BA #:
Census Tract: Subdivision:
Section: Area: Lot:
Tax Map: 16 Parcel: 229 Grid: 0020
Zoning: Map Coordinates: Lot Size: 42,411 SF

Existing Use: Residential
Proposed Use:
Estimated Construction Cost: \$ 750
Description of Work: Set 100 gallon propane tank & run line to stub out

Occupant or Tenant: Jack & Bridgette Cromrine
Was tenant space previously occupied? ☒ Yes ☐ No
Contact Name:
Address:
City: State: Zip Code:
Phone: Fax:
Email:

Commercial Building Characteristics	Residential Building Characteristics
Height:	☐ SF Dwelling ☐ SF Townhouse
No. of stories:	Depth Width
Gross area, sq. ft./floor:	1 st floor:
	2 nd floor:
Area of construction (sq. ft.):	Basement:
	☐ Finished Basement
Use group:	☐ Unfinished Basement
	☐ Crawl Space
Construction type:	☐ Slab on Grade
☐ Reinforced Concrete	No. of Bedrooms:
☐ Structural Steel	Multi-family Dwelling
☐ Masonry	No. of efficiency units:
☐ Wood Frame	No. of 1 BR units:
☐ State Certified Modular	No. of 2 BR units:
	No. of 3 BR units:
	Other Structure:
	Dimensions:
> Roadside Tree Project Permit	Footings:
☐ Yes ☐ No	Roof:
Roadside Tree Project Permit #	☐ State Certified Modular
	☐ Manufactured Home

Property Owner's Name: Jack & Bridgette Cromrine
Address: 11821 Triadelphia Rd.
City: Ellicott City State: MD Zip Code: 21042
Phone: Fax:
Email:

Applicant's Name & Mailing Address, (if other than stated herein)
Applicant's Name: Steve Dannenfeldt
Address: 8088B Liberty Rd.
City: Frederick State: MD Zip Code: 21701
Phone: 717-577-5713 Fax: 717-624-5835
Email: sdannenfeldt@aeroenergy.com

Contractor Company: Aero Energy
Contact Person: Steve Dannenfeldt
Address:
City: State: Zip Code:
License No.: 20100079809
Phone: 1-800-918-4311 Fax: 717-624-5835
Email: sdannenfeldt@aeroenergy.com

Engineer/Architect Company:
Responsible Design Prof.:
Address:
City: State: Zip Code:
Phone: Fax:
Email:

Utilities
Water Supply
☐ Public
☒ Private
Sewage Disposal
☐ Public
☒ Private
Electric: ☐ Yes ☐ No
Gas: ☐ Yes ☐ No
Heating System
☐ Electric ☐ Oil
☐ Natural Gas ☐ Propane Gas
Other: ☐
Sprinkler System:
☐ Yes ☐ No
Grading Permit Number:
Building Shell Permit Number:

THE UNDERSIGNED HEREBY CERTIFIES AND AGREES AS FOLLOWS: (1) THAT HE/SHE IS AUTHORIZED TO MAKE THIS APPLICATION; (2) THAT THE INFORMATION IS CORRECT; (3) THAT HE/SHE WILL COMPLY WITH ALL REGULATIONS OF HOWARD COUNTY WHICH ARE APPLICABLE THERETO; (4) THAT HE/SHE WILL PERFORM NO WORK ON THE ABOVE REFERENCED PROPERTY NOT SPECIFICALLY DESCRIBED IN THIS APPLICATION; (5) THAT HE/SHE GRANTS COUNTY OFFICIALS THE RIGHT TO ENTER ONTO THIS PROPERTY FOR THE PURPOSE OF INSPECTING THE WORK PERMITTED AND POSTING NOTICES.

Applicant's Signature: Steve Dannenfeldt
Email Address: sdannenfeldt@aeroenergy.com
Title/Company: Sales/Aeroenergy.com

Print Name: Steve Dannenfeldt
Date: 1-9-14

Checks Payable to: DIRECTOR OF FINANCE OF HOWARD COUNTY
PLEASE WRITE NEATLY & LEGIBLY
-FOR OFFICE USE ONLY-

AGENCY	DATE	SIGNATURE OF APPROVAL
State Highways		
Building Officials		
PSZA (Zoning)		
PSZA (Engineering)		
Health	2/3/14	Andrew Vent
Is Sediment Control approval required for issuance? ☐ Yes ☐ No		
☐ CONTINGENCY CONSTRUCTION START		

DPZ SETBACK INFORMATION
Front:
Rear:
Side:
Side St:
All minimum setbacks met? ☐ Yes ☐ No
Is Entrance Permit Required? ☐ Yes ☐ No
Historic District? ☐ Yes ☐ No
Lot Coverage for New Town Zone:
SDP/Red-line approval date:

Filing Fee	\$
Permit Fee	\$
Tech Fee	\$
Excise Tax	\$
PSFS	\$
Guaranty Fund	\$
Add'l per Fee	\$
Total Fees	\$
Sub-Total Paid	\$
Balance Due	\$
Check	\$ 1022

Distribution of Copies: White: Building Officials Green: PSZA,Zoning

Yellow: PSZA,Engineering

Pink: Health


Gold: SBA

T:\Operations\Updated Forms\Building applmp 8.2012.docx

mailed in 1/22/14

SECTION TWO: EVERGREEN VALLEY ESTATES
 5000 ELECTION DISTRICT HOBBINS CO MD
 PLAT. BOOK 9 FOLIO 215
 11821 TRIMORPHIA ROAD

TRIMORPHIA ROAD

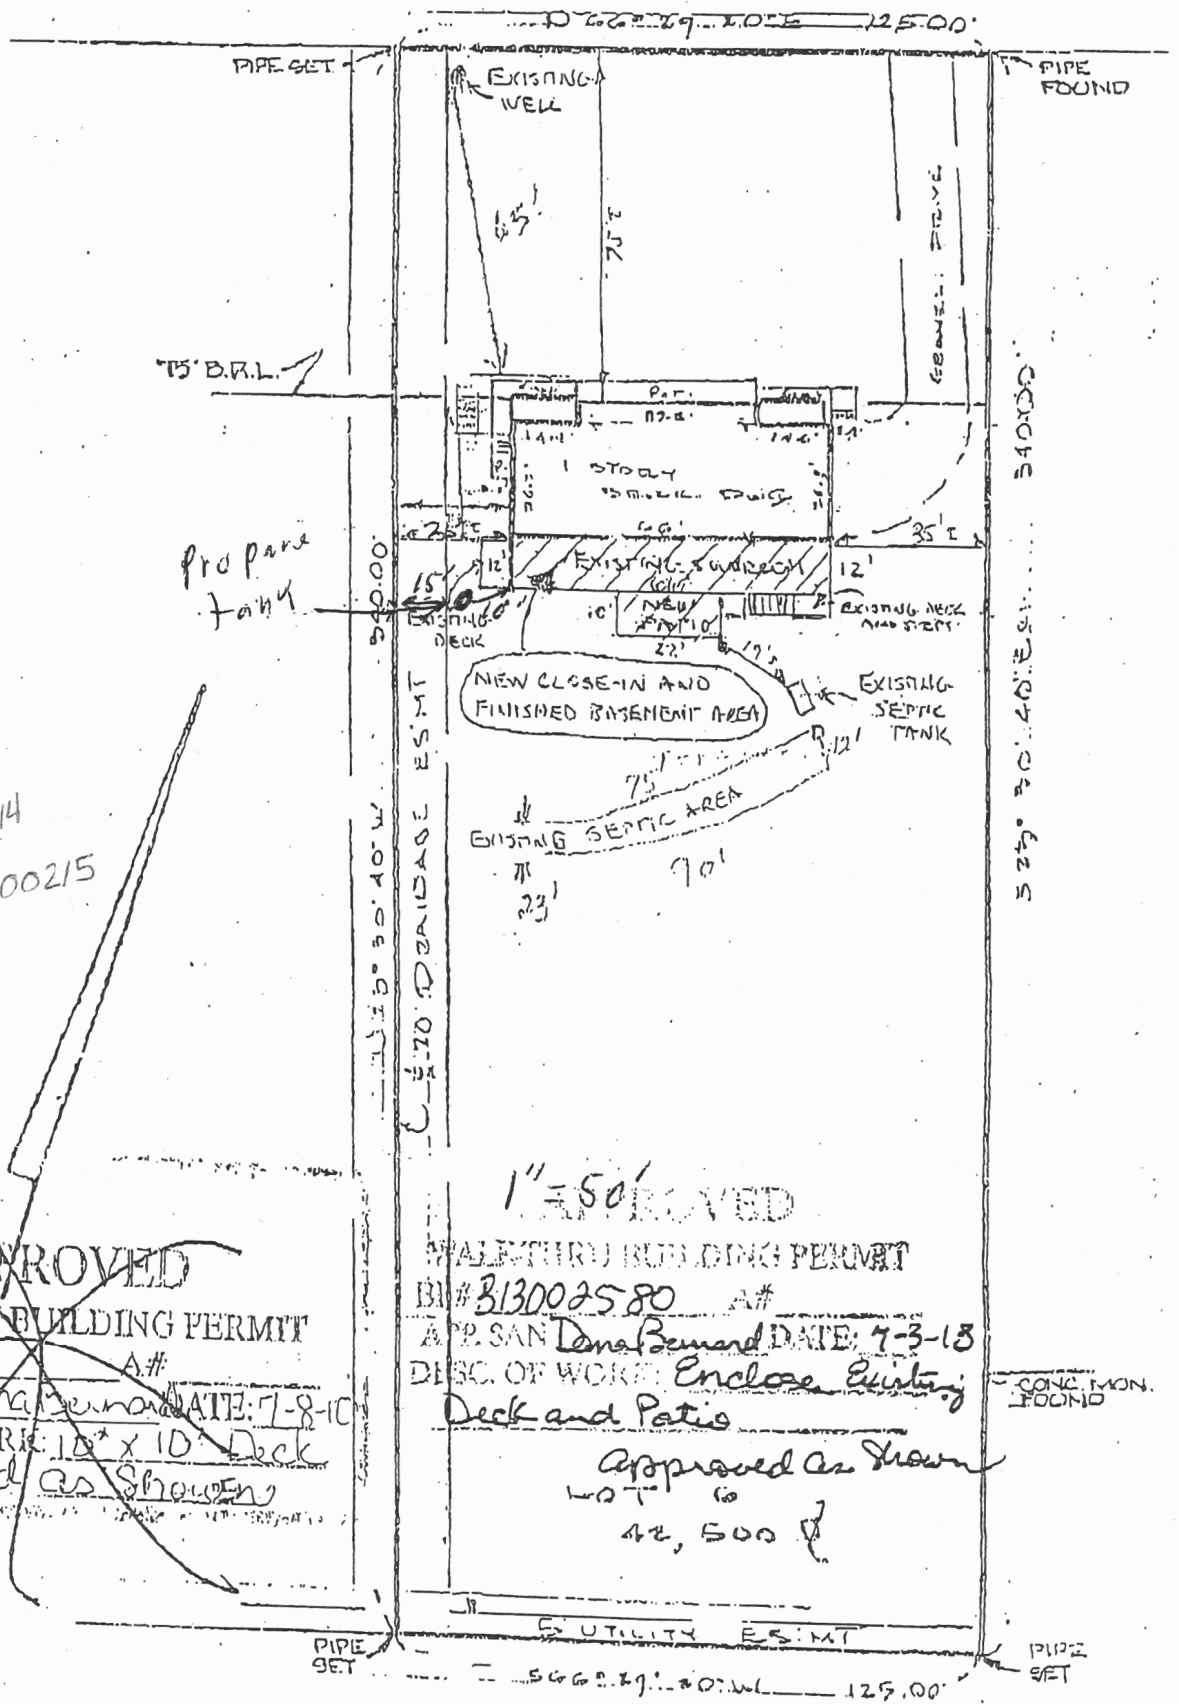


x
 Proposed tank location
 OK. AG 2/3/14
 Permit # B14000215

APPROVED
 WALK-THRU BUILDING PERMIT
 BP# _____ A# _____
 APP. SAN DONA BERNARD DATE: 7-8-10
 DESC. OF WORK: 10' x 10' Deck
 * Approved as Shown

APPROVED
 WALK-THRU BUILDING PERMIT
 BP# 313002580 A# _____
 APP. SAN DONA BERNARD DATE: 7-3-18
 DESC. OF WORK: Enclose Existing Deck and Patio
 Approved as Shown
 LOT 10
 42,500 sq

SECTION TWO: EVERGREEN VALLEY ESTATES
 9000 ELECTION DISTRICT HOWARD CO MD
 PLAT BOOK 9 FOLIO 215
 11821 TRIMORPHIA ROAD

TRIMORPHIA ROAD

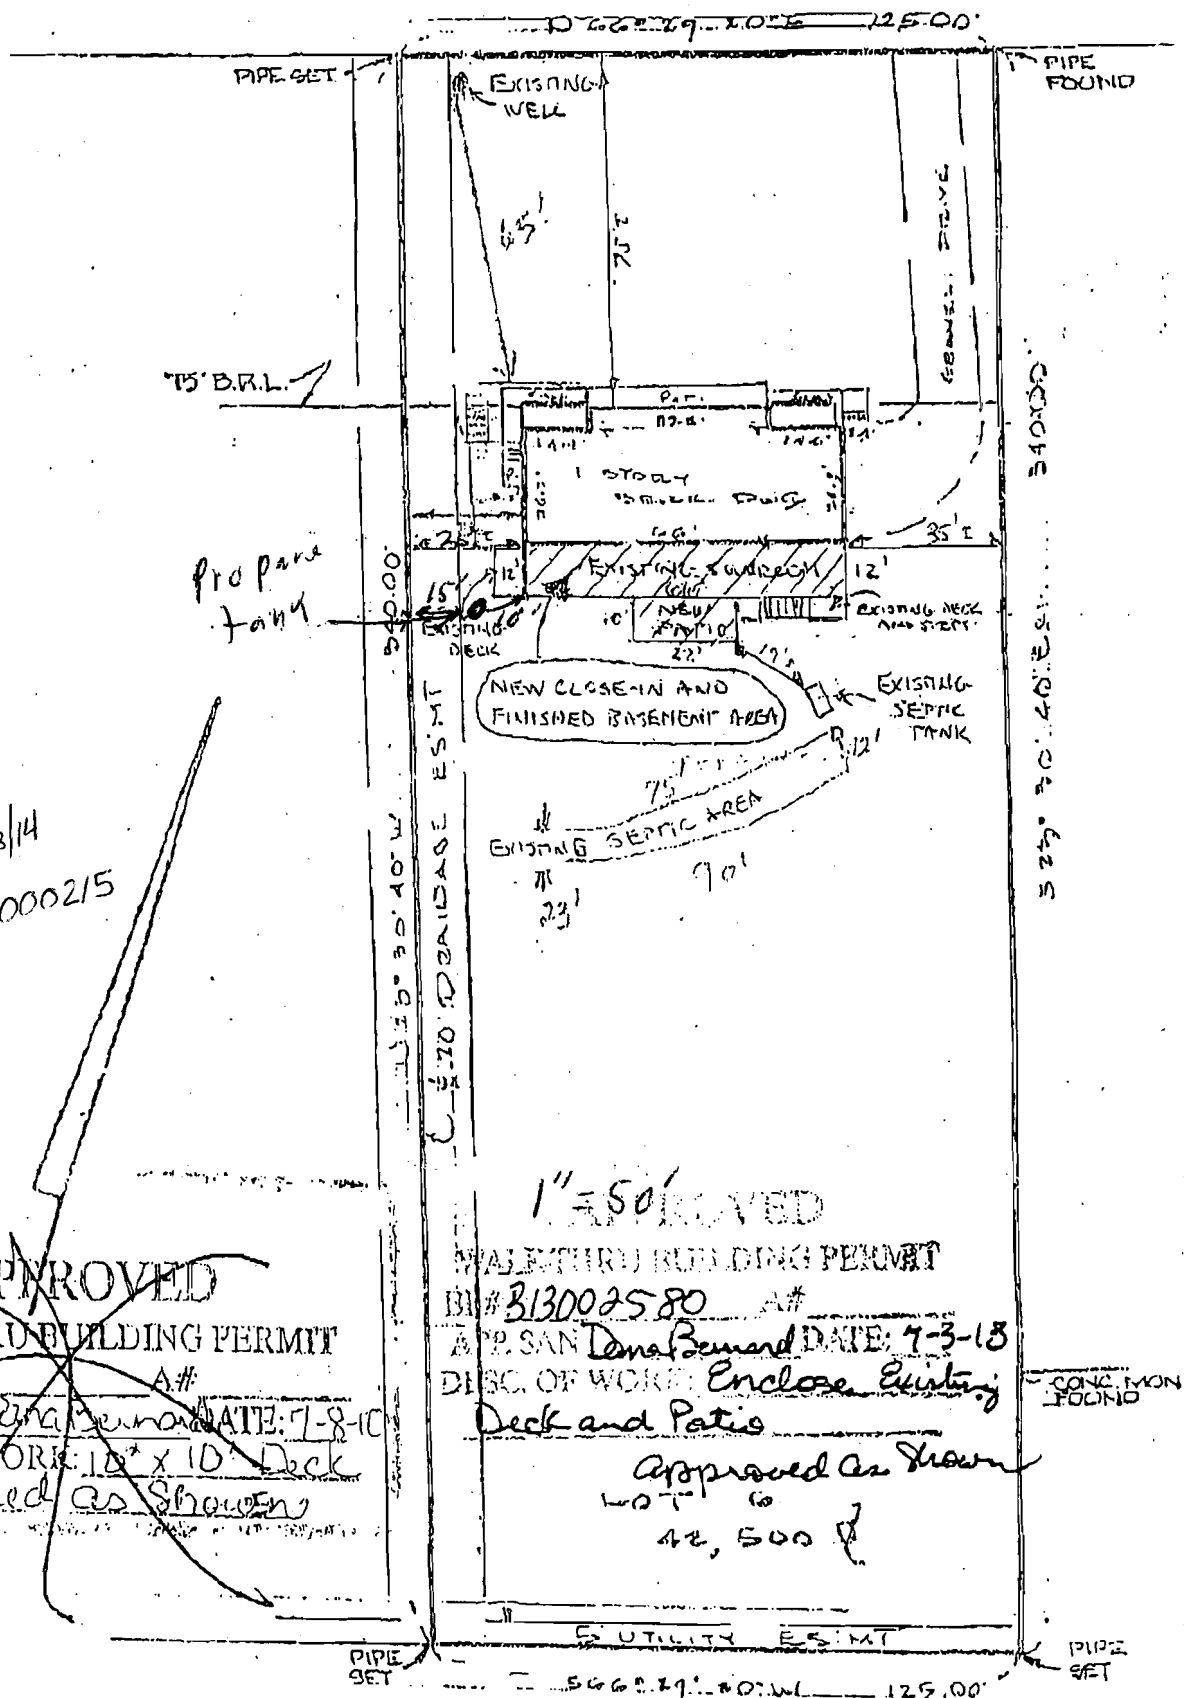

Proposed tank location
 OK. AG 2/3/14
 Permit # B14000215

~~APPROVED~~
 WALK-THRU BUILDING PERMIT
 BP# _____ A# _____
 APP. SAN DONA BERNARD DATE: 7-8-10
 DESC. OF WORK: 10' x 10' Deck
 *Approved as Shown

1"=50'
 APPROVED
 WALK-THRU BUILDING PERMIT
 BP# 313002580 A# _____
 APP. SAN DONA BERNARD DATE: 7-3-18
 DESC. OF WORK: Enclose Existing Deck and Patio
 Approved as Shown
 LOT 6
 42,500 sq ft