

DEPT. OF INSPECTIONS, LICENSES AND PERMITS
1430 COURT HOUSE DRIVE
ELLCOTT CITY, MD 21043
PERMITS (410) 313-2455
INSPECTIONS (410) 313-1810
AUTOMATED INFORMATION (410) 313-1800

HOWARD COUNTY
PERMIT APPLICATION

PERMIT NUMBER

Building Address 13925 WAYSIDE DR
C/HA SUIKE MD 21029

Suite/Apt. #: _____ SDP/WP/Petition #: _____

Census Tract _____ Subdivision _____

Section _____ Area _____ Lot _____

Tax Map _____ Parcel _____ Grid _____

Zoning _____ Map Coordinates _____ Lot Size _____

Existing Use _____

Proposed Use _____

Estimated Construction Cost \$ 1500.00

Description of Work Build stair case on existing

deck

Occupant or Tenant Rita R.A

Contact Name _____

Address 13925 WAYSIDE DR

City CHESAULT State MD Zip Code 21029

Phone 301-538-7155 Fax _____

Property Owner's Name Rita R.A

Address 13925 WAYSIDE DR

City CHESAULT State MD Zip Code 21029

Home Phone 301-538-7155 Work Phone N/A

Applicant's Name & Mailing Address, (if other than stated herein):

Scott Mitchell

4995 Threshfield Ct Ellicott City Md. 21043

Phone 301-237-0365 Fax _____

Contractor Company Renew Home Improvements

Contact Person Scott Mitchell

Address 4995 Threshfield Ct

City CHESAULT State MD Zip Code 21043

License No. 93580

Phone 301-237-0365 Fax _____

Engineer or Architect Company _____

Contact Person _____

Address _____

City _____ State _____ Zip Code _____

Phone _____ Fax _____

BUILDING DESCRIPTION - COMMERCIAL

Building Characteristics	Utilities
Height: _____	Water Supply: _____ Public ☐ Private ☐
No. of stories: _____	Sewage Disposal: _____ Public ☐ Private ☐
Gross area, sq. ft. per floor: _____	Electric Yes ☐ No ☐ Gas Yes ☐ No ☐
Use group: _____	Heating System: _____ Electric ☐ Oil ☐ Natural Gas ☐ Propane Gas ☐
Construction type: _____ Reinforced Concrete ☐ Structural Steel ☐ Masonry ☐ Wood Frame ☐ State Certified Modular ☐	Sprinkler system: N/A ☐ Full ☐ Partial ☐ Other Suppression ☐ # of Heads _____

BUILDING DESCRIPTION - RESIDENTIAL

Building Characteristics	Utilities
SF Dwelling ☒ SF Townhouse ☐ Depth _____ Width _____ 1 st floor: _____ 2 nd floor: _____ Basement: _____ Finished Basement ☒ Unfinished Basement ☐ Crawl space ☐ Slab on Grade ☐ No. of Bedrooms <u>3</u> Multi-family dwellings: _____ No. of efficiency units: _____ No. of 1 BR units: _____ No. of 2 BR units: _____ No. of 3 BR units: _____ Other Structure: _____ Dimensions: _____ Footings: _____ Roof: _____ State Certified Modular ☐ Manufactured Home ☐	Water Supply: _____ Public ☐ Private ☒ Sewage Disposal: _____ Public ☐ Private ☒ Electric Yes ☐ No ☐ Gas Yes ☐ No ☐ Heating System: _____ Electric ☐ Oil ☐ Natural Gas ☐ Propane Gas ☐ Sprinkler system: N/A ☐ NFPA #13D ☐ NFPA #13R ☐ Other: _____

THE UNDERSIGNED HEREBY CERTIFIES AND AGREES AS FOLLOWS: (1) THAT HE/SHE IS AUTHORIZED TO MAKE THIS APPLICATION; (2) THAT THE INFORMATION IS CORRECT; (3) THAT HE/SHE WILL COMPLY WITH ALL REGULATIONS OF HOWARD COUNTY WHICH ARE APPLICABLE THERETO; (4) THAT HE/SHE WILL PERFORM NO WORK ON THE ABOVE REFERENCED PROPERTY NOT SPECIFICALLY DESCRIBED IN THIS APPLICATION; (5) THAT HE/SHE GRANTS COUNTY OFFICIALS THE RIGHT TO ENTER ONTO THIS PROPERTY FOR THE PURPOSE OF INSPECTING THE WORK PERMITTED AND POSTING NOTICES.

Applicant's Signature Richard Scott Mitchell

Print Name Richard Scott Mitchell

Email Address RenewHdgs@gmail.com

Title/Company owner

Date 1-8-14

Checks payable to: DIRECTOR OF FINANCE OF HOWARD COUNTY

PLEASE WRITE NEATLY AND LEGIBLY

AGENCY	DATE	SIGNATURE APPROVAL
Land Development, DPZ		
State Highways		
Building Officials		
Dev. Engineering, DPZ		
Health	<u>1-8-14</u>	<u>DBernard</u>
Fire Protection		

Is Sediment Control approval required prior to issuance?
YES ☐ NO ☐

CONTINGENCY CONSTRUCTION START ☐
ONE STOP SHOP ☐

DPZ SETBACK INFORMATION	PROPERTY ID #
Front: _____	Filing fee \$ _____
Rear: _____	Permit fee \$ _____
Side: _____	Excise tax \$ _____
Side St: _____	Add'l per fee \$ _____
All minimum setbacks met? YES ☐ NO ☐	TOTAL FEES \$ _____
Is Entrance Permit Required? YES ☐ NO ☐	Sub-total paid \$ _____
Historic District? YES ☐ NO ☐	Balance due \$ _____
Lot Coverage for New Town Zone _____	Check # _____
SDP/Red-line approval date _____	Validation # _____
Accepted by _____	

Distribution of Copies - White: Building Officials Green: LDD, DPZ Yellow: DED, DPZ Pink: Health Gold: SHA

Lot 14

S 42°48'30" E
559.54'

10' Utility Easement

Not to Scale

30' Drainage Easement

N 65°59'20" E
132.04'


Lot 15

Under Ground Pipeline

APPROVED
Not to Scale

WALK-THRU BUILDING PERMIT
A# 602.08'
DATE: 12/18/13

APR. SAN DEAN
DESC. OF WORK: *See case on existing deck, approved as shown*

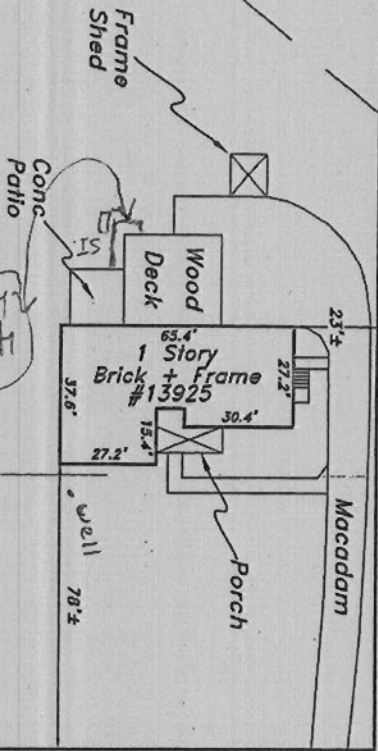

S 47°11'40" W
125.00'

Wayside Drive

APPROVED
BRL


WALK-THRU BUILDING PERMIT
BP# B13004565 A# 16706
APR. SAN DEAN
DESC. OF WORK: *finish beam in basement +*

The purpose of this drawing is to locate, describe, and represent the positions of buildings and substantial improvements affecting the property shown hereon, being known as:
Lot 15, Plat One,
HAYLAND HILLS
Plat Book 10
recorded among the land records of Howard County, Maryland in



SAGE TITLE GROUP
THE WISE CHOICE

This is page one of a two page document. The advice found on the affixed page is an integral part of this drawing, and is not valid without all pages.

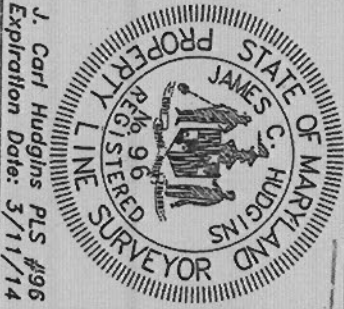

NTT Associates, Inc.
16205 Old Frederick Rd.
Mt. Airy, Maryland 21771
Phone: (410) 442-2031
Fax: (410) 442-1315
www.nttsurveyors.com

Scale: 1" = 50'
Date: 11-16-13
Field By: DR
Drawn By: DR
File No.: 11044HRS
Page No.: 1 of 2