

APPLICATION

PERCOLATION TESTING

A 39535

P _____

HOWARD COUNTY HEALTH DEPARTMENT
BUREAU OF ENVIRONMENTAL HEALTH
P.O. BOX 476 ELLICOTT CITY, MARYLAND 21043
TELEPHONE: 461-9933

DISTRICT _____

DATE 5/15/89

2/4/87
repair perc area
OK'd pending
approved plat
(SW)

TO: THE COUNTY HEALTH OFFICER
ELLICOTT CITY, MARYLAND

I, HEREBY, APPLY FOR THE NECESSARY TEST IN ORDER TO CONSTRUCT (OR RECONSTRUCT) A SEWAGE DISPOSAL SYSTEM.

PROPERTY OWNER Laurel Serv. Corp.

ADDRESS _____ PHONE _____

PROSPECTIVE BUYER RON CALTEX

ADDRESS _____ PHONE _____

PROPERTY LOCATION:

SUBDIVISION Hake's Property (Glenwood Springs) LOT NO. 10 ACTUAL 46 Sec. 1 AREA 1 Pulim ok 4/29/87

ROAD AND DESCRIPTION 140555 Rd. 2823 Saddlebred Ct.

TAX MAP _____ PARCEL # _____

SIZE OF LOT _____ TYPE BLDG. _____
(SINGLE FAMILY DWELLING OR COMMERCIAL)

THE SYSTEM INSTALLED UNDER THIS APPLICATION IS ACCEPTABLE ONLY UNTIL PUBLIC FACILITIES BECOME AVAILABLE. I FULLY UNDERSTAND THE
FEE CONNECTED WITH THE FILING OF THIS PERC TEST APPLICATION IS NON-REFUNDABLE UNDER ANY CIRCUMSTANCES. I ALSO AGREE TO COMPLY
WITH ALL M.O.S.H.A. REQUIREMENTS IN TESTING THIS LOT.

(SIGNATURE OF APPLICANT)

APPROVED BY SD Abel FOR ~~Sharon~~ Sharon Funches DATE 5-13-89

REJECTED BY _____ FOR _____ DATE _____

HOLD PENDING FURTHER TESTS _____ DATE _____

REASONS FOR REJECTION OR HOLDING 24-87 PERC. SATISFACTORY; HOLD FOR Subdivision Plat. SAT


BLDG. PERMIT SIGNED
AND RETURNED 6-1-89

BP 26342 8A

THIS IS NOT A PERMIT

SOIL PROFILE

12" AP
Yellow Br
To yellow
Red silt
Loam 4-12%
clay
Yellow Br.
Sandy silt
Loam
20-25%
Frass

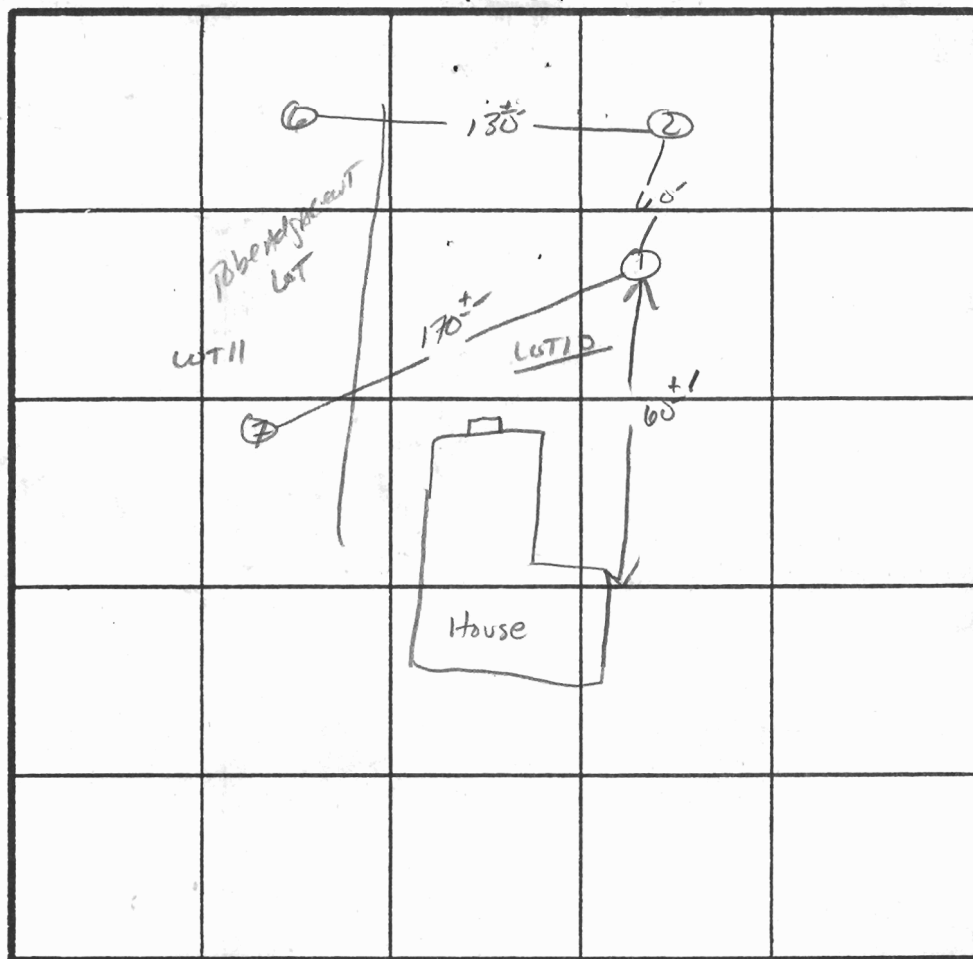

200 ϕ /BL
Repair
4.5-6.5'

INDICATE NORTH - NAME ADJOINING ROADWAY AS BASE LINE.

170335

[illegible]

REMARKS

House Larkin

TYPE OF SOIL

M. M. M.

TESTED BY

5. Abe


ALSO PRESENT

Crossed
cliff: PHIM.

Seneca Home Builders, Inc.

3126 CABIN RUN RD.
WOODBINE, MARYLAND 21797
854 6985

HOUSE DETAIL
SCALE: 1" = 30'

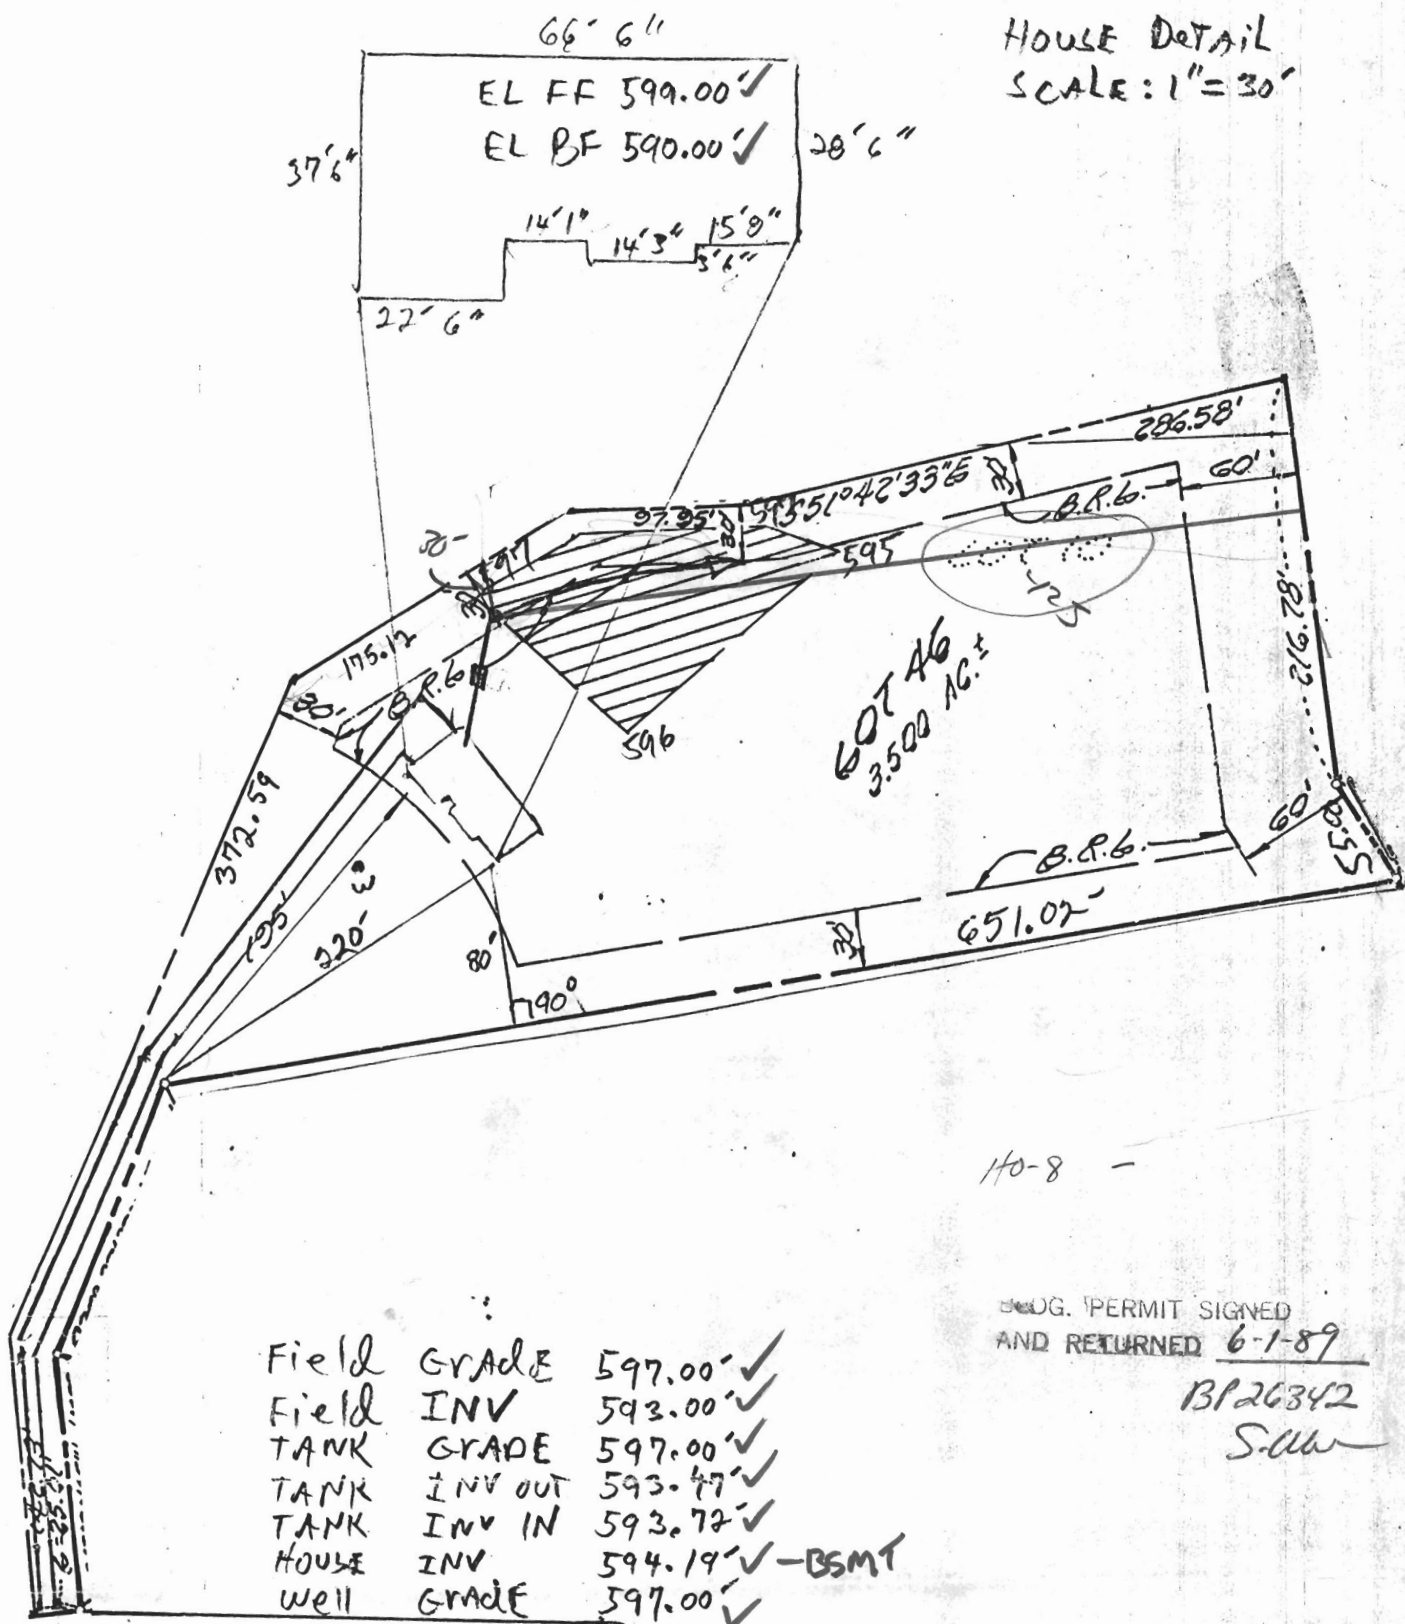

SADDLE Bred CT

NOTE: LOT 46 SECT 1 AREA 1
RECORDED PLAT # 8082, F20-1
Formerly LOT 10

MODEL: GEORGIAN

HOUSE LOCATION PLAN


SCALE: 1" = 100'

2823 SADDLE Bred CT

LOT 46, SECT 1 AREA 1

Glenwood Springs,

150
3257

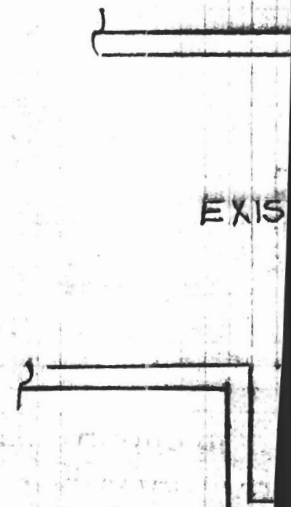

DKS

PROPOSED PER CODE