

LAYOUT _____ INSP 4 _____

INSP 2 _____ INSP 5 _____

INSP 3 _____ INSP 6 _____

ISSUE DATE: _____

P 516446-A

APPROVAL DATE: _____

A _____

PERMIT

RE-INDEX

ON-SITE SEWAGE DISPOSAL SYSTEM HOWARD COUNTY HEALTH DEPARTMENT BUREAU OF ENVIRONMENTAL HEALTH

04-337212

IS PERMITTED TO INSTALL ☐ ALTER ☐

ADDRESS: _____ PHONE NUMBER: _____

SUBDIVISION: Burdette Hill LOT NUMBER: 4

ADDRESS: 990 Ridge Road (Rt 27) PROPERTY OWNER: Yantrakovit

SEPTIC TANK CAPACITY (GALLONS): _____ OUTLET BAFFLE FILTER REQUIRED ☐

PUMP CHAMBER CAPACITY (GALLONS): _____ COMPARTMENTED TANK REQUIRED ☐

NUMBER OF BEDROOMS: _____

SQUARE FEET PER BEDROOM: _____

LINEAR FEET OF TRENCH REQUIRED: _____

TRENCHES:	Trench to be _____ feet wide. Inlet _____ feet below original grade. Bottom maximum depth _____ feet below original grade. Effective area begins at _____ feet below original grade. _____ feet of stone below distribution pipe.
LOCATION:	<i>DO. PERMIT</i> <i>AND RETURNED 10/10/79</i> <i>DO. PERMIT SIGNED</i> <i>AND RETURNED 9/26/90</i> <i>DO. PERMIT SIGNED</i> <i>AND RETURNED 12/12/01</i>
NOTES:	#41510 2 car garage # 39724 <i>Garage</i> B00133558 SUNROOM

PLANS APPROVED: _____ DATE: _____

NOTE: PERMIT VOID AFTER 2 YEARS

NOTE: CONTRACTOR RESPONSIBLE FOR SCHEDULING A PRE-CONSTRUCTION INSPECTION FOR ALL INSTALLATIONS

NOTE: WATERTIGHT SEPTIC TANKS REQUIRED

NOTE: ALL PARTS OF SEPTIC SYSTEM SHALL BE 100 FEET FROM ANY WATER WELL

NOTE: MANHOLE RISERS REQUIRED ON ALL SEPTIC TANKS AND PUMP CHAMBERS UNLESS SPECIFICALLY AUTHORIZED

**NEITHER THE HOWARD COUNTY COUNCIL NOR THE HEALTH DEPARTMENT IS
RESPONSIBLE FOR THE SUCCESSFUL OPERATION OF ANY SYSTEM
PERMITTEE RESPONSIBLE FOR OBTAINING FINAL APPROVAL ON THIS PERMIT
CALL 410-313-2640 FOR INSPECTION OF SEPTIC SYSTEM**

P516446-A

PERMIT

SEWAGE DISPOSAL SYSTEM
MARYLAND STATE DEPARTMENT OF HEALTH

HOWARD COUNTY

ELLICOTT CITY

DISTRICT 4th

INDEXED

DATE 12/29/77

JAN BERTES

IS PERMITTED TO INSTALL & ALTER

ADDRESS Twin Arts Rd., Carroll County mt. Airy PHONE 831-7612
SUBDIVISION Burdette Hill 990
(OLD GREENFIELD PROPERTY) ROAD Ridge Rd. (Rt. 27) LOT 4

PROPERTY OWNER Tarris & Carol Fronzoli

ADDRESS Clarksville Road

SPECIFICATIONS

SEPTIC TANK CAPACITY 1000 GALLONS

DRAIN FIELD DEPTH FEET, BOTTOM AREA SQ. FT.

DEEP TRENCH DEPTH FEET, BOTTOM AREA SQ. FT.

SEEPAGE PITS ABSORBENT SIDE-WALL AREA 360 SQ. FT.

INLET PIPE 2 1/2 FT. BELOW ORIGINAL GRADE. MAXIMUM DEPTH 9 1/2 FT. BELOW ORIGINAL GRADE

EFFECTIVE DEPTH AT FT. BELOW ORIGINAL GRADE.

LOCATE DISPOSAL AREA 140 FT. FROM front LOT LINE AND 60 FT. FROM right LOT LINE AS SEEN WHEN

FACING LOT FROM road.

TRENCH-to run across lot on contour approximately parallel to rear of lot.

Invert 3 1/2 ft. and maximum depth 9 1/2 ft. 3 bedroom, trench to be 20 ft. long.

PLANS APPROVED BY David J. O'Neill/PT

DATE 12/29/77

COVER NO WORK UNTIL INSPECTED AND APPROVED.

NEITHER THE HOWARD COUNTY COUNCIL NOR THE HEALTH DEPARTMENT IS RESPONSIBLE FOR THE SUCCESSFUL OPERATION OF ANY SYSTEM.

NOTE IF TRENCH IS USED CALL FOR INSPECTION BEFORE PLACING GRAVEL IN TRENCH.

NOTE NO DRY WELL SHALL EXCEED 16 FOOT IN DIAMETER.

NOTE ALL PIPE FROM HOUSE TO DISPOSAL AREA MUST BE CAST IRON.

PERMIT VOID AFTER THREE YEARS.

NOTE INSTALL STAND PIPE ON SEPTIC TANK AND DRY WELL. STAND PIPES MUST BE 6 INCHES IN DIAMETER. CAST IRON, CONCRETE OR TERRA
COTTA ACCEPTED.

*INSTALLER IS RESPONSIBLE FOR OBTAINING FINAL APPROVAL ON THIS PERMIT.

MD 23

PLAN REVIEWED
DATE 12-29-77
BOD 133558
SUNRM ADDITION

BIDD. PERMIT SIGNED
AND RETURNED

Shirley #39724 garage

#41510 garage
2 car garage
signed 10/10/79

18382

11.10.77

ELLICOTT CITY DISTRICT

150

100

50

Gravel road

SEWAGE DISPOSAL SYSTEM

MARYLAND STATE DEPARTMENT OF HEALTH

HOWARD COUNTY

INDEXED

Jim Beckett

ADDRESS: Twin Oaks Road, Carroll County

AUSPICES OF (OLD GREENFIELD PROPERTY)

PRO. DR. OWEN, Carle & Carol Fennell

ADDRESS: Clarksville Road

ATTENTION: J. Beckett

Water Well

INDICATE NORTH - NAME ADJOINING ROADWAY AS BASE LINE.

PERMIT CARD

SEPTIC TANK, LEVEL

DISTRIBUTION BOX, LEVEL

THIS FIELD, DEPTH

GRAVEL DEPTH

NUMBER OF TRENCHES

SEEPAGE PITS, INSIDE DIAMETER

ABSORBENT AREA

REMARKS

RY 27

S.T. D.W.

0.4 0.4

CLEANOUTS

0.4 0.4

N/A

FT. TRENCH WIDTH

FT.

IN. TOTAL LENGTH

FT.

TOTAL BOTTOM AREA

FT. DEPTH BELOW INLET

FT.

FT.


DATE SYSTEM APPROVED

INSPECTOR

C. R. [Signature]

1040
 RH9939-6 990 RIDGE RD MT AIRY HOW 1/20/99 OPTIM Case#THEPVONGS
 Fema Panel: 240044 0006B
 Flood Zone: C
 LOT 4
 BURDETTE HILL
 Book: 3698
 Folio:
 Dist: 4
 Co: HOWARD CO
 MD
 Scale 1"= 40'

LOCATION APPROXIMATE
 NO PIPES FOUND

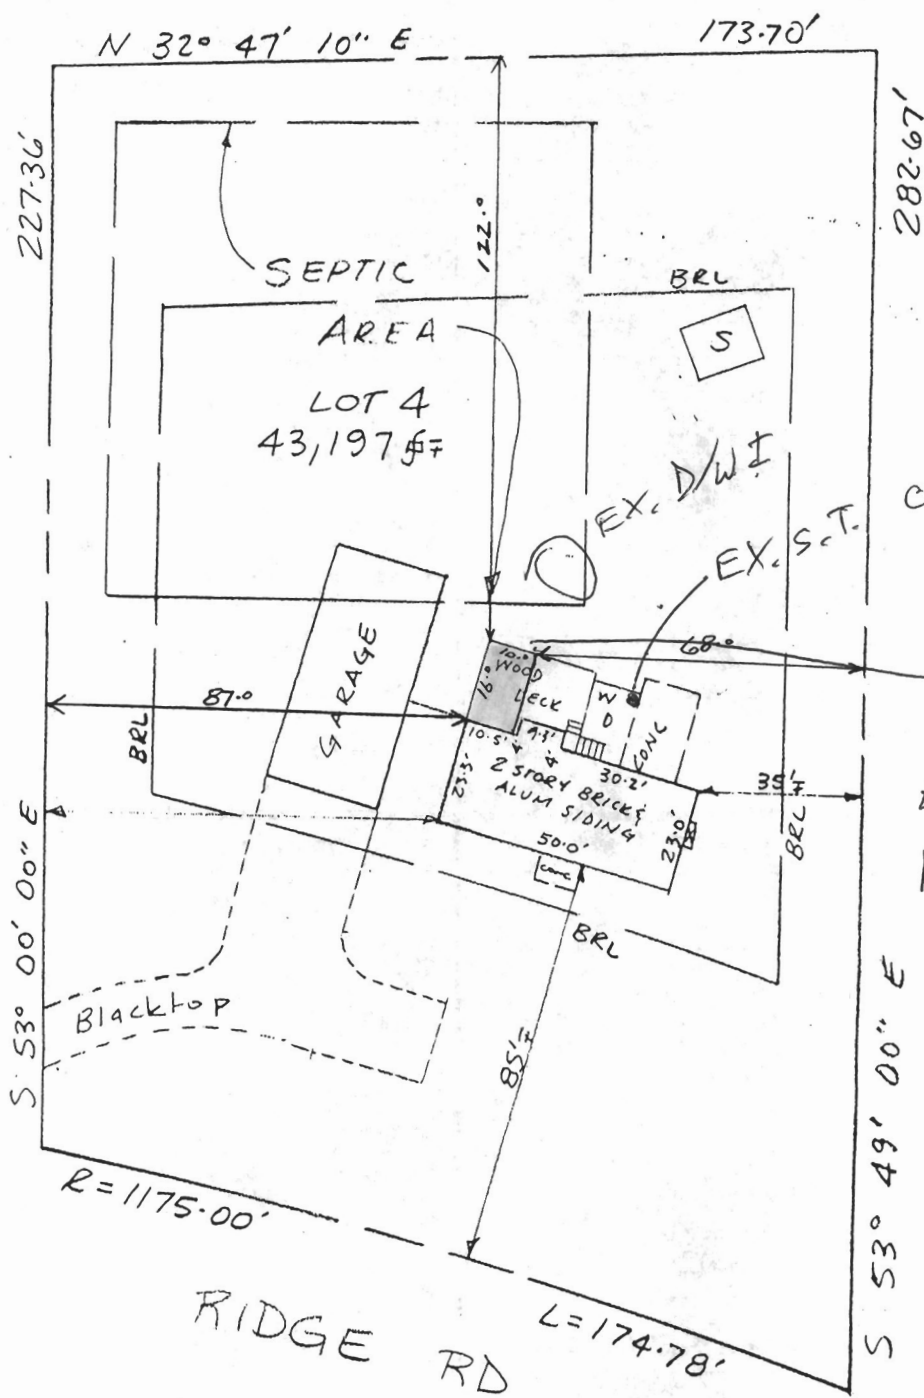

Accuracy: Approximate average accuracy (SD of sideline distances) for small suburban lots is two feet, and for large lots and metes and bounds parcels varies from two feet to twenty feet. In case of doubt, we recommend a Boundary Survey.



DAVID M. GREEN, Prop LS 311 MD
 Executive Vice President

LEGEND	
Shed (unsurveyed)	[S]
Blacktop Drive	
Gravel Drive	=====
Concrete Drive	=====

This is an Improvements Location Survey only, and must not be used for Boundary purposes. No Title Report furnished. No statement is made as to ownership of property or right or interest therein. Fences are approximate only and may not be shown. Not to be used for construction purposes (incl. permits) of any kind.

SURVEY ASSOCIATES OF MARYLAND INC

9420 ANNAPOLIS ROAD
 LANHAM MD 20706
 TEL 301 459 2760
 FAX 301 459 4409

108 OLD SOLOMONS ISLAND RD #100
 ANNAPOLIS MD 21401
 TEL 410 266 7211
 FAX 410 266 0918

LOCATION
 SURVEY