

APPLICATION

18382

SEWAGE DISPOSAL TESTING

STATE OF MARYLAND - DEPARTMENT OF HEALTH AND MENTAL HYGIENE

HOWARD COUNTY HEALTH DEPARTMENT
ENVIRONMENTAL HEALTH SERVICES

P. O. BOX 476, ELLICOTT CITY, MARYLAND 21043
TELEPHONE: 488-8000, EXT. 300

DISTRICT 4th

DATE 4/27/73

*Original - 400 sq. ft.
This is a 2 1/2 ft. deep well.
May depth for day well is 10 ft. For night day well
depth from ground level and 70 ft. from right side
line as shown from lot 27*

TO: THE COUNTY HEALTH OFFICER
ELLICOTT CITY, MARYLAND

I, HEREBY, APPLY FOR THE NECESSARY TEST IN ORDER TO CONSTRUCT (OR RECONSTRUCT) A SEWAGE DISPOSAL SYSTEM.

PROPERTY OWNER Raymond E. Greenfield

ADDRESS 22625 Wildest Road, Germantown, Md.

PHONE 428-0287

PROPERTY LOCATION:

SUBDIVISION _____ LOT NO. Parcel M

ROAD AND DESCRIPTION Route 27

SIZE OF LOT 6 acres

TYPE BLDG. 3 or 4 bedrooms
NUMBER OF BEDROOMS 3

IF NOT SINGLE RESIDENCE DESCRIBE _____

THE SYSTEM INSTALLED UNDER THIS APPLICATION IS ACCEPTABLE ONLY UNTIL PUBLIC FACILITIES BECOME AVAILABLE.

SIGNATURE OF APPLICANT /s/ Raymond E. Greenfield

APPROVED BY Robert V. Towner FOR Day Well DATE 5/30/73
(KIND OF SYSTEM)

REJECTED BY _____ FOR _____ DATE _____
(KIND OF SYSTEM)

HOLD PENDING FURTHER TESTS _____ DATE _____


REASONS FOR REJECTION OR HOLDING _____


THIS IS NOT A PERMIT

Plan of Survey
 PARCEL M
 Being a part of Greenfield Property
 Howard County, Maryland
 Scale: 1" = 200'

I hereby certify that the plan shown hereon is correct and that iron pipes
 have been placed where shown. This lot complies with minimum ownership, width and lot
 area as required by the Maryland State Department of Health Regulations.

REMI SURVEYS
 DANASCUS, MD
 PH. 918-8622

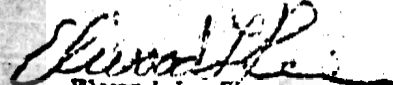
 Elwood L. Reim
 R.P.L.S. MD. #3383
 July 5, 1973

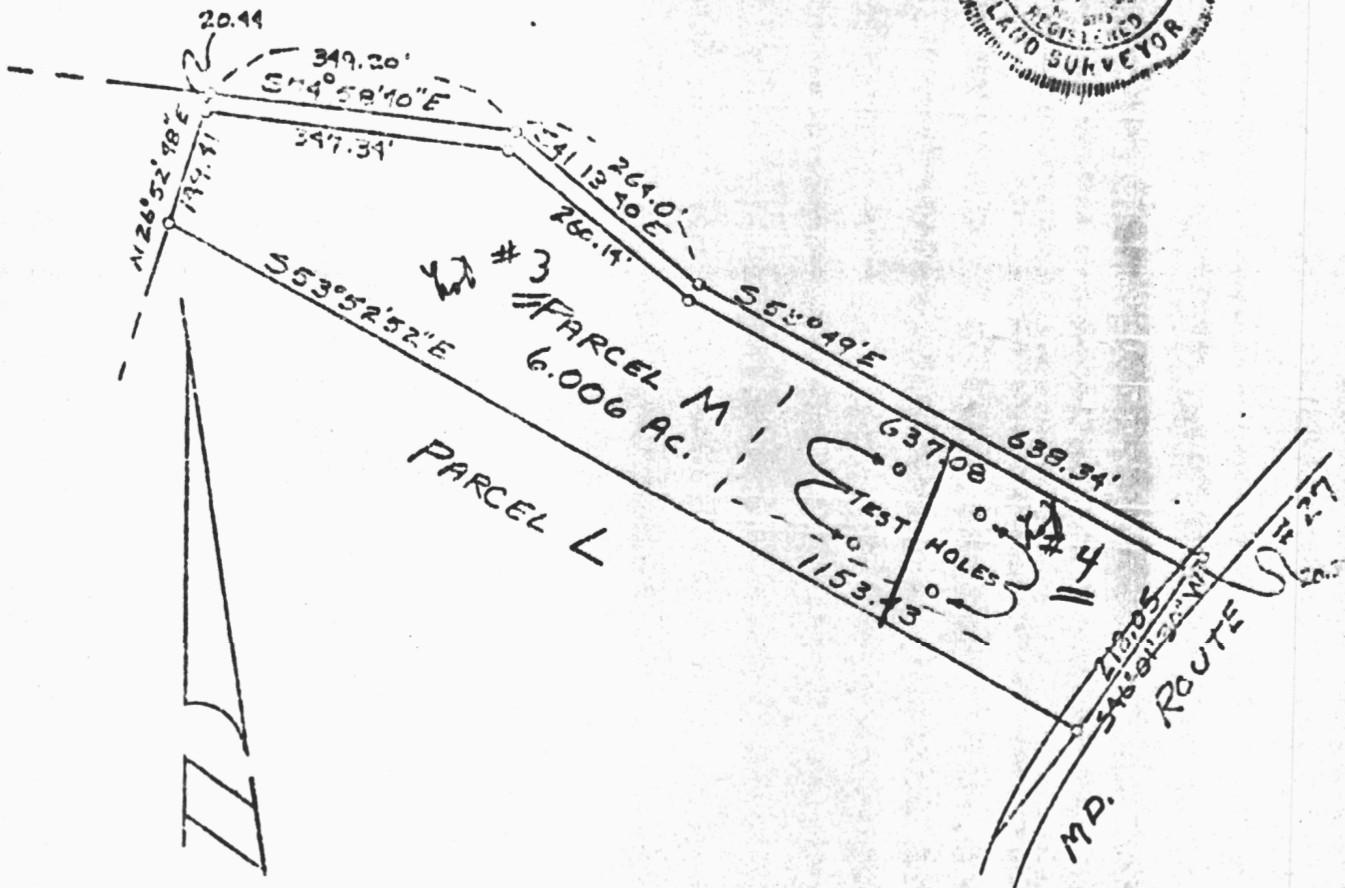

REMI SURVEYS
 2/12/73

PLAT PLAN

LOT 4

BURDETTE HILL

FOURTH ELECTION DISTRICT

HOWARD COUNTY, MD.

A18382

3.

N 32° 47' 10" E 173.70'

N 00° 00' 00" S 227.36'

50' BRL
LOT 4
43.1974
ELEV. @ PERC. TIME - 813.0
EXIST. ELEV. - 812.5
INV. ELEV. - 809.5
75' BRL

EXIST. ELEV. 812.0
INV. ELEV. 810.0
INV. @ 44° 810.2

F.F. 821.5
B. 813.0
55' 23.35

WATER WELL
EXIST. ELEV. 817.5



553.40' 00" E
200' (N. 7.5°)
232.67'

R. 1175.00 A. 174.78
RIDGE (MD. RTE. 27) ROAD

SURVEYOR'S CERTIFICATE

I hereby certify that the position of all existing improvements on the above described property have been carefully established by a transit-tape survey and that unless otherwise shown, there are no encroachments

Charles L. Renn

CHARLES L. RENN
Registered Land Surveyor
Maryland No. 9888

RENN SURVEYS, INC.

BOX 55 • DAMASCUS, MARYLAND 20746 (301) 252-3551
LAND PLANNING CONSULTANTS • SUBDIVISIONS • LOTS & BOUNDARIES

REFERENCE		Drawn by	Checked by
Plat	—	WLW	
Book	—	Date	9-28-77
Plat	3698	Scale	1" = 40'
No.			Record No.

NOTE: This drawing is not intended to establish property lines nor are the existence of corner markers guaranteed. All information shown hereon taken from the land records of the county in which the property is located.

A18382

HOUSE LOCATION

BURDETTE HILL

LOT 4

HOWARD COUNTY, MARYLAND

GARAGE EXCAVATION

ALREADY STARTED (TRUE TO SIZE);
RECOMMEND MODIFICATION OF SDA

TO ACCOMMODATE PROPOSED GARAGE
ADDITION (AS SHOWN); S.T. LOCATION, UNKNOWN


MR 9/20/90

H.J. ROGERS

L. 227

F. III.

A18328
PERC HOLDS TO
BACK OF LOT
AMPLE SEPTIC AREA
REMAINS.
OK TO PROCEED,
7/26/90
Caudill

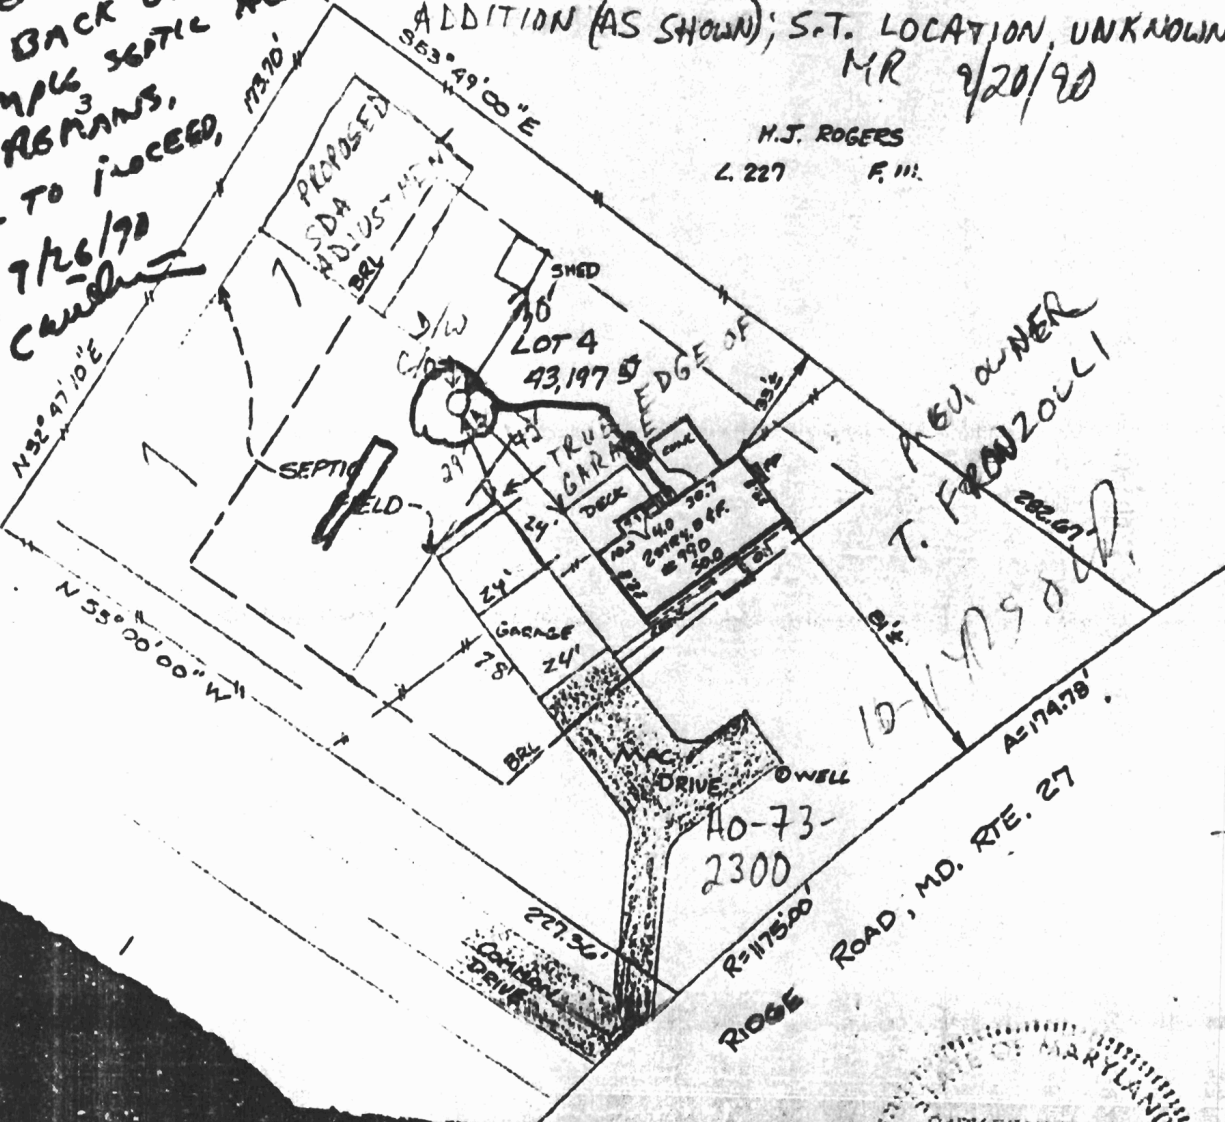

PREVIOUS OWNER
T. FRANZOLLI

10-149500

40-73-2300

RISE ROAD, MD. RTE. 27

STATE OF MARYLAND
GARY DEAN SIMPSON
NO. 514