	R.			
	DF	RMIT		
			P_516429-B	
		ISPOSAL SYSTEM		
		TY HEALTH DEPARTME ENVIRONMENTAL HEALTH	ENT ISSUE DATE <u>12/7/1967</u>	
		0-315-2640	1350E DATE	
	NE- INU	CASE	APPROVAL DATE <u>1/10/1968</u>	
	AD 104711			
	05-278561	IS PERMITT	ED TO INSTALL ALTER	
DDRESS			PHONE	
UBDIVISION Stolt Prop	erty LOT NUMB	ER _ ADDRESS 176	5 Sykesville Rd. (Rt 32)	
			38	
SEPTIC TANK CAPACITY				
PUMP CHAMBER CAPACITY				
SQUARE FEET PER BEDROOM				
INEAR FEET OF TRENCH REC				
	e feet wide. Inlet		ttom maximum depth	
feet below	w original grade. feet of s	tone below distribution box.		
PLANS APPROVED	1.01		DATE	
PERMIT VOID AFTER 2 YEARS	_			
NOTE: CONTRACTOR RESPONSIBLE	FOR SCHEDULING A PRE-CONST	RUCTION INSPECTION FOR ALL I	NSTALLATIONS	
NOTE: TOP OF SEPTIC TANKS ARE T	O BE NO DEEPER THAN 3.0 FEET	BELOW FINISH GRADE		
NOTE: WATERTIGHT SEPTIC TANKS	REQUIRED			
IOTE: CLEANOUT REQUIRED EVER	Y 70 FEET OF SEWER LINE AND/OR	AT 90° SWEEPS IN LINES FROM	HOUSE TO DRAIN FIELDS, 90° ELBOWS	
NOTE: ALL PARTS OF SEPTIC SYSTE OTHERWISE SPECIFICALLY A	EMS (I.E. TANK, DISTRIBUTION BO	X, DRAINFIELDS) TO BE 100 FEET	FROM ANY WATER WELL UNLESS	
NOTE: NO ABSORPTION TRENCH TO	EXCEED 100 FEET IN LENGTH UN	LESS SPECIFICALLY AUTHORIZE	Ð	
NOTE: ALL PIPE FROM HOUSE TO S	EPTIC TANK MUST BE CAST IRON	OR SCHEDULE 35/40 PVC OR ABS	5	
NOTE: MANHOLE RISERS REQUIRED) ON ALL SEPTIC TANKS AND PUM	P CHAMBERS		τ
NOTE: DISTRIBUTION BOXES MUST	HAVE BAFFLES			U
NOTE: IF PUMPED SEPTIC SYSTEM I PERMIT (2) PUMP PERFORMA	REQUIRED, (1) SEPTIC PUMP DETA	IL TO BE PROVIDED BY INSTALLI TO HEALTH DEPARTMENT APPR(ER PRIOR TO ISSUANCE OF SEPTIC DVAL OF SEPTIC PERMIT	
	D COUNTY COUNCIL NOR T SUCCESSFUL OPER E RESPONSIBLE FOR OBTA CALL 410-313-2640 FOR INS	ATION OF ANY SYSTEM	N THIS PERMIT	0-1-0


SEW	PERMIT AGE DISPOSAL ATE DEPARTMENT O	8:45 7.7 940 P_13285 A_18691
HOWARD COUNTY	INDEXED	ELLICOTT CITY DISTRICT3 DATE12/3/4
Boolman Brothers, In	18 PERM	
ADURESS		
A SEWAGE DISPOSAL SYSTEM LOCATED AT	1765 (RT. 32)	- Syhesville Road
SUBDIVISIONSTOLT	ROAD It. 32	a K mile Ha. Lot
ADDRESS	Weth	rivery might to 30
	RBENT SIDE-WALL AREA IK CAPACITY7500 ICREASE DISPOSAL AREA 22 INCH 10 ft. 15 dimeter bs located 35 ft. ft I day well to be at 14	N & TANK CAPACITY 80%. Mr by 10 ft. deep belew the rem corner of barbod wire i
PLANS APPROVED BY J. N. KILDON FILL SEPTIC TANK AND DISTRIBUTION BOX UNTIL INSPECTED AND APPROVED.		5/26/67 NG FOR AN INSPECTION, COVER NO N DEPARTMENT IS RESPONSIBLE FOR
NOTIFY THE HEA BEFORE EXCAVATION	S. Ballet and	MENT 48 HOURS Be back filled

0.00 MARYLAND STATE DEPARTMENT OF HOWARD COUNTY Septer Jank 750 galler Day acolo Each 10. a sthe inlat p 10 his o we THE COU ELLICOTT CITY, MARYLAND I, HEREBY, APPLY FOR THE NECESSARY TES GOAL SYSTEM. Carl Schoolde ADDARSS Balethorpe 27, Nervis OPERTY LOCATION turn UPANT ION TO CONSTRUCT SYSTEM ACONEDO BIZE OF LOT ALCONERO. NOT SINGLE AUSIDENCE DESCRIPT BIGNATURE OF APPLICANT William & R. C. APPROVED BY REJECTED BY. HOLD PENDING FURTHER TESTS REASONS FOR REJECTION OR HOLDING THIS IS NO

1128

	Rebox 10-29
Post-it* Fax Note 7671	Date 10/14 pages
TOTOM	From Hky 4 Stolte
Ço /Dept.	Co.
Phone #	Phone # 410- 442-5166
Fax# 465-0803	Fax # CLIL 410 477 5412

plat + permit info

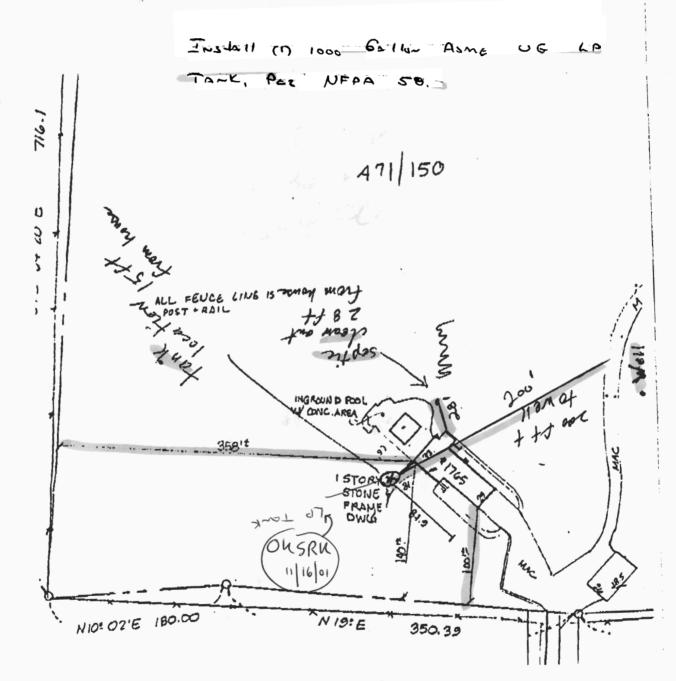

#