

C1 4610	SEQUENCE NO. (DENY USE ONLY)	STATE OF MARYLAND WELL COMPLETION REPORT FILL IN THIS FORM COMPLETELY PLEASE PRINT OR TYPE		THIS REPORT MUST BE SUBMITTED WITHIN 45 DAYS AFTER WELL IS COMPLETED
(THIS NUMBER IS TO BE PUNCHED IN COLUMNS 3-6 ON ALL CARDS)		COUNTY NUMBER		
ST/CO USE ONLY DATE RECEIVED	DATE WELL COMPLETED	Depth of Well (TO BOTTOM OF FOOT)	PERMIT NO. FROM PERMIT TO DRILL WELL	
OWNER STREET OR RFD SUBDIVISION	TOWN	SECTION LOT		
WELL LOG Not required for driven wells STATE THE KIND OF FORMATIONS PENETRATED, THEIR COLOR, DEPTH, THICKNESS AND IF WATER BEARING		GRouting RECORD WILL HAS BEEN GROUTED (Circle Appropriate Box) TYPE OF GROUTING MATERIAL CEMENT ☒ BENTONITE CLAY ☒ NO. OF BAGS NO. OF POUNDS GALLONS OF WATER DEPTH OF GROUT SEAL (to nearest foot) from to		
DESCRIPTION (Use additional sheets if needed)		GRouting RECORD casing types insert appropriate code below MAIN CASING TYPE Nominal diameter (to nearest inch) Total depth of main casing (to nearest foot) OTHER CASING (if used) diameter inch depth (feet) from to		
FEET FROM TO		SCREEN RECORD screen type or open hole insert appropriate code below DEPTH (nearest ft) SLIT SIZE DIAMETER OF SCREEN (NEAREST INCH) from to		
CIRCLE APPROPRIATE LETTER A A WELL WAS ABANDONED AND SEALED WHEN THIS WELL WAS COMPLETED E ELECTRIC LOG OBTAINED P TEST WELL CONVERTED TO PRODUCTION WELL		DRILLER'S IDENT NO DRILLER'S SIGNATURE (MUST MATCH SIGNATURE ON APPLICATION) SITE SUPERVISOR (sign of driller or journeyman responsible for sitework if different from permittee)		
WHEREBY CERTIFY THAT THIS WELL HAS BEEN CONSTRUCTED IN ACCORDANCE WITH COMAR 26.04.06 "WELL CONSTRUCTION" AND IN CONFORMANCE WITH ALL CONDITIONS SET FORTH IN THE ABOVE CAPTIONED PERMIT AND THAT THE INFORMATION PRESENTED HEREIN IS ACCURATE AND COMPLETE TO THE BEST OF MY KNOWLEDGE		OTHER DATA (GRAVEL PACK IF WELL DRILLED WAS FLOWING WELL INSERT IF IN BOX 66) DEEP USE ONLY (NOT TO BE FILLED IN BY DRILLER) T (E.G.S.) W.O. TELESCOPE CARRING LOG INDICATOR OTHER DATA		

A1369


DATE REQUESTED: 3/14/91 - 11/90

CONTRACTOR: EASTERN OIL

WELL TAG #: AD-88-1948

COUNTY #: 1269

RECENT BP FOR FOUR CAR GARAGE

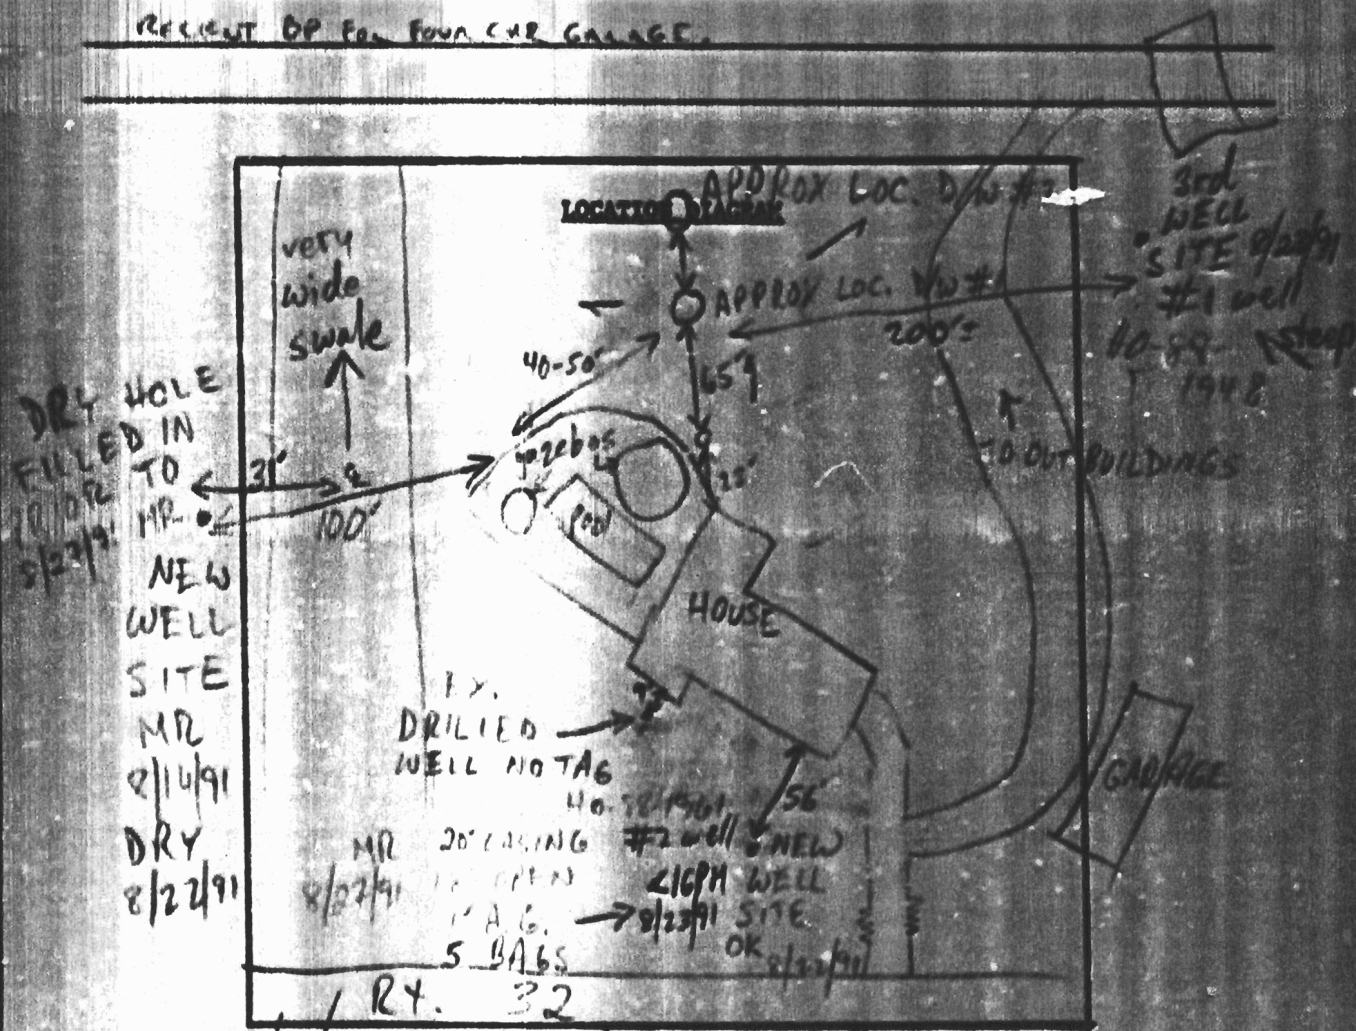

COMMENTS: 8/14/91 OK TO DRILL MR
8/22/91 DRILL NEW SITE^{MR} 8/23/91 BID SITE OK MR
8/27/91 OWNER UNDECIDED ABOUT STATUS OF
ORIG. WELL MR

DATE: 8/14/91

REFERENCES

M. L. & Co.