


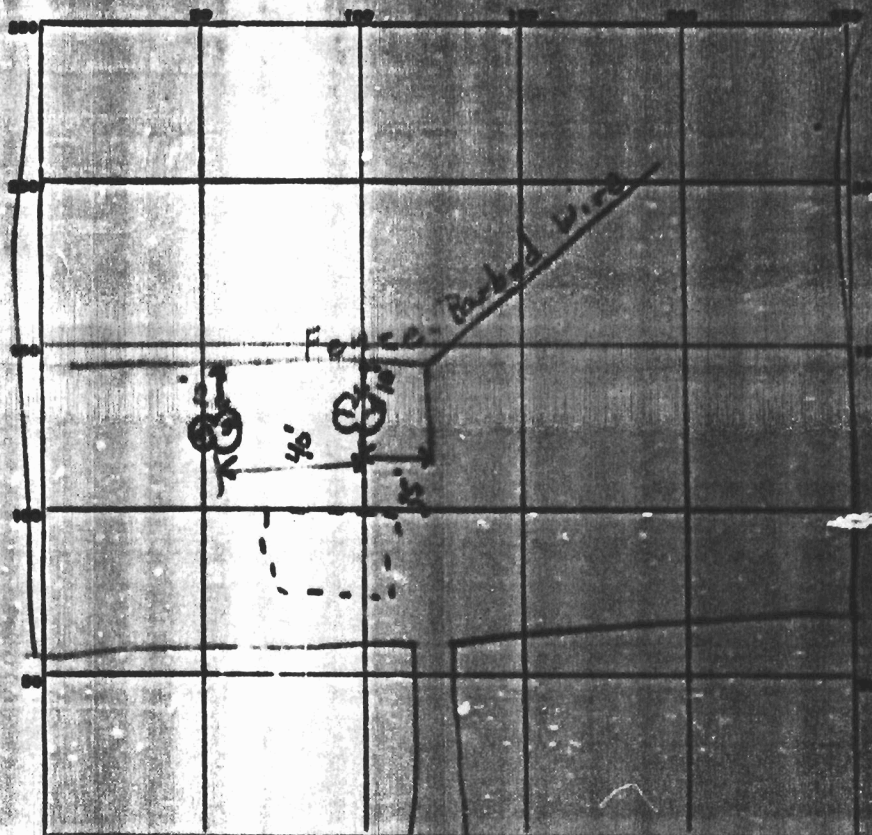

INDICATE NORTH - NAME ADJOINING ROADWAY AS BASE LINE.

Rte 32

DATE	TEST NO.	DEPTH	PERMIT		TEST - 15' DEEP		TIME
			START	STOP	START	STOP	
5/4/62	1	5'	10:00	10:05	10:05	10:10	15 min
	2	9'	10:03	10:09	10:09	10:17	10 min
	3	5'	10:12	10:25	10:25	10:53	28 min
	4	9'	10:15	10:30	10:30	10:53	23 min

SOIL AUGER FINDING

TESTED BY

JHK


REMARKS

22m 1/2 inch

43 40
12 17.0

24
30
44
10
440
8 440
58150

44
440

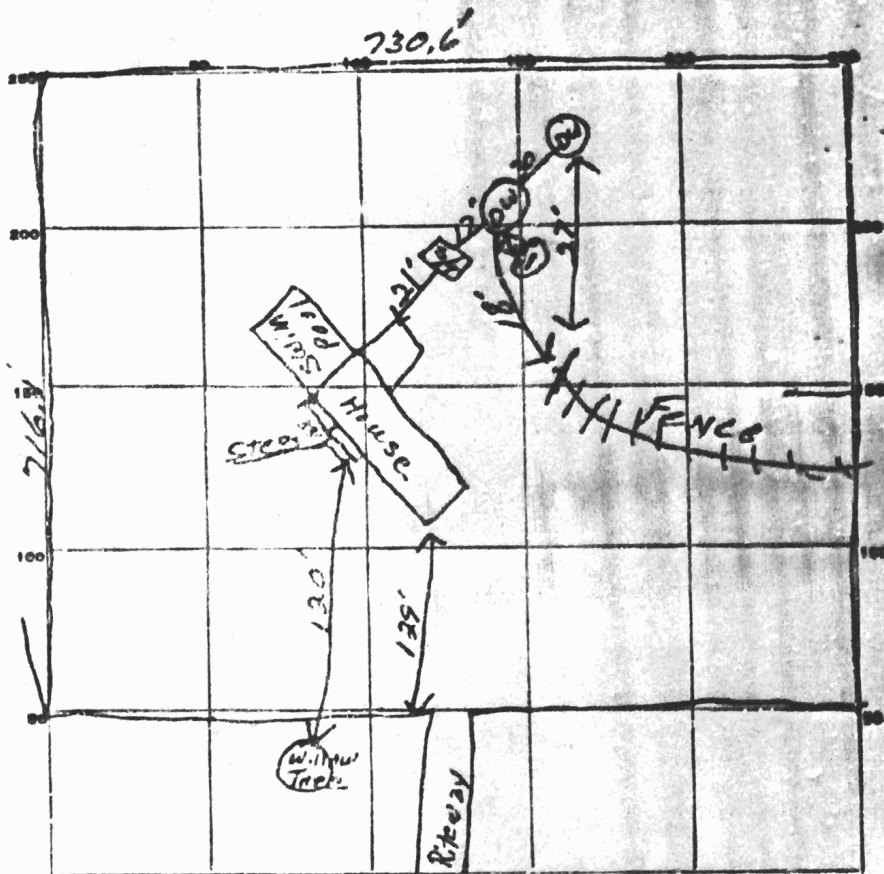

INDICATE NORTH. - NAME ADJOINING ROADWAY AS BASE LINE.

ROUTE 32

PERMIT CARD OK

SEPTIC TANK, LEVEL Cement 750

CLEANOUTS OK

DISTRIBUTION BOX, LEVEL _____

TILE FIELD, DEPTH _____ FT. TRENCH WIDTH _____ FT.

GRAVEL, DEPTH _____ IN. TOTAL LENGTH _____ FT.

NUMBER OF TRENCHES _____ TOTAL BOTTOM AREA _____

① 10' x 10' x 13' 13 440
SLEEPAGE PITS, INSIDE DIAMETER 2' 8" 13' 13' 440 FT. DEPTH BELOW INLET 10 FT.

② 11' x 11' x 11' 11 440
ABSORBENT AREA 880 SQ. FT.

REMARKS _____

DATE SYSTEM APPROVED 7/10/69

INSPECTOR James T. Waite