

APPLICATION

SEWAGE DISPOSAL TESTING

MARYLAND STATE DEPARTMENT OF HEALTH

HOWARD COUNTY *Septic Tank - 1000 gal*

ELLCOTT CITY

DISTRICT *8th*

DATE *9/8/72*

Dry Well - 400 sq ft above ground sidewalk area.

*is begun below the first 4 1/2 ft
of non-porous soil. Maximum depth
permitted for dry well is 11 ft. Locate
dry well 190 ft from front property
line and 160 ft from right side line or
near from right of way.*

TO: THE COUNTY HEALTH OFFICER
ELLCOTT CITY, MARYLAND

I, HEREBY, APPLY FOR THE NECESSARY TESTS IN ORDER TO CONSTRUCT (OR RECONSTRUCT) A SEWAGE DISPOSAL SYSTEM.

PROPERTY OWNER *Edward R. Talbot, et al (Mar. F. & Sara G. Riley, contract owner)*

ADDRESS *71 Park Avenue, Gaithersburg, Md. 20878* PHONE *926-3007*

PROPERTY LOCATION:

SUBDIVISION _____ LOT NO. _____

ROAD AND DESCRIPTION *entrance on Broadwater Lane spur, 1/2 mi south of
Linden Chapel Rd. as per attached plat*

OCCUPANT _____ PHONE _____

PERSON TO CONSTRUCT SYSTEM _____

ADDRESS _____ PHONE _____

SIZE OF LOT *7.702 Acres* TYPE BLDG. *2 bedrooms*

IF NOT SINGLE RESIDENCE DESCRIBE _____

SIGNATURE OF APPLICANT *Richard D. McLaughlin - agent for owner*


APPROVED BY *Robert V. Turner* FOR *Dry Well* DATE *9/19/72*
(KIND OF SYSTEM)

REJECTED BY _____ FOR _____ DATE _____
(KIND OF SYSTEM)

HOLD PENDING FURTHER TESTS _____ DATE _____

REASONS FOR REJECTION OR HOLDING _____

NOT RECOMMENDED

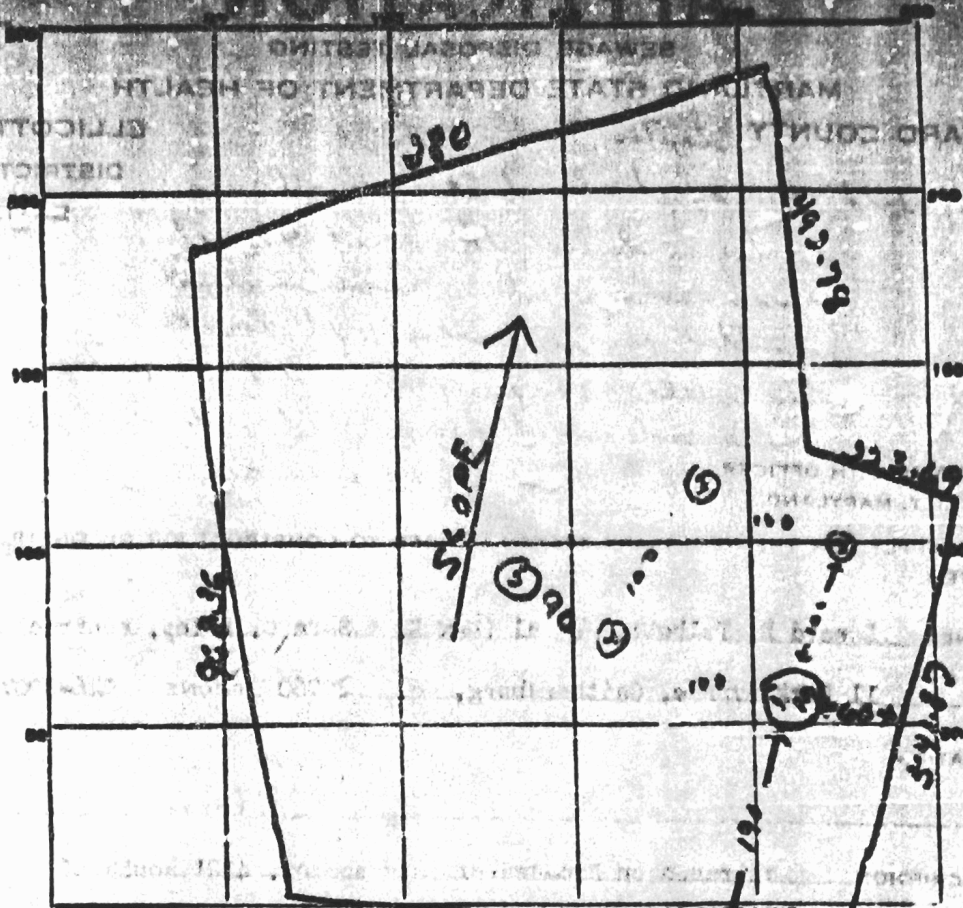

DATE	TEST NO.	DEPTH	PRE-WET		TEST - 1" DROP		TIME
			START	STOP	START	STOP	
12/72	1	11 1/2	10 ⁰⁶	10 ¹⁰	10 ¹⁰	10 ¹⁹	8 min
	1A	3 1/2	10 ⁰⁶	Flow rate - Clay for 5 ft.			
	2	10 1/2 ft.	Water - sand and gravel from 4 ft.				
	3	11 ft.	10 ¹¹	—————			10 ¹¹ 3 min
	3A	5 ft.	10 ¹⁰	Fair and after 5 1/2 ft.			
	4	11 ft.	Sand and gravel after 5 ft.				
	5	5 ft.	10 ²⁷	10 ²⁸	10 ²⁸	10 ²⁹	1 min
	5A	10 1/2 ft.	10 ³⁰	10 ³²	10 ³²	10 ³³	3 min

SOIL AUGER FINDING _____

TESTED BY: A. Tume