

3/10/64
fm.

PERMIT

SEWAGE DISPOSAL SYSTEM

P. 08100

A. 07823

MARYLAND STATE DEPARTMENT OF HEALTH

HOWARD COUNTY

ELLICOTT CITY

INDEXED

DISTRICT 5

DATE 3/6/64

Elwood Seager

IS PERMITTED TO INSTALL ☒ ALTER

ADDRESS Rt. 1 - Box 267D - Laurel, Md.

PHONE RA 5-0324

A SEWAGE DISPOSAL SYSTEM LOCATED AT

SUBDIVISION Bean Property

ROAD 8180 Stearns Dr.

LOT 7

PROPERTY OWNER Stanley Bean

ADDRESS Murphy Rd., Fulton Md.

SPECIFICATIONS 3 bedrooms

DRAIN FIELD DEPTH FEET, BOTTOM AREA SQ. FT.

SEEPAGE PITS ABSORBENT SIDE-WALL AREA 710 SQ. FT.

SEPTIC TANK CAPACITY GALLONS

FOR GARBAGE GRINDER, INCREASE DISPOSAL AREA 25% & TANK CAPACITY 50%

OTHER Two dry wells each 10 ft. in dia. by 10 1/2 ft. deep below the inlet

located 125 ft. from the front property line with one dry well 38 ft. off the right

side property line and the second dry well 30 ft. from the first as measured

edge to edge. Locations determined as seen from the road. Inlet 3 ft. below

original grade.

PLANS APPROVED BY J. Hennigan


DATE 1/16/64

FILL SEPTIC TANK AND DISTRIBUTION BOX WITH WATER BEFORE CALLING FOR AN INSPECTION. COVER NO WORK UNTIL INSPECTED AND APPROVED.

NEITHER THE HOWARD COUNTY COMMISSIONERS NOR THE HEALTH DEPARTMENT IS RESPONSIBLE FOR THE SUCCESSFUL OPERATION OF ANY SYSTEM

07823

A 87828

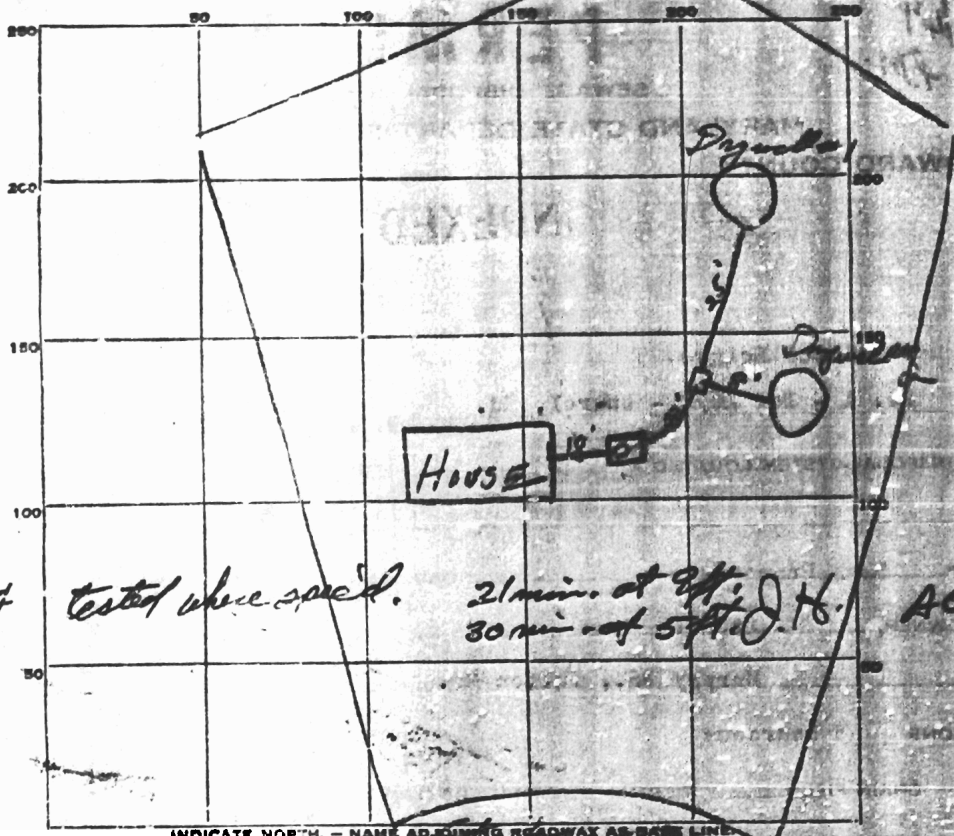

1-16-64 tested when spec'd.

21 min. at 8 ft.
30 min. at 5 ft. D.H.

A07828

PERMIT CAR: None Seen

SEPTIC TANK, LEVEL 750 gal concrete

CLEANOUTS 8" Standpipe

DISTRIBUTION BOX, LEVEL None

TILE FIELD, DEPTH _____ FT. TRENCH WIDTH _____ FT.

GRAVEL DEPTH _____ IN. TOTAL LENGTH _____ FT.

NUMBER OF TRENCHES _____ TOTAL BOTTOM AREA _____

SEEPAGE PITS: Dry well #1 INSIDE DIAMETER 11 FT. DEPTH BELOW INLET 10 1/2 FT.

Dry well #2 ABSORBENT AREA _____ SQ. FT.

REMARKS Good work

DATE SYSTEM APPROVED 2-10-67

INSPECTOR J. Henning