


ADDRESS No.:

THE INFORMATION SHOWN HAS BEEN ESTABLISHED BY CURRENT ACCEPTABLE SURVEY PROCEDURES AND FROM AVAILABLE RECORD INFORMATION. THIS DRAWING IS TO BE USED FOR TITLE TRANSFER FINANCING, OR REFINANCING ONLY AND IS NOT TO BE USED FOR THE ESTABLISHMENT OF PROPERTY LINES, LOCATION OF FENCES, GARAGES, BUILDINGS, OR OTHER EXISTING OR FUTURE IMPROVEMENTS.

LEGEND

- O/H = OVERHANG
- A/C = AIR COND./HEAT PUMP
- G/M = GAS METER
- E/M = ELECTRIC METER
- CH = CHIMNEY
- B/W = BAY WINDOW
- D/W = DRIVEWAY
- CONC = CONCRETE

LINE TABLE		
LINE	Bearing	Length
L1	S31°10'11"E	24.74'

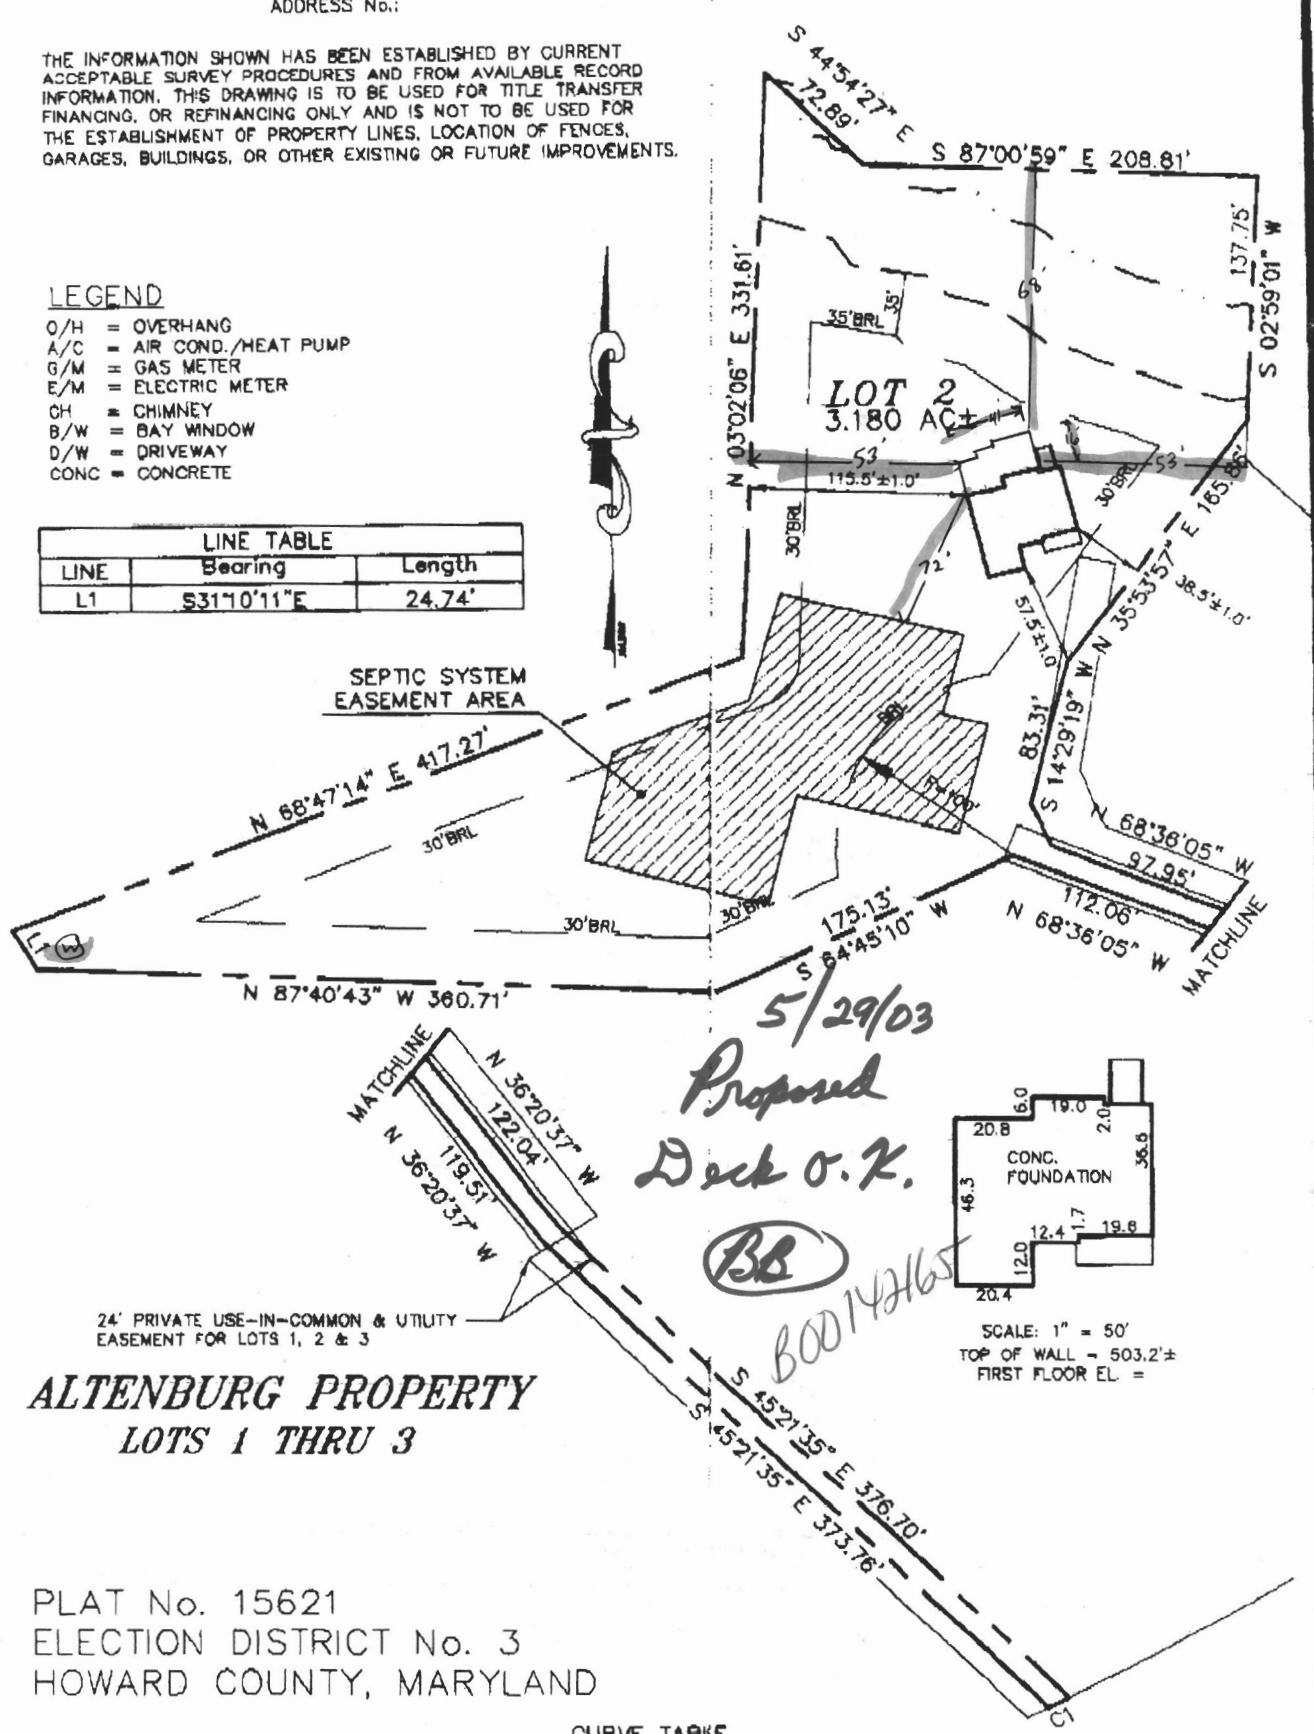

ALTENBURG PROPERTY
LOTS 1 THRU 3

PLAT No. 15621
ELECTION DISTRICT No. 3
HOWARD COUNTY, MARYLAND

CURVE TABLE						
No.	Radius	Length	Delta	Tangent	Chord	Distance
1	2050.68	12.61	00°21'09"	.31	N62°34'25"E	12.61

MILDENBERG
BOENDER, & ASSOC., INC.

Engineers Planners Surveyors
5072 Dorsey Hall Drive, Suite 202, Ellicott City, Maryland 21042
(410) 997-0298 Balt. (301) 821-6521 Wash. (410) 997-0298 Fax.

FOUNDATION	DATE: 12/18/02	FINAL	DATE:
DRAWN BY: T. HILL	SCALE: 1" = 100'	LOCATION DRAWING	
PROJECT NO.:	02-078		



JOHN MILDENBERG
PROF. LAND SURVEYOR
MARYLAND No. 10718