

P516476-A

RE-INDEXED

APPLICATION

SEWAGE DISPOSAL TESTING

MARYLAND STATE DEPARTMENT OF HEALTH

HOWARD COUNTY

ELLIOTT CITY

DISTRICT

DATE 2/2/68

03-266215

3 bedrooms
 Dry well 12 ft. in diameter 10 ft deep below
 the soil surface 60 ft. from the front
 property line and 70 ft. from the side
 property line or corner. The dry well is
 10 ft. deep. Capacity 10,000 gal.
 Determined by *10,000 gal. application*.

Same as above with exception: Dry well 13 ft. in diameter 12 ft.
Dry well capacity 10,000 gal.
1,000 gal. after tank.

TO: THE COUNTY HEALTH OFFICER
ELLIOTT CITY, MARYLAND

1. HEREBY, APPLY FOR THE NECESSARY TESTS IN ORDER TO CONSTRUCT OR RECONSTRUCT A SEWAGE DISPOSAL SYSTEM.

PROPERTY OWNER Walter A. ShankADDRESS Avoca Ave., Elliott City, Md. PHONE HO 5-3461PROPERTY LOCATION: 3827 WALT ANN DRIVE, LOT 3SUBDIVISION Folly QuarterHedgeside GlenLOT NO. 3ROAD AND DESCRIPTION Folly Quarter Drive, Walt Ann Drive

OCCUPANT _____

PHONE _____

PERSON TO CONSTRUCT SYSTEM _____

ADDRESS _____

PHONE _____

SIZE OF LOT 1.10 ACRESTYPE O.D.O. 3 or 4NUMBER OF CARRIERS 0

IF NOT SINGLE RESIDENCE DESCRIBE _____

SIGNATURE OF APPLICANT Walter A. ShankAPPROVED BY S. HansenFOR Dry WellDATE 5-22-68

REJECTED BY _____

FOR _____

DATE _____

(KIND OF SYSTEM)


HOLD PENDING FURTHER TESTS _____

DATE _____

REASONS FOR REJECTION OR HOLDING _____

THIS IS NOT A PERMIT

P516476-A

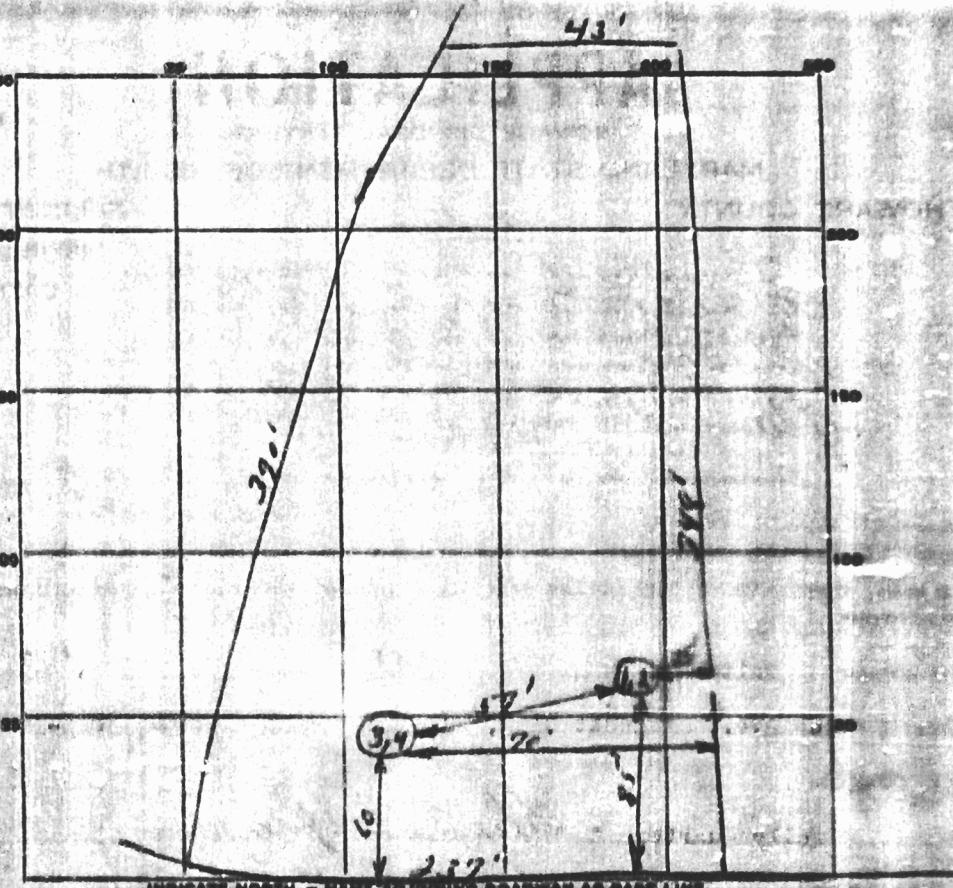

INDICATE NORTH. - TURN 2 BEGINS A ROADWAY AND BASE LINE.

Folly Ate. Drive

ans
12/13

SOIL AUGER FINDING.

TEOTER BI

REMARKS

2-9-65

ALSO PRESENT Danielle LOT NO. 3

