

9/4/75
new plan

PERMIT

SEWAGE DISPOSAL SYSTEM

P-1272
A-12417

MARYLAND STATE DEPARTMENT OF HEALTH

HOWARD COUNTY

ELLICOTT CITY

INDEXED

DISTRICT 3

DATE 8/30/76

Jack Pyork IS PERMITTED TO INSTALL ☒ ALTER ☐

ADDRESS Tap Oaks Road, Dayton, Md. PHONE 988-9270

SEWAGE DISPOSAL SYSTEM LOCATED AT

12112
DIVISION Woodmark ROAD Hilland Court & LOT 35, Blk. P, Sec. 11
Hilland Court & Hilland Court

PROPERTY OWNER Francis Mitchell

ADDRESS

SPECIFICATIONS - 2 bedrooms

DRAIN FIELD DEPTH FEET, BOTTOM AREA SQ. FT.

SEEPAGE PITS ABSORBENT SIDE-WALL AREA SQ. FT.

SEPTIC TANK CAPACITY 1,500 GALLONS includes increase with garbage grinder

FOR GARBAGE GRINDER, INCREASE DISPOSAL AREA 22% & TANK CAPACITY 50%
(dry well - 125 sq. ft. per bedroom with increase shown)

OTHER Dry well (5) sq. ft. (effective absorbent sidewall area per bedroom below inlet.)

Inlet to be 4 ft. below original grade and maximum depth 104 ft. Location 125 ft. from

left property line and 110 ft. from left rear corner pt. towards road. (Peru Hole 1 & 2)

NOTE: ALL PIPE FROM HOUSE TO DISPOSAL AREA MUST BE CAST IRON

PERMIT VOID AFTER THREE YEARS.


NOTE: INSTALL STAND PIPE ON SEPTIC TANK AND DRY WELL. STAND PIPE MUST BE 6" IN DIA., CAST IRON, CONCRETE OR TERRA COTTA ACCEPTED.

PLANS APPROVED BY C. B. Straker DATE 9/4/75

Fill septic tank and distribution box with water before calling for an inspection. Cover no work until inspected and approved.

NEITHER THE HOWARD COUNTY COMMISSIONERS NOR THE HEALTH DEPARTMENT IS RESPONSIBLE FOR THE SUCCESSFUL OPERATION OF ANY SYSTEM.

18417

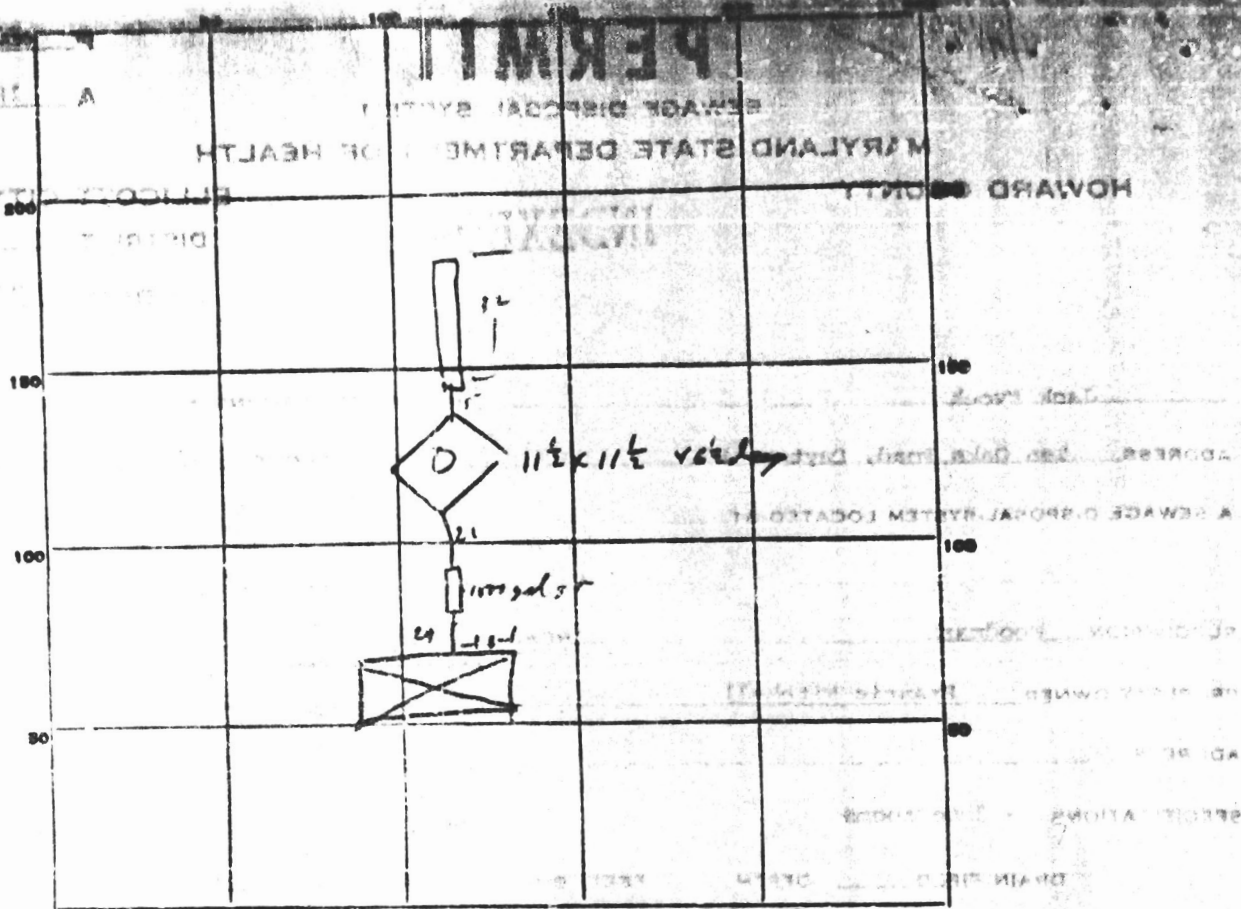

INDICATE NORTH. - NAME ADJOINING ROADWAY AS BASE LINE.

PERMIT CARD ✓

SEPTIC TANK, LEVEL ✓

CLEANOUTS ✓ ✓

DISTRIBUTION BOX, LEVEL

TILE FIELD, DEPTH 10 1/2 FT. TRENCH WIDTH 2 FT.

GRAVEL DEPTH 7 1/2 IN TOTAL LENGTH 32 FT.

NUMBER OF TRENCHES 1 TOTAL BOTTOM AREA 208

SEEPAGE PITS, INSIDE DIAMETER 46 FT. DEPTH BELOW INLET 6 1/2 FT.

ABSORBENT AREA 507 SQ. FT.

REMARKS

DATE SYSTEM APPROVED 9/7/76 INSPECTOR H. Morfitt

APPLICATION

SEWAGE DISPOSAL TESTING

STATE OF MARYLAND - DEPARTMENT OF HEALTH AND MENTAL HYGIENE

HOWARD COUNTY HEALTH DEPARTMENT
ENVIRONMENTAL HEALTH SERVICES
P. O. BOX 476, ELLICOTT CITY, MARYLAND 21043
TELEPHONE: 468-8000, EXT. 396

A. 10617
P. _____
DISTRICT 224
DATE 6-11-75

TO: THE COUNTY HEALTH OFFICER
ELLICOTT CITY, MARYLAND

I, HEREBY, APPLY FOR THE NECESSARY TEST IN ORDER TO CONSTRUCT (OR RECONSTRUCT) A SEWAGE DISPOSAL SYSTEM.

PROPERTY OWNER Mark Wakefield

ADDRESS Carroll Mill Rd, E.C., MD. PHONE 551-5072

PROPERTY LOCATION:

SUBDIVISION Woodmark LOT NO. 39, Blk. F., Sec. 11

ROAD AND DESCRIPTION Unpaved Rd.

SIZE OF LOT 46,500 sq. ft. TYPE BLDG. 3 or 4 Bedrooms
NUMBER OF BEDROOMS

IF NOT SINGLE RESIDENCE DESCRIBE _____

THE SYSTEM INSTALLED UNDER THIS APPLICATION IS ACCEPTABLE ONLY UNTIL PUBLIC FACILITIES BECOME AVAILABLE.

SIGNATURE OF APPLICANT Mark Wakefield /s/


APPROVED BY _____ FOR _____ DATE _____
(KIND OF SYSTEM)

REJECTED BY _____ FOR _____ DATE _____
(KIND OF SYSTEM)

HOLD PENDING FURTHER TESTS _____ DATE _____

REASONS FOR REJECTION OR HOLDING _____

THIS IS NOT A PERMIT

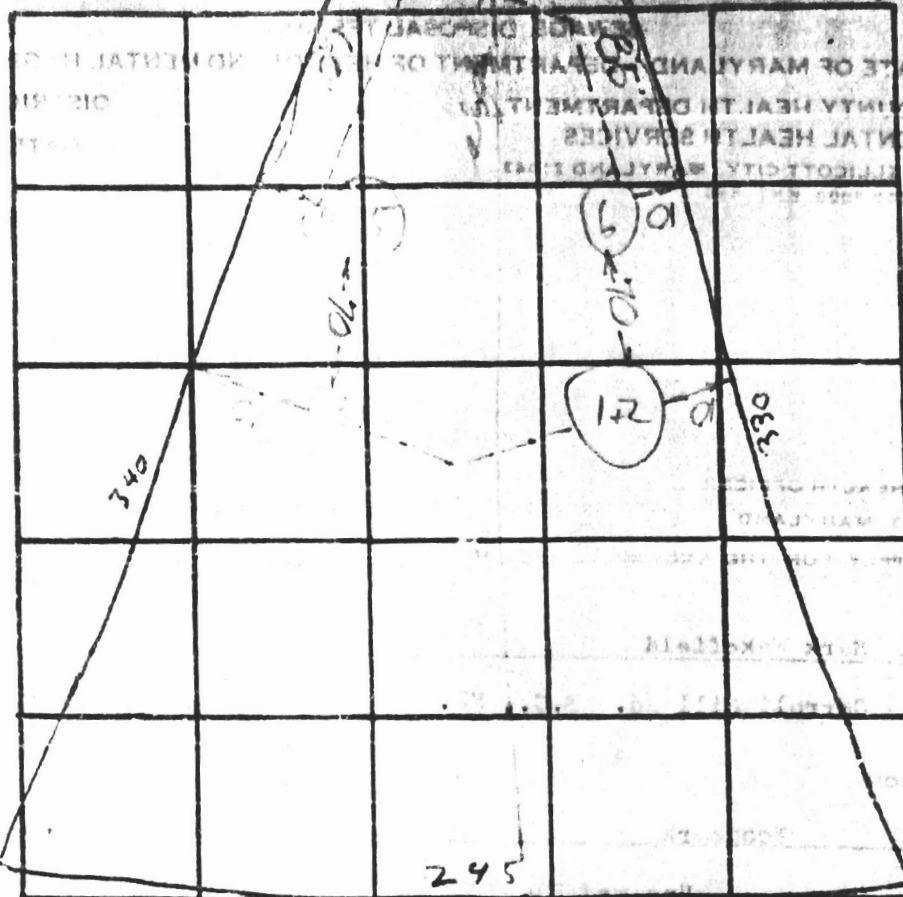

INDICATE NORTH - NAME ADJOINING ROADWAY AS BASE LINE

UNNAMED COURT


TO ECHISON DR

DATE	TEST NO.	DEPTH	PRE-WET		TEST - 1" DROP		TIME
			START	STOP	START	STOP	
	1	4'	3:10	3:14	3:14	3:22	8m
	2	10.2	3:10	3:12	3:12	3:15	3m
	3	11'	Visual similar to 4		3:14		14m
	4	5'	3:06	3:07	3:07	3:09	2m
	5	11'	3:06	3:09	3:09	3:14	5m
	6	1'	Visual similar to 4		3:45		45m
							4/10
							125gpf
							perched

REMARKS

TYPE OF SOIL

Lot 39F
Sect 11

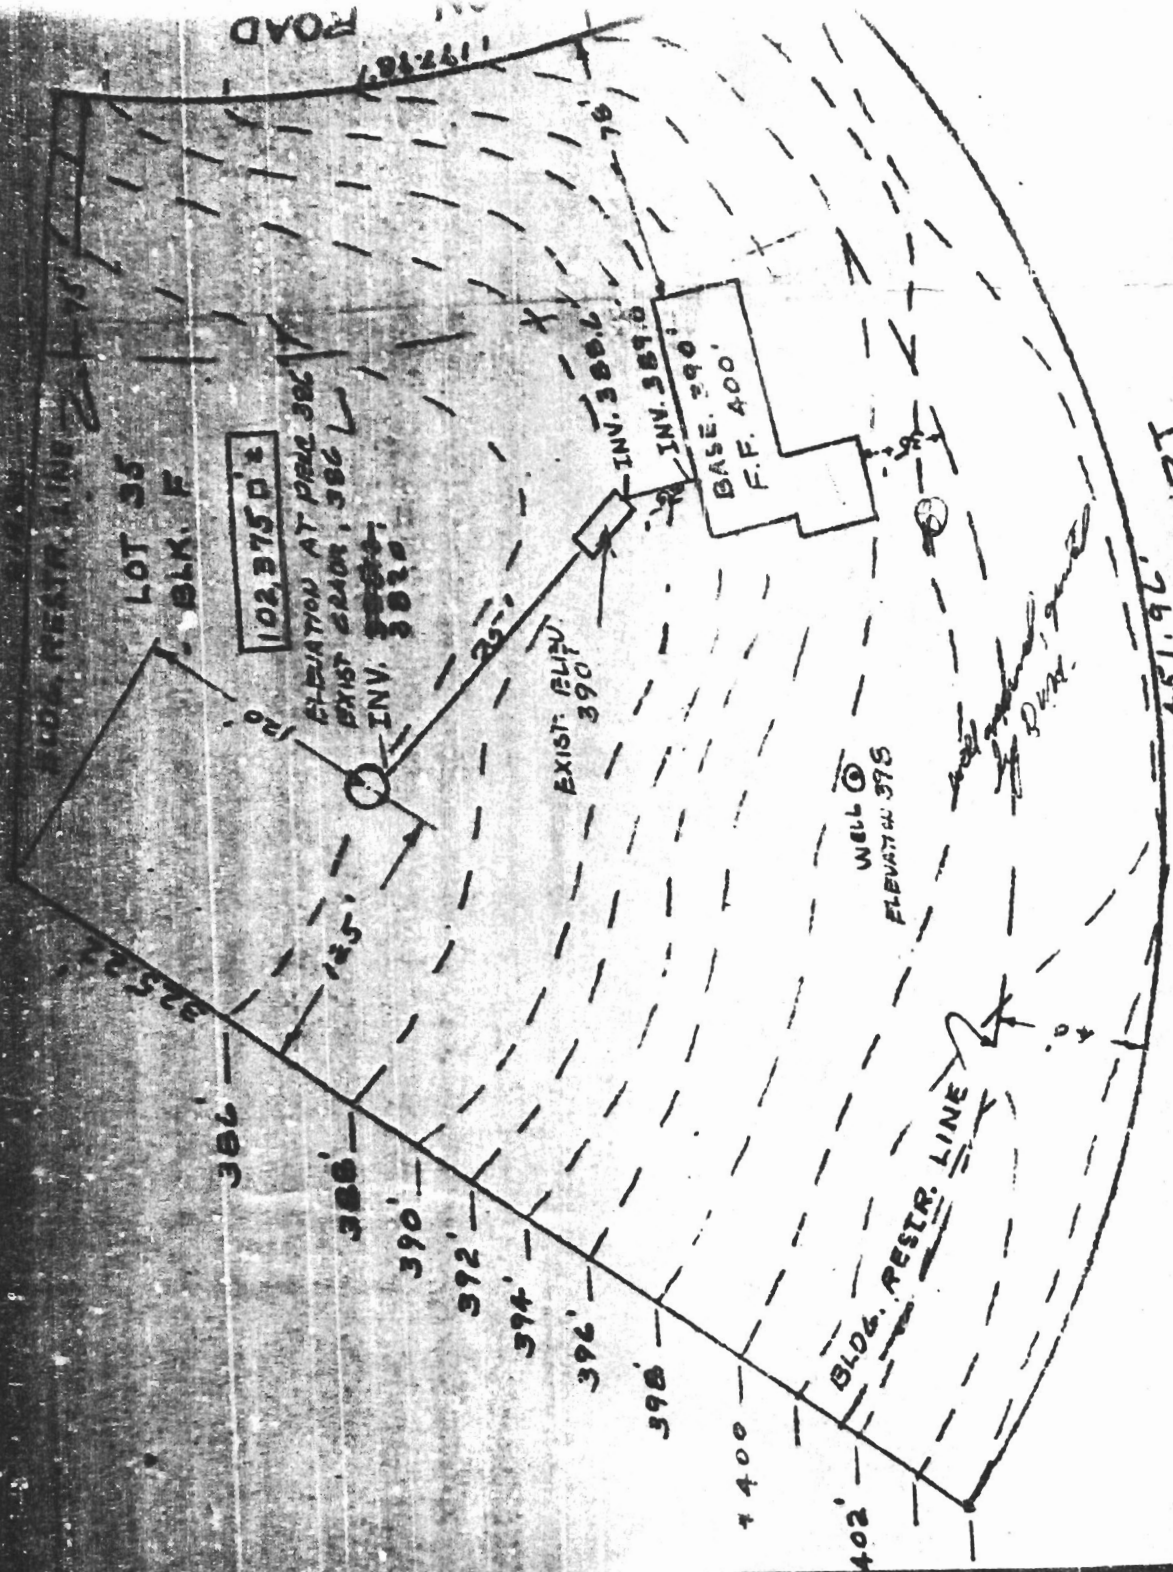

RILLAND COURT

Property known as: **LOT 35 BLOCK "F"**

THIS PLAT CAN NOT BE USED TO ESTABLISH PROPERTY LINES OR CORNERS.


WATERMARK

SECTION 11 SHEET 2 OF 2

PLATBOOK 29 F. 64

3RD ELECTION DISTRICT
HOWARD COUNTY, MD

RILLAND COURT
40' R/W

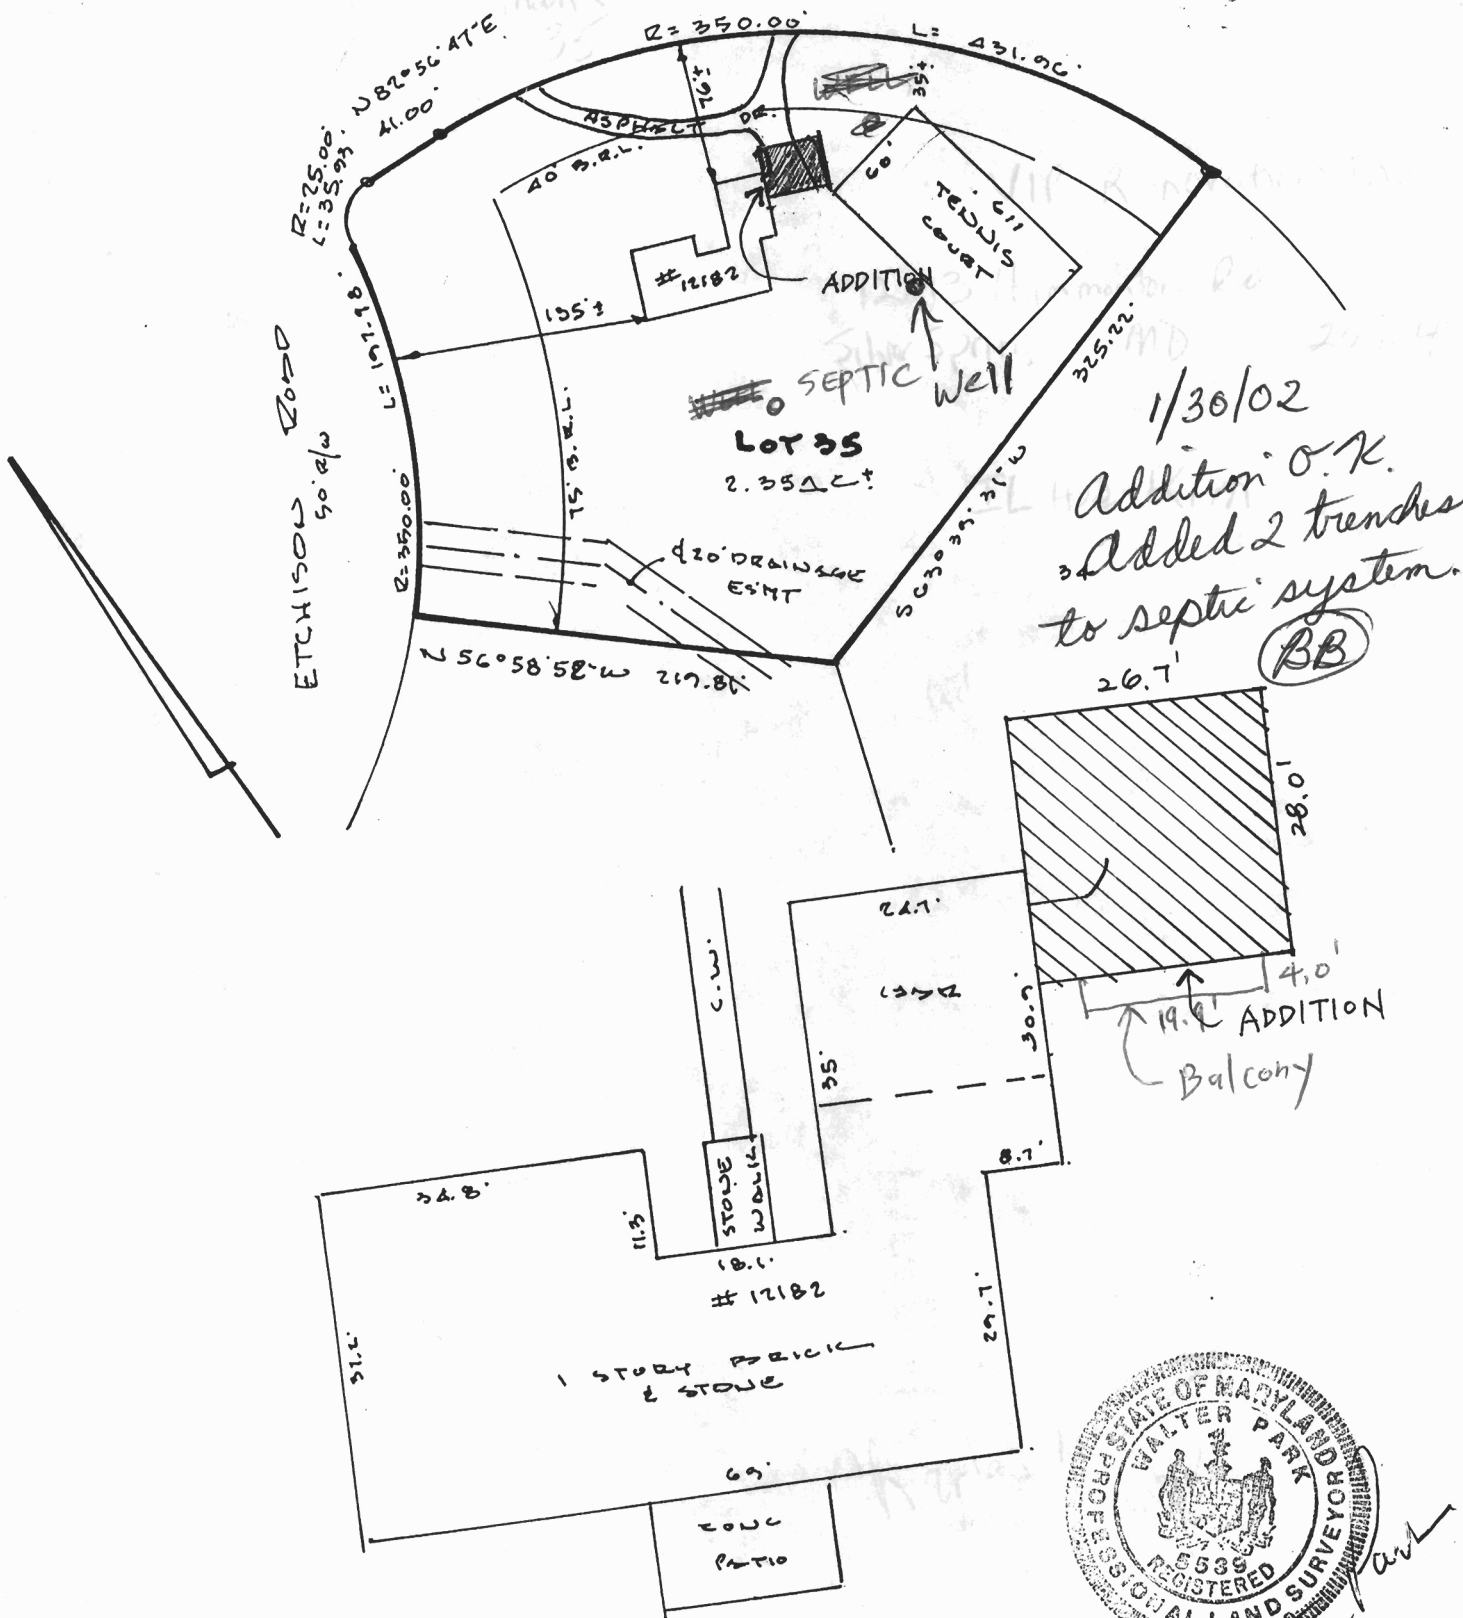

LOCATION SURVEY PLAT


SUBJECT PROPERTY NOT LOCATED IN A FLOOD PLAIN AREA UNLESS OTHERWISE NOTED

CERTIFICATION

This is to certify that I have surveyed
the property known as: 12182
RILLAND COURT

for the purpose of locating the im-
provements thereon, and the improvements
are located as shown.

SEAL

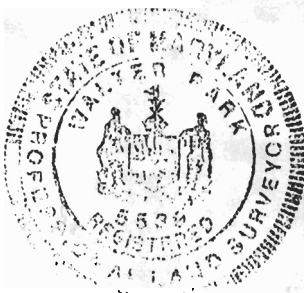

SCALE 1"=100'

DATE 5-6-1997

LDE Inc.

9250 Rumsey Road Suite 106
Columbia, Maryland 21045

(Balt.) 410-715-1070
(Wash.) 301-596-3424
(FAX) 410-715-9540