

ADJ. LOT

PERMIT

SEWAGE DISPOSAL SYSTEM

MARYLAND STATE DEPARTMENT OF HEALTH*

P 39093

A REPAIR

HOWARD COUNTY

BUREAU OF ENVIRONMENTAL HEALTH

461-9933

DATE 4/9/87

DATE SYSTEM APPROVED 3-20-87

INSPECTOR S. Abul

INDEXED

Jack Fyock

IS PERMITTED TO INSTALL ALTER X

ADDRESS PHONE 988-9270

SUBDIVISION Beaufort Park ROAD 8500 Reservoir Road LOT 3, B1K.B

PROPERTY OWNER KEVIN McCracken PHONE: 776-9411

ADDRESS

IF GARBAGE GRINDER IS USED INCREASE SEPTIC TANK CAPACITY BY 50% AND ABSORPTION AREA BY 22%.

GARBAGE GRINDER? YES NO

SEPTIC TANK CAPACITY GALLONS NUMBER OF BEDROOMS

REPAIR - CALL FOR INSPECTION WHEN GROUND IS OPENED UP SO SANITARIAN CAN RECOMMEND REPAIR.

PLANS APPROVED BY C. Williams DATE 3/10/87

COVER NO WORK UNTIL INSPECTED AND APPROVED.

NEITHER THE HOWARD COUNTY COUNCIL NOR THE HEALTH DEPARTMENT IS RESPONSIBLE FOR THE SUCCESSFUL OPERATION OF ANY SYSTEM.

NOTE: CLEANOUT REQUIRED EVERY 70 FEET OF SEWER LINE AND/OR AT 90° SWEEPS IN LINES FROM HOUSE TO DRAIN FIELDS.

NOTE: ALL PARTS OF SEPTIC SYSTEMS (I.E., TANK, DISTRIBUTION BOX, TRENCHES) TO BE 100 FEET FROM WELL. (UNLESS OTHERWISE SPECIFICALLY AUTHORIZED)

NOTE: IF DEEP TRENCH(IES) ARE USED CALL FOR INSPECTION BEFORE AND AFTER PLACING GRAVEL IN TRENCH(IES).

NOTE: NO DRY WELL SHALL EXCEED 15 FOOT IN DIAMETER. NO ABSORPTION TRENCH TO EXCEED 100 FEET IN LENGTH.

NOTE: ALL PIPE FROM HOUSE TO SEPTIC TANK MUST BE CAST IRON OR SCHEDULE 40 PVC OR ABS

PERMIT VOID AFTER TWO YEARS.

NOTE: INSTALL STAND PIPE ON SEPTIC TANK AND DRY WELL. STAND PIPES MUST BE 6 INCHES IN DIAMETER. CAST IRON, CONCRETE OR TERRA COTTA OR PVC OR ABS ACCEPTED. IF TOP OF SEPTIC TANK IS DEEPER THAN 3 FEET, MANHOLE TO GRADE REQUIRED.

NOTE: DISTRIBUTION BOXES MUST HAVE BAFFLES.

BIDG. PERMIT SIGNED

AND RETURNED 4/30/92

Serial # 42376

BIDG. PERMIT SIGNED


AND RETURNED 6/3/91

Serial # 38197

***INSTALLER IS RESPONSIBLE FOR OBTAINING FINAL APPROVAL ON THIS PERMIT**

*CALL 461-9933 FOR INSPECTION OF SEPTIC SYSTEMS.

EH - 2-1186

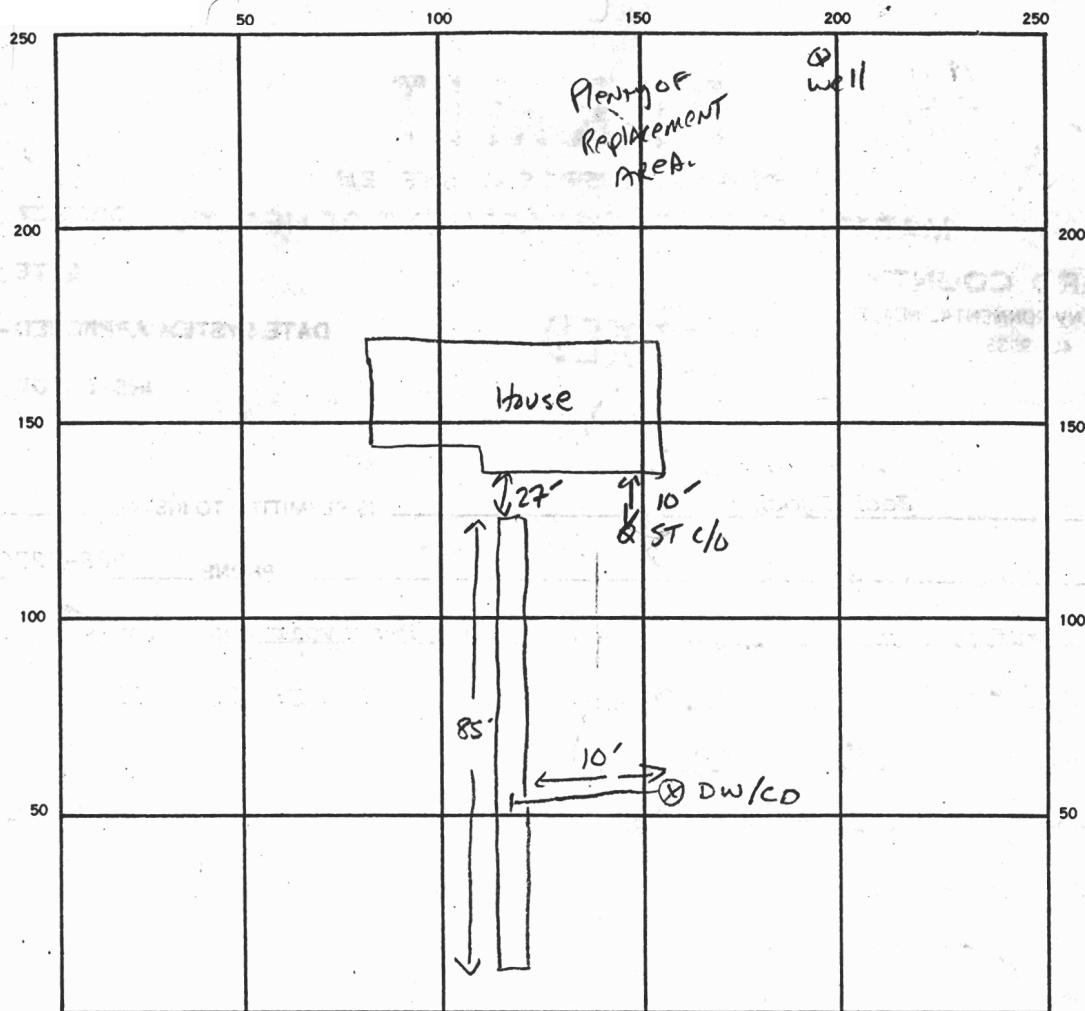

INDICATE NORTH. — NAME ADJOINING ROADWAY AS BASE LINE

Reservoir Rd,

SEPTIC TANK. LEVEL EXISTING CLEANOUTS EXISTING

DISTRIBUTION BOX. LEVEL N/A

DRAIN FIELD/TILE FIELD. DEPTH 11.5-12.5 FT. TRENCH WIDTH 2 FT. INLET DEPTH 4'-5' FT.

EFFECTIVE GRAVEL DEPTH 7.5 FT. TOTAL LENGTH 85 FT.

NUMBER OF TRENCHES 1 ONE SIDEWALL/BOTTOM AREA 637.5 SQ. FT.

DRYWELL INSIDE DIAMETER — FT. EFFECTIVE DEPTH BELOW INLET — FT.

ABSORBENT AREA 637.5 SQ. FT.

REMARKS

DATE SYSTEM APPROVED 3-10-87 INSPECTOR S. Abel

ADD. LOT

A, 17216

PERMIT

SEWAGE DISPOSAL SYSTEM

MARYLAND STATE DEPARTMENT OF HEALTH

HOWARD COUNTY

ELLICOTT CITY

DISTRICT 5th

INDEX

DATE 4/19/75

Arthur Septic Service

IS PERMITTED TO INSTALL 2 ALTER

ADDRESS Box 47 Sandy Spring, Maryland

PHONE 481-1093

SEWAGE DISPOSAL SYSTEM LOCATED AT

UNDIVISION Beaufort Park

ROAD 5400 Reservoir Road

LOT 5, Blk. B, Sec. 2

PROPERTY OWNER Mr. and Mrs. A. Filippone

AUSTIN RUMMOS

ADDRESS 2027 Forest Dale Drive, Hillendale, Maryland

Phone: 494-6883

SPECIFICATIONS & bedrooms

DRAIN FIELD DEPTH FEET, BOTTOM AREA SQ. FT.

SERPENTINE PITS ABSORBENT SIDE-WALL AREA SQ. FT.

SEPTIC TANK CAPACITY 1220 GALLONS

FOR GARBAGE GRINDER, INCREASE DISPOSAL AREA AND TANK CAPACITY

OTHER DRY WELL - To have 115 sq. ft. effective absorbent sidewall area per bedroom below inlet. Inlet to be 3/4 ft. below ground grade and minimum depth 12 ft. Locate dry well 180 ft. from front property line and 15 ft. off left property line as seen when facing lot from road.

NOTE: ALL PIPE FROM HOUSE TO DISPOSAL AREA MUST BE CAST IRON.
PERMIT VOID AFTER THREE YEARS.

NOTE: INSTALL STAND PIPE ON SEPTIC TANK AND DRY WELL. STAND PIPES MUST BE 6 INCHES IN DIAMETER. CAST IRON, CONCRETE OR TERRA COTTA ACCEPTED.

PLANS APPROVED BY Howard Snyder & Charles B. Strecker 6/23/72

FILL SEPTIC TANK AND DISTRIBUTION BOX WITH WATER BEFORE CALLING FOR AN INSPECTION. COVER NO WORK UNTIL INSPECTED AND APPROVED.


NEITHER THE HOWARD COUNTY COMMISSIONERS NOR THE HEALTH DEPARTMENT IS RESPONSIBLE FOR THE SUCCESSFUL OPERATION OF ANY SYSTEM.

17216

115
110

26
26
32

stone
rectly
ated
per 500

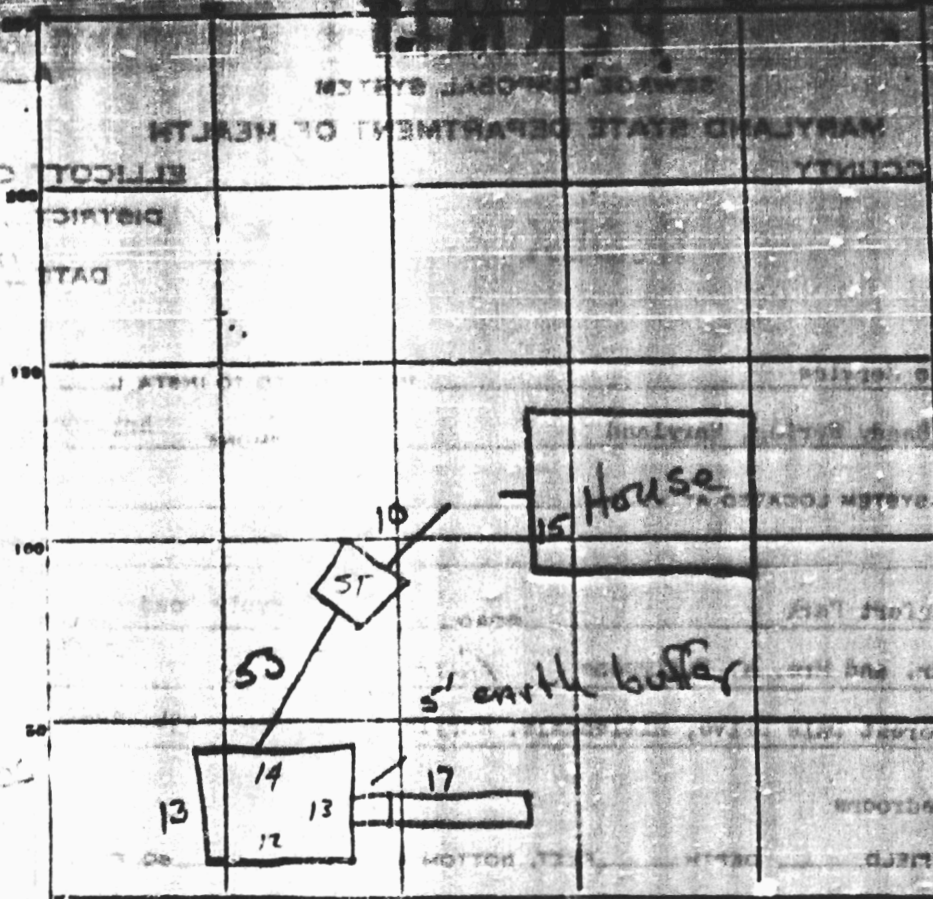

PERMIT CARD 8/23/76 signed W.S.R.F.S.

SEPTIC TANK, LEVEL _____ CLEANOUTS S.T. D.W. both near!

DISTRIBUTION BOX, LEVEL _____

TILE FIELD, DEPTH 10 FT. TRENCH WIDTH 2 FT.

GRAVEL DEPTH 6 IN. TOTAL LENGTH 17 FT.

NUMBER OF TRENCHES 1 1/2 SIDEWALL
TOTAL BOTTOM AREA _____

SEEPAGE PITS, INSIDE DIAMETER 52 FT. DEPTH BELOW INLET 8 FT.

DW ABSORBENT AREA 416 SQ. FT.

REMARKS 8/23/76 Checked down well size & trench size. down well in 10' x 12' trench
is 17' x 10' x 2' o.k. to add gravel in trench. no let pipe installed yet 8-5
8/26/76 - connect system to house in both directions
need 1/2 S. H3 & RAD

DATE SYSTEM APPROVED _____ INSPECTOR _____