

PUB. SEWER STATUS VERIFIED BY _____

ISSUE DATE: _____

APPROVAL DATE: 5/30/1974

**PERMIT
INDEXED**

P 516941-A

A 516941-A

**ON-SITE SEWAGE DISPOSAL SYSTEM
HOWARD COUNTY HEALTH DEPARTMENT
BUREAU OF ENVIRONMENTAL HEALTH**

05-354854

IS PERMITTED TO INSTALL ☐ ALTER ☒

ADDRESS: _____ PHONE NUMBER: _____

SUBDIVISION: Beaufort Park LOT NUMBER: 4, Block B

ADDRESS: 8496 Reservoir Road PROPERTY OWNER: Daniel Lynch

SEPTIC TANK CAPACITY (GALLONS): _____

PUMP CHAMBER CAPACITY (GALLONS): _____

NUMBER OF BEDROOMS: _____

SQUARE FEET PER BEDROOM: _____

LINEAR FEET OF TRENCH REQUIRED: _____

TRENCHES:	Trench to be _____ feet wide. Inlet _____ feet below original grade. Bottom maximum depth _____ feet below original grade. Effective area begins at _____ feet below original grade. _____ feet of stone below distribution pipe.
LOCATION:	_____
PURPOSE:	_____

PLANS APPROVED: _____ DATE: 4/10/1974

NOTE: PERMIT VOID AFTER 2 YEARS

NOTE: CONTRACTOR RESPONSIBLE FOR SCHEDULING A PRE-CONSTRUCTION INSPECTION FOR ALL INSTALLATIONS

NOTE: WATERTIGHT SEPTIC TANKS REQUIRED

NOTE: ALL PARTS OF SEPTIC SYSTEM SHALL BE 100 FEET FROM ANY WATER WELL

NOTE: MANHOLE RISERS REQUIRED ON ALL SEPTIC TANKS AND PUMP CHAMBERS

**NEITHER THE HOWARD COUNTY COUNCIL NOR THE HEALTH DEPARTMENT IS
RESPONSIBLE FOR THE SUCCESSFUL OPERATION OF ANY SYSTEM
PERMITTEE RESPONSIBLE FOR OBTAINING FINAL APPROVAL ON THIS PERMIT
CALL 410-313-2640 FOR INSPECTION OF SEPTIC SYSTEM**

4516941-A

~~ADD LOT NEXT PAGE~~

5/29/94.
before work if possible
5/30/94

Final Check & File
1971
09278

PERMIT

SEWAGE DISPOSAL SYSTEM

MARYLAND STATE DEPARTMENT OF HEALTH

HOWARD COUNTY

ELLICOTT CITY

DISTRICT 7th

DATE 4/10/74

INDEXED

8496 Reservoir Rd

Chris Springer
George Ickes

IS PERMITTED TO INSTALL ☒ ALTER

ADDRESS 6614 Greenvale Parkway, Riverdale, Md. 20840 PHONE 479-0523

A SEWAGE DISPOSAL SYSTEM LOCATED AT

SUBDIVISION Rossmore Park ROAD Reservoir Road LOT 4, Bk. 3

PROPERTY OWNER Mr. George Ickes

ADDRESS 6614 Greenvale Parkway, Riverdale, Md. 20840

SPECIFICATIONS

DRAIN FIELD DEPTH FEET, BOTTOM AREA SQ. FT.

SEPTIC PITS ABSORBENT SIDE-WALL AREA SQ. FT.

TANK CAPACITY 1200 GALLONS

FOR GARAGE GRINDER, INCREASE DISPOSAL AREA 225 & TANK CAPACITY 225.

OTHER DRY WELL - Located 81 ft. from left side line and 120 ft. from front lot line. Inlet to be no deeper than 4 ft. Maximum depth 10 ft. without water is countered. 125 sq. ft. per bedroom. *(300 sq. ft. dry well with 30 ft. trench only. Inspect trench before gravel is installed. If used trench to run from dry well toward right property line.) 400 sq. ft. 8' 20' ft

NOTE: ALL PIPE FROM HOUSE TO DRY WELL MUST BE CAST IRON.

PERMIT VOID AFTER THREE YEARS.

NOTE: INSTALL STAND PIPE ON SEPTIC TANK AND DRY WELL.

PLANS APPROVED BY R.D. Fletcher and Fred Frommelt DATE 1/8/63 & 3/29/73

FILL SEPTIC TANK AND DISTRIBUTION BOX WITH WATER BEFORE CALLING FOR AN INSPECTION. COVER NO WORK UNTIL INSPECTED AND APPROVED.

THE HOWARD COUNTY COMMISSIONERS NOR THE HEALTH DEPARTMENT IS RESPONSIBLE FOR THE SUCCESSFUL OPERATION OF ANY SYSTEM.


09278

June 19

24
17

56
2
372
168
566
144
704

24
6
144

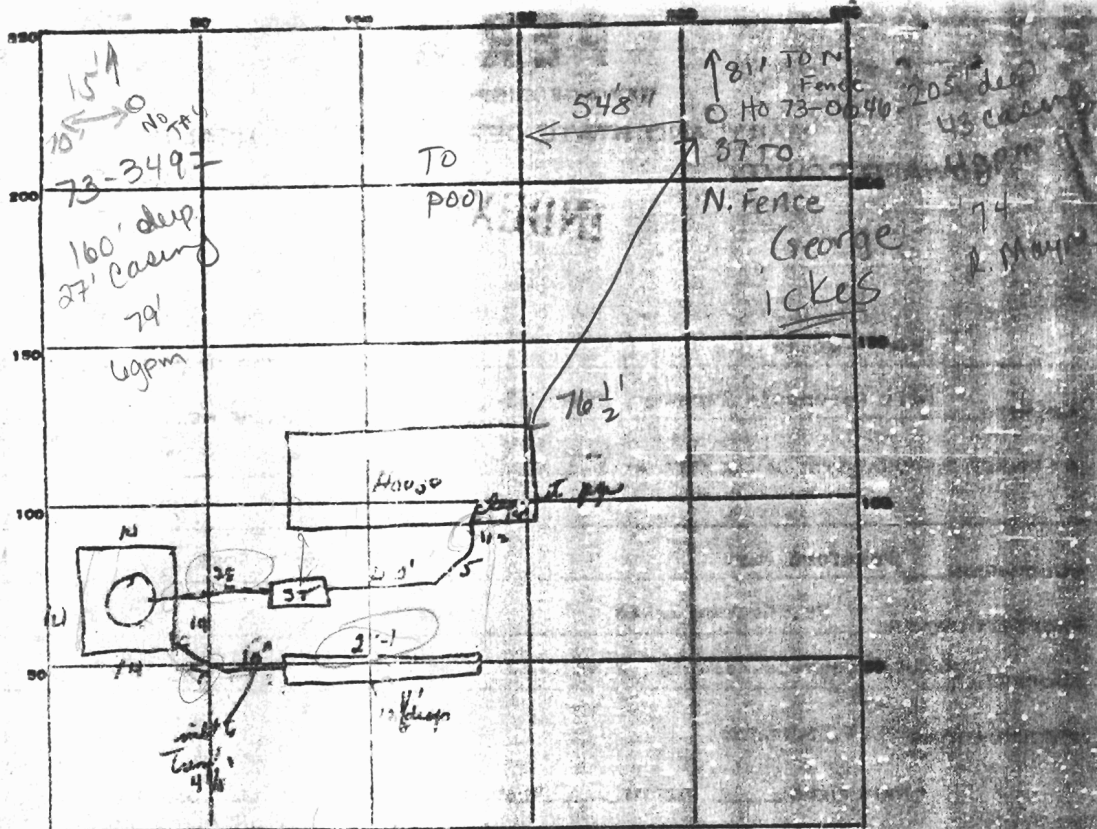

INDICATE NORTH - NAME ADJOINING ROADWAY AS BASE LINE.

PERMIT CARD ☒ signed cover all work

S.T.

D.W.

SEPTIC TANK, LEVEL ☒

CLEANOUTS ☒

DISTRIBUTION BOX, LEVEL ☐

TILE FIELD, DEPTH 12 1/2 FT. TRENCH WIDTH 2 FT.

GRAVEL DEPTH 6 1/2 IN. TOTAL LENGTH 24 FT.

NUMBER OF TRENCHES 1 TOTAL BOTTOM AREA 48 sq. ft.

SEEPAGE PITS, INSIDE PERIMETER 56 FT. DEPTH BELOW INLET 7 FT.

ABSORBENT AREA 2704 sq. ft. as per 5/29/74 inspection

REMARKS 5-29-74 - OK to put gravel in trench; OK to connect line from house to
1' of tank 5/30/74 trench OK; cement around pipe to septic tank OK;
signed permit card cover all work. F.S. & C.B.S.

DATE SYSTEM APPROVED 5/30/74 BY Inspector F. Skinner