

MARYLAND DEPARTMENT OF THE ENVIRONMENT, WATER MANAGEMENT ADMINISTRATION  
2500 BROENING HIGHWAY, BALTIMORE, MARYLAND 21224, (410) 631-3784

\*\*\*\*\*  
WATER WELL ABANDONMENT-SEALING REPORT FORM  
\*\*\*\*\*

SUBMIT COPIES OF COMPLETED FORM TO:

- \* COUNTY ENVIRONMENT AGENCY (contact MDE, WMA if address needed)
- \* WELL OWNER
- \* MDE, WATER MANAGEMENT ADMINISTRATION, WELL PROGRAM

DATE WELL ABANDONED: 10/30/02 (month/day/year)

\* PERMIT NUMBER OF ABANDONED WELL (if any) \_\_\_\_\_

\* PERMIT NUMBER OF REPLACEMENT WELL \_\_\_\_\_

\* PERSON ABANDONING WELL: Allen Conly


WELL DRILLERS LICENSE NUMBER: 009

CIRCLE: MWD/MSD/MGD

\* OWNER'S NAME: J. A. Smith & Company  
James Harvey

SITE LOCATION MAP

\* WELL LOCATION:  
COUNTY: Howard  
NEAREST TOWN: Ellicott City  
TAX MAP \_\_\_\_\_ BLOCK \_\_\_\_\_ PARCEL \_\_\_\_\_  
SUBDIVISION: \_\_\_\_\_  
SECTION: \_\_\_\_\_ LOT: \_\_\_\_\_  
NEAREST ROAD: Sylvan Lane (3531)

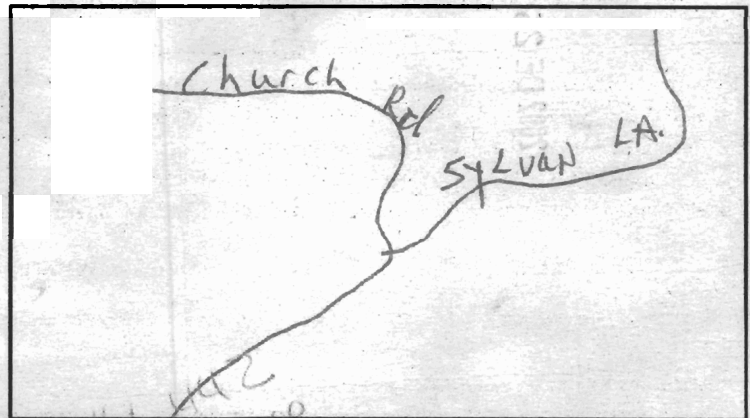

\* TYPE OF WELL BEING ABANDONED:

☒ DRILLED ☐ JETTED  
☐ BORED/AUGERED ☐ HAND DUG  
☐ OTHER (specify) \_\_\_\_\_

\* USE CODE:

☒ DOMESTIC ☐ MUNICIPAL/PUBLIC  
☐ IRRIGATION ☐ INDUSTRIAL  
☐ TEST/OBSERVATION ☐ GEOTHERMAL

\* TYPE OF CASING:

☒ STEEL ☐ PLASTIC  
☐ CONCRETE ☐ OTHER (specify) \_\_\_\_\_

\* SIZE OF CASING: 12 INCHES IN DIAMETER

\* DEPTH OF WELL: 120 FEET DEEP

\* WAS ANY CASING REMOVED? ☐ YES ☒ NO  
if yes, length removed, in feet: \_\_\_\_\_

WAS CASING RIPPED OR PERFORATED? ☐ YES ☒ NO

LOG OF SEALING MATERIAL

MATERIAL	FEET	
	FROM	TO
<u>Cement</u>	<u>0</u>	<u>120</u>
VOLUME OF MATERIAL USED		
<u>28 bags</u>		

SIGNATURE-MASTER WELL DRILLER OR SUPERVISING SANITARIAN

LICENSE #

MWD/MSD/MGD  
CIRCLE ONE

DATE



## HOWARD COUNTY HEALTH DEPARTMENT

Bureau of Environmental Health  
3525-H Ellicott Mills Drive, Ellicott City, Maryland 21043-4544  
(410) 313-2640 FAX (410) 313-2648  
TDD (410) 313-2323 Toll Free 1-877-4MD-DHMH

faxed to  
all parties  
this date

*Penny E. Borenstein, M.D., M.P.H., County Health Officer*

October 10, 2002

### MEMORANDUM

TO: James Harvey  
3531 Sylvan Lane  
Ellicott City, MD 21043

FROM: Mark Rifkin (MR)  
Well and Septic Program

RE: Request for County Financing of Water Connection  
3531 Sylvan Lane

The Health Department recommends approval of County financing of the public water connection for the referenced property.

During an inspection conducted October 10, 2002, an existing drilled well was observed in the front yard, and the wellhead was observed to be flush with grade. You and/or your relative have reported the well is about 40 years old and contains about 40 feet of water. Remediation of the existing water supply is not likely to be successful and cost-effective, and immediate replacement of the well is not believed to be possible.

The Health Department supports provision of an alternate water supply to the referenced property.

Once the public water connection is complete, please arrange for proper filling of the existing well by a well driller. A list of well drillers is enclosed.

MR  
cc: Charlotte Dryden, Office of Real Estate Services  
File