

PERMIT

SEWAGE DISPOSAL SYSTEM

MARYLAND STATE DEPARTMENT OF HEALTH

HOWARD COUNTY

INDEXED

ELLCOTT CITY

DISTRICT 25

DATE 7/5/75

1-16-75
System complete
P. 20300
A.

70

File

JENKINS BROS.
~~XXXXXXXXXX~~

IS PERMITTED TO INSTALL ALTER X

ADDRESS Old Frederick Road, Ellicott City, Md. PHONE 467-6846

A SEWAGE DISPOSAL SYSTEM LOCATED AT _____

SUBDIVISION _____ ROAD SPR System Lane LOT _____

PROPERTY OWNER Mrs. Ray House

ADDRESS SPR System Lane, Ellicott City, Md. PHONE 467-6846

SPECIFICATIONS

DRAIN FIELD _____ DEPTH _____ FEET, BOTTOM AREA _____ SQ. FT.

SEWAGE PITS + ABSORBENT SIDE-WALL AREA 15' x 10' SQ. FT.

SEPTIC TANK CAPACITY 1000 GALLONS metal tank 1/4/75.

FOR GARBAGE GRINDER, INCREASE DISPOSAL AREA AND TANK CAPACITY SEE _____

OTHER SEWER REPAIR - Call for inspection when ground is opened up so protection

can recommend repair system. 7/9/74 To be discussed. They indicated

over for repair. Probabley driveway 2 1/2' sq. ft.

SEPTIC TANK 1250 - ~~5000~~ DAY WORK


17' x 7' deep tank with

PLANS APPROVED BY Palmer F. Wigg DATE 7/5/75 / 1/15/75

FILL SEPTIC TANK AND DISTRIBUTION BOX WITH WATER BEFORE CALLING FOR AN INSPECTION. COVER NO WORK UNTIL INSPECTED AND APPROVED.

NEITHER THE HOWARD COUNTY COMMISSIONERS NOR THE HEALTH DEPARTMENT IS RESPONSIBLE FOR THE SUCCESSFUL OPERATION OF ANY SYSTEM.

20300

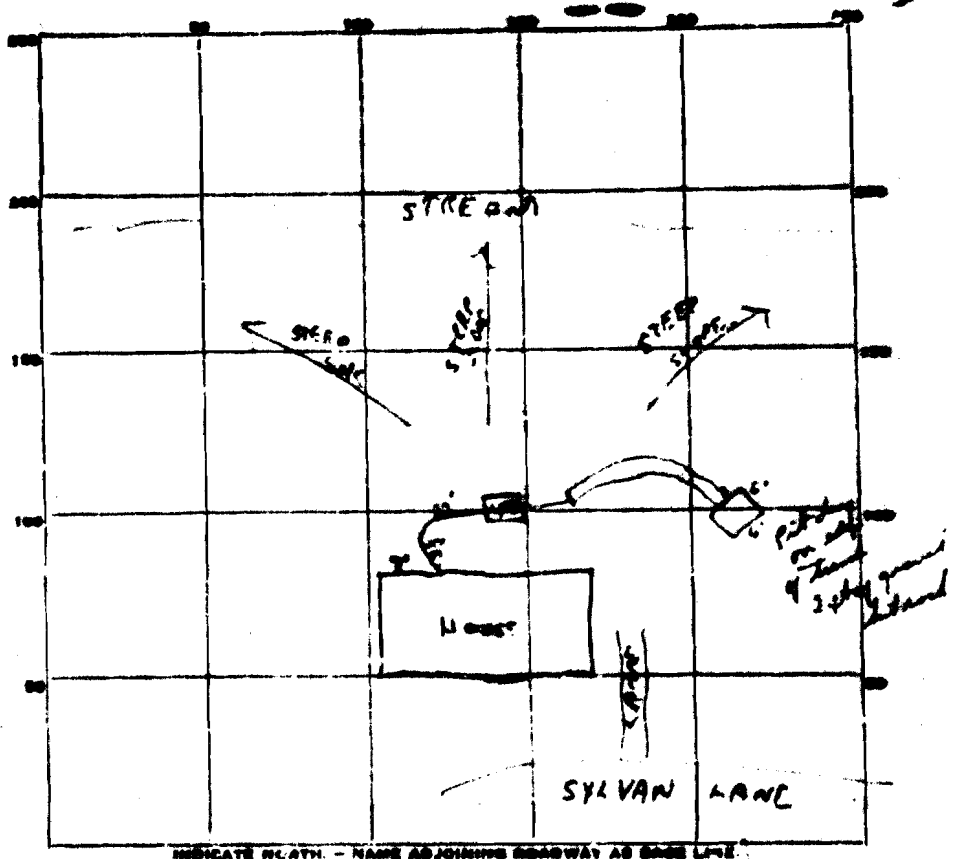

PERMIT CARD _____

SEPTIC TANK, LEVEL _____

CLEARINGS _____

DISTRIBUTION BOX, LEVEL _____

TRENCH

FIELD, DEPTH 8-11 FT. TRENCH WIDTH 2-4 FT.

GRAVEL DEPTH 5 ft approx. TOTAL LENGTH 40 FT.

NUMBER OF TRENCHES 1

TOTAL DRAINAGE AREA 243 sq. ft. with pit

SEEPAGE PITS, INSIDE DIAMETER _____ FT. DEPTH BELOW INLET _____ FT.

ABSORBENT AREA _____ SQ. FT.

REMARKS

1-16-75 - Metal tank and small system installed

due to limited amount of area and drastic slope.

H. Z. & R. T.

DATE SYSTEM APPROVED

1-16-75

INSPECTOR

R. T. & H. Z.