

8/21/02
2-3-00
9/18/02
1-2
PUB. SEWER STATUS VERIFIED BY MR

ISSUE DATE:

7/16/02

APPROVAL DATE:

9/18/02

**PERMIT
INDEXED**

P 517358

A REPAIR

**ON-SITE SEWAGE DISPOSAL SYSTEM
HOWARD COUNTY HEALTH DEPARTMENT
BUREAU OF ENVIRONMENTAL HEALTH**

04-320409

JACK FLOCK

IS PERMITTED TO INSTALL ☐ ALTER ☒

ADDRESS:

PHONE NUMBER:

SUBDIVISION: Rover Mill Estates

LOT NUMBER: 11

ADDRESS: 13885 Rover Mill Road

PROPERTY OWNER: James/Susanna Coffey

SEPTIC TANK CAPACITY (GALLONS):

1500

*KEEP the two 1,000 gal
tanks + drywell*

PUMP CHAMBER CAPACITY (GALLONS):

N/A

NUMBER OF BEDROOMS:

5

SQUARE FEET PER BEDROOM:

180

LINEAR FEET OF TRENCH REQUIRED:

225

TRENCHES:	Trench to be 2.0 feet wide. Inlet <u>3</u> feet below original grade. Bottom maximum depth <u>7</u> feet below original grade. Effective area begins at <u>3-4</u> feet below original grade. <u>4</u> feet of stone below distribution pipe.
LOCATION:	Add new trench(es) perpendicular to existing to allow trench(es) to run on level ground. <u>(3) 75' TRENCHES</u>
PURPOSE:	Install new tank to provide at least 1500 gallons total capacity. Excavate to top of existing trench to verify state of operation. Install additional trench(es) to support five bedrooms and to replace existing failed trench, if necessary.

PLANS APPROVED: MER

DATE: 7/8/02

NOTE: PERMIT VOID AFTER 2 YEARS

NOTE: CONTRACTOR RESPONSIBLE FOR SCHEDULING A PRE-CONSTRUCTION INSPECTION FOR ALL INSTALLATIONS

NOTE: WATERTIGHT SEPTIC TANKS REQUIRED

NOTE: ALL PARTS OF SEPTIC SYSTEM SHALL BE 100 FEET FROM ANY WATER WELL


NOTE: MANHOLE RISERS REQUIRED ON ALL SEPTIC TANKS AND PUMP CHAMBERS

**NEITHER THE HOWARD COUNTY COUNCIL NOR THE HEALTH DEPARTMENT IS
RESPONSIBLE FOR THE SUCCESSFUL OPERATION OF ANY SYSTEM
PERMITTEE RESPONSIBLE FOR OBTAINING FINAL APPROVAL ON THIS PERMIT
CALL 410-313-2640 FOR INSPECTION OF SEPTIC SYSTEM**

**BUILDING PERMIT SIGNED
AND RETURNED**

4/2/2003 B06140992 INGROUND POOL

P517358

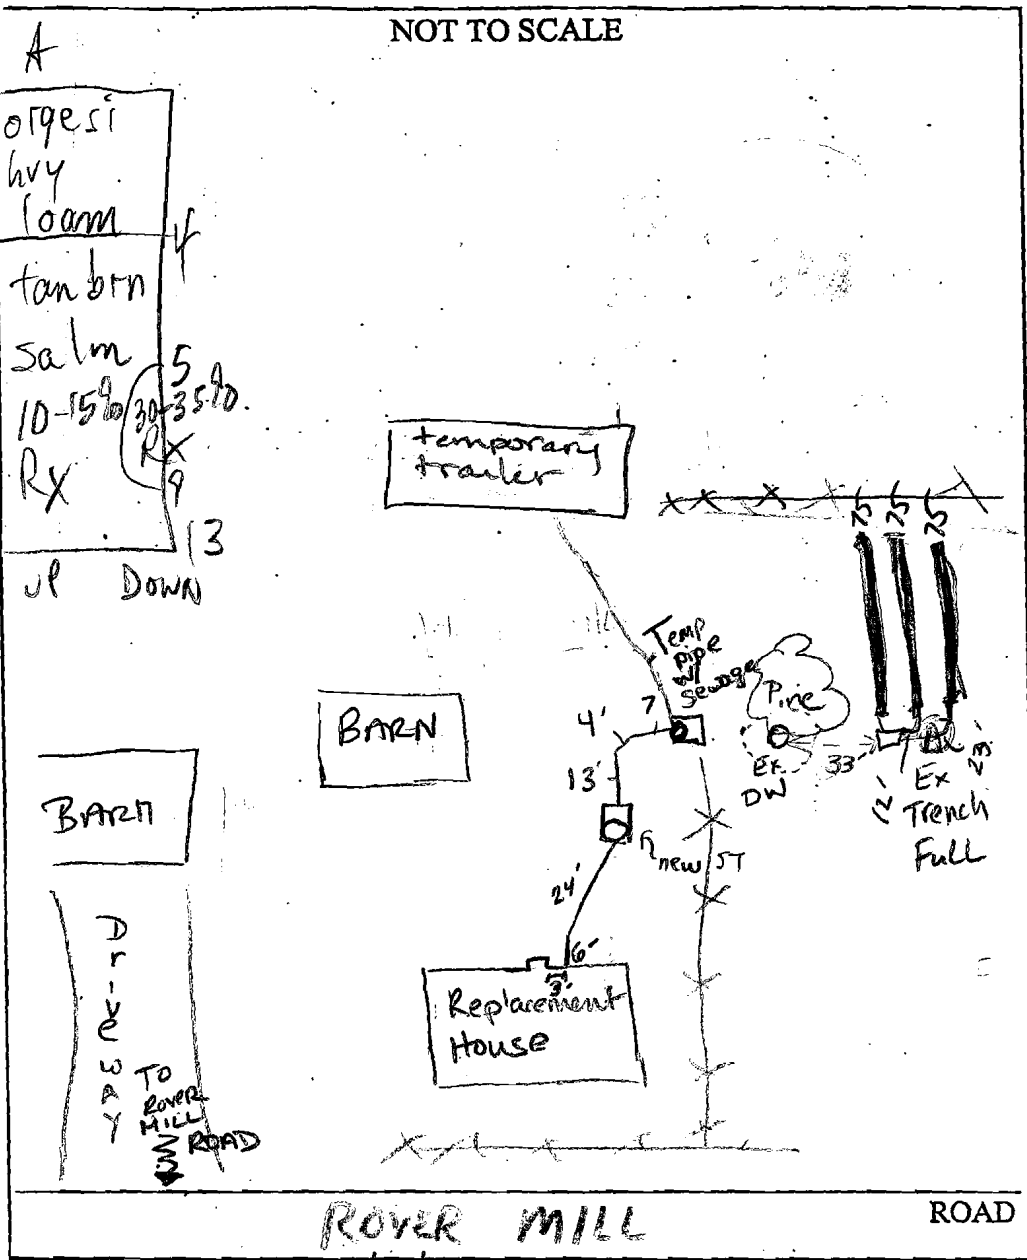

TRENCH/DRAINFIELD DATA		
WIDTH	INLET	BOTTOM
2'	3'	7'
NUMBER OF TRENCHES		
3		
TOTAL LENGTH		
225'		
ABSORPTION AREA		
900ft ²		
DISTRIBUTION BOX LEVEL		
✓		
DISTRIBUTION BOX BAFFLE		
—		
DISTRIBUTION BOX PORT		
N/A		

SEPTIC TANK DATA	
SEPTIC TANK 1 LEVEL ✓ NEW	
0	CAPACITY 1000 GAL
1000	SEAM LOC top
↑	TANK LID DEPTH 2-3'
1000	BAFFLES ✓
↑	BAFFLE FILTER NO
1000	MANHOLE LOC Front
↑	6" PORT LOC NO
1000	WATERTIGHT TEST NA
↑	SEPTIC TANK 2 LEVEL ✓ ex.
1000	CAPACITY 1000 GAL
↑	SEAM LOC Mid?
1000	TANK LID DEPTH 2-3'
↑	BAFFLES ✓
1000	BAFFLE FILTER NA
↑	MANHOLE LOC Front
1000	6" PORT LOC NO
↑	WATERTIGHT TEST NA

PRE-CONSTRUCTION 8/13/02 NEW S.T. ADDED; EX. TRENCH LOCATED, FULL;
 OK TO START 5 BR REPL. SYSTEM (HR)
 INSTALLATION 9/18/02 The three trenches run from the existing
 perpendicular trench. D.B. is 33' from dry well cleanout.
 OK TO COVER all three trenches. Maintaining dry well and
 the two → septic tanks. (KN)

FINAL INSPECTOR Lacie Norman DATE OF APPROVAL 9/18/02

12/2/76
after lunch please
12/1/76
12/3/76

PERMIT

SEWAGE DISPOSAL SYSTEM

MARYLAND STATE DEPARTMENT OF HEALTH

HOWARD COUNTY

INDEXED

ELLICOTT CITY

DISTRICT 4th

DATE 11/30/76

William Kellum

IS PERMITTED TO INSTALL ☒ ALTER

ADDRESS Box 22 C, Stoney Run Road, Hanover, Md 21076 PHONE 796-2366

A SEWAGE DISPOSAL SYSTEM LOCATED AT

SUBDIVISION (Rover Mill Estates) 13885 ROAD Rover Mill Road LOT 11

PROPERTY OWNER ~~Mr. Woodrow Thompson~~

JAMES + Susanna Coffey

ADDRESS

SPECIFICATIONS 3 bedrooms

DRAIN FIELD DEPTH FEET, BOTTOM AREA SQ. FT.

SEEPAGE PITS ABSORBENT SIDE-WALL AREA SQ. FT.

SEPTIC TANK CAPACITY 1000 GALLONS

FOR GARBAGE GRINDER, INCREASE DISPOSAL AREA 22% & TANK CAPACITY 80%.

OTHER DRY WELL AND TRENCH - To have 150 sq. ft. effective absorbent sidewall area per bedroom below inlet. Inlet to be at 3 ft. below original grade and maximum depth 11 ft. below original grade. Trench to be 32 ft. long with 5 ft. earth buffer between dry well and trench. Locate dry well and trench as shown on approved house plans.

NOTE: CALL FOR INSPECTION OF TRENCH BEFORE PLACING STONE IN TRENCH.

NOTE: ALL PIPE FROM HOUSE TO DISPOSAL AREA MUST BE CAST IRON.

PERMIT VOID AFTER THREE YEARS.

NOTE: INSTALL STAND PIPE ON SEPTIC TANK AND DRY WELL. STAND PIPES MUST BE 6 INCHES IN DIAMETER. CAST IRON, CONCRETE OR TERRA COTTA ACCEPTED.

PLANS APPROVED BY Charles B. Streaker DATE 9/17/76

NOTE CHANGED TIME OF PERC INDICATED
FILL SEPTIC TANK AND DISTRIBUTION BOX WITH WATER BEFORE CALLING FOR AN INSPECTION. COVER NO WORK UNTIL INSPECTED AND APPROVED. ONLY 150 FT. TRENCH REQUIRED

NEITHER THE HOWARD COUNTY COMMISSIONERS NOR THE HEALTH DEPARTMENT IS RESPONSIBLE FOR THE SUCCESSFUL OPERATION OF ANY SYSTEM.

permit for carport
signed 11/6/78

BLDG. PERMIT SIGNED

AND RETURNED 8/19/78

Serial # 66315

prebaca

37739

23776

