

# APPLICATION

A 23776

## SEWAGE DISPOSAL TESTING

P. \_\_\_\_\_

STATE OF MARYLAND - DEPARTMENT OF HEALTH AND MENTAL HYGIENE

HOWARD COUNTY HEALTH DEPARTMENT  
ENVIRONMENTAL HEALTH SERVICESP. O. BOX 476, ELLICOTT CITY, MARYLAND 21043  
TELEPHONE: 465-5000, EXT. 356

DISTRICT \_\_\_\_\_

DATE \_\_\_\_\_

1000 gallons

1250 gallons

8/25/76

1:30

Maximum depth of trench 11' - inlet to be 3'

Call for 2 inspections of  
trench (1 before gravel + 1 after)

TO: THE COUNTY HEALTH OFFICER

ELLICOTT CITY, MARYLAND

I, HEREBY, APPLY FOR THE NECESSARY TEST IN ORDER TO CONSTRUCT (OR RECONSTRUCT) A SEWAGE  
DISPOSAL SYSTEM.

PROPERTY OWNER

Woodrow Thompson

ADDRESS \_\_\_\_\_

PHONE \_\_\_\_\_

PROPERTY LOCATION \_\_\_\_\_

SUBDIVISION

(Rover Ridge Estates)LOT NO. 11

ROAD AND DESCRIPTION

Rover Ridge Rd. (see original application)

SIZE OF LOT

5.552 acres

TYPE BLDG.

3

NUMBER OF BEDROOMS

IF NOT SINGLE RESIDENCE DESCRIBE \_\_\_\_\_

THE SYSTEM INSTALLED UNDER THIS APPLICATION IS ACCEPTABLE ONLY UNTIL PUBLIC  
FACILITIES BECOME AVAILABLE.

SIGNATURE OF APPLICANT

W. Woodrow Thompson

APPROVED BY

C. B. Betherken

FOR

Dry Well + Trench

DATE

9/17/76

(KIND OF SYSTEM)

REJECTED BY \_\_\_\_\_

FOR \_\_\_\_\_

DATE \_\_\_\_\_

(KIND OF SYSTEM)

HOLD PENDING FURTHER TESTS \_\_\_\_\_

DATE \_\_\_\_\_

REASONS FOR REJECTION OR HOLDING

for certified holes in proximity  
of new house site.BLDG. PERMIT SIGNED  
AND RETURNED 9/17/76

# THIS IS NOT A PERMIT



# APPLICATION

Woodrow Thompson

A 20946

## SEWAGE DISPOSAL TESTING

P \_\_\_\_\_

STATE OF MARYLAND - DEPARTMENT OF HEALTH AND MENTAL HYGIENE

HOWARD COUNTY HEALTH DEPARTMENT  
ENVIRONMENTAL HEALTH SERVICES

3 BR - 1000 gal ST

DISTRICT

4xx

P. O. BOX 476, ELLICOTT CITY, MARYLAND 21043  
TELEPHONE: 465-5000, EXT. 356

4 BR - 1250 gal ST

DATE

11/15/74

\* Dry well(s): 145 sq ft effective absorbent sidewall area per bedroom below the first 3 1/2 - 4 ft of non absorbent soil at original grade. Maximum depth of DW to be 11 1/2 ft. Locate Dry well(s) 286 ft back from the 279.02' property line, and 93 ft in from the 1301.64' property line. \* If trenches are to be used in lieu of DW(s), call this office for permission and recommendation.

TO: THE COUNTY HEALTH OFFICER

ELLICOTT CITY, MARYLAND

I, HEREBY, APPLY FOR THE NECESSARY TEST IN ORDER TO CONSTRUCT (OR RECONSTRUCT) A SEWAGE DISPOSAL SYSTEM.

PROPERTY OWNER Edward and Evelyn Keenan

ADDRESS 3015 A Oak Green Circle, Ellicott City 21043

PHONE 465-9541

PROPERTY LOCATION:

SUBDIVISION Rover Mill Estates

LOT NO. 11

ROAD AND DESCRIPTION Rover Mill Rd. - Rte. 144 to Pepperhorn Rd. - Right on Rover Mill Rd. - street to city lkw. in.

SIZE OF LOT ~~XXXXXSZ~~ 5.552 Acres

TYPE BLDG. 3

NUMBER OF BEDROOMS

IF NOT SINGLE RESIDENCE DESCRIBE \_\_\_\_\_

THE SYSTEM INSTALLED UNDER THIS APPLICATION IS ACCEPTABLE ONLY UNTIL PUBLIC FACILITIES BECOME AVAILABLE.

SIGNATURE OF APPLICANT Edward Keenan


APPROVED BY William H. Zepp FOR dry well(s) DATE 11/20/74  
(KIND OF SYSTEM)

REJECTED BY \_\_\_\_\_ FOR \_\_\_\_\_ DATE \_\_\_\_\_  
(KIND OF SYSTEM)

HOLD-PENDING-FURTHER-TESTS WWZ DATE 11/17/74

REASONS FOR REJECTION OR HOLDING final plat

# THIS IS NOT A PERMIT

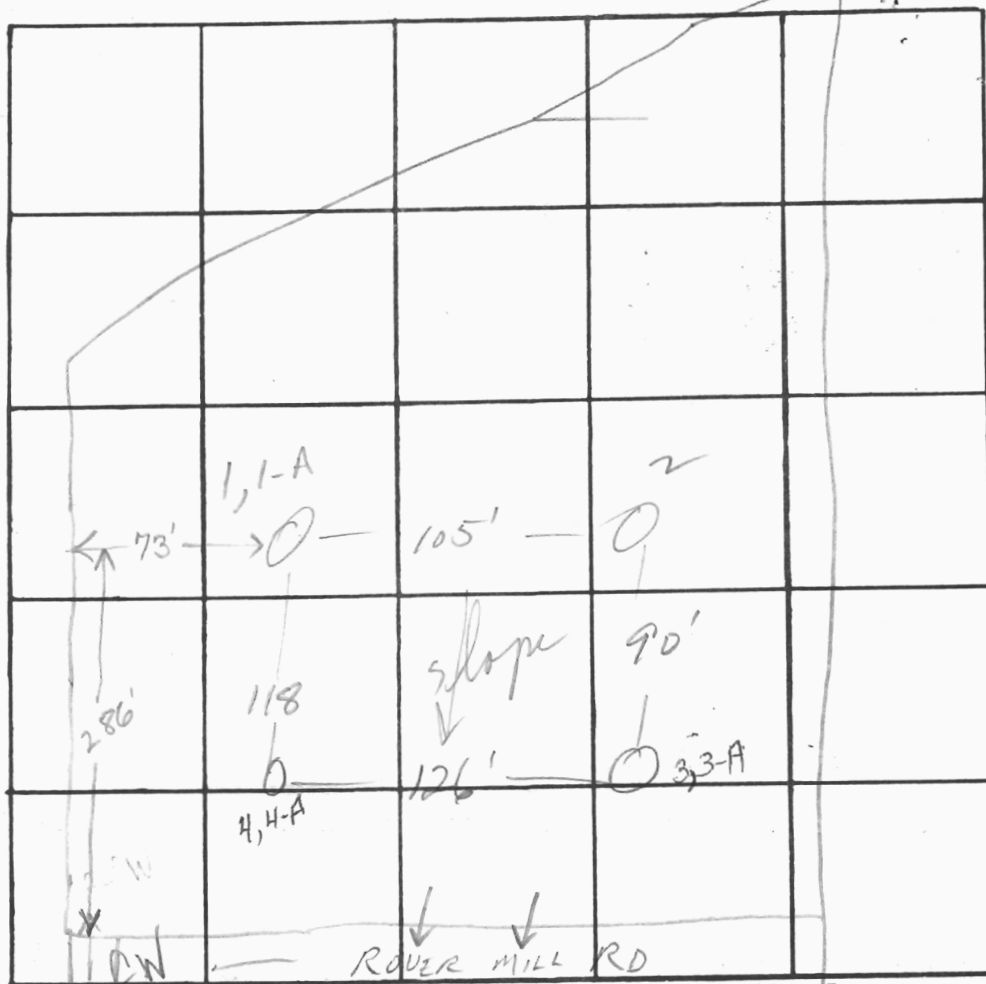

DATE	TEST NO.	DEPTH	PRE-WET		TEST - 1" DROP		TIME
			START	STOP	START	STOP	
	1	4	10:02	10:04	10:04	10:07	3
	1-A	11	10:01	10:06	10:06	10:11	5
	2	12	Visual; sim to				
	3	4 1/2	10:13	10:25	10:25	10:37	12
	3-A	11 1/2	10:13	10:25	10:25	10:38	13
	4	—	Not tested; sim to #3				
	4-A	11	10:23	10:33	10:33	10:55	22

$\bar{t} = 11 \text{ min}$   
 120 #/BR  
 +  
 20% - 24 #/BR  
 145 #/BR  
 good soil @ 4 1/2 - 5'

REMARKS \_\_\_\_\_

TYPE OF SOIL clayey - silty

TESTED BY WWE ALSO PRESENT: WWE

January 29, 2002

Mr. George Beisser  
Department of Planning and Zoning  
3430 Courthouse Drive  
Ellicott City MD 21043

Mr. George Beisser,

My family and I hereby request a Special Exception regarding the placement of mobile homes on our property. We lost our entire home to a fire last week. Our property is situated on almost six private acres in western Howard County.


As we have dogs, cats, horses, sheep and cattle, we need to be at the property to properly oversee them. My three children all attend the public schools system and ride a bus to school.

We will be re-building a home on the property as soon as the insurance company gives us the go-ahead.

We appreciate your attention to this situation. We are hoping that you will accommodate us promptly in this time of need.

If you should have any questions, our temporary number is 410 489 3636. Our close friend, Tracy Griffin, will be your contact for initial questions as she is helping us to get the proper permits etc. She may be reached at 410 984 2501.

Very Sincerely,

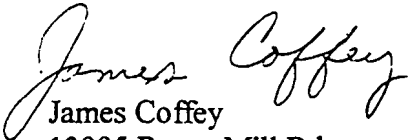  
James Coffey  
13885 Rover Mill Rd  
West Friendship, MD 21794

# APPLICATION

A 23776

## SEWAGE DISPOSAL TESTING

P \_\_\_\_\_

STATE OF MARYLAND - DEPARTMENT OF HEALTH AND MENTAL HYGIENE

HOWARD COUNTY HEALTH DEPARTMENT  
ENVIRONMENTAL HEALTH SERVICES

P. O. BOX 476, ELLICOTT CITY, MARYLAND 21043  
TELEPHONE: 465-5000, EXT. 356

DISTRICT 1-3 Bedrooms

1000 gallons

DATE 8/24/76

1250 gallons

Septic Tank { 4 Bedrooms

8/25/76 1:30  
absorbent sidewall area per bedroom below inlet. Inlet to be 3' below original grade and maximum depth 11'. Trench to be 32' long with 5' earth fluffer between dry well and trench. Maximum depth of trench 11' - inlet to be 3'.  
Call for 2 inspections of trench (1 before gravel + 1 after).  
House plans 32' x 35' long.  
250' / 250' side hole  
25/76 per 1.10.11  
2 test

TO: THE COUNTY HEALTH OFFICER  
ELLICOTT CITY, MARYLAND

I, HEREBY, APPLY FOR THE NECESSARY TEST IN ORDER TO CONSTRUCT (OR RECONSTRUCT) A SEWAGE DISPOSAL SYSTEM.

PROPERTY OWNER Woodrow Thompson

ADDRESS \_\_\_\_\_ PHONE \_\_\_\_\_

PROPERTY LOCATION \_\_\_\_\_

SUBDIVISION (Rover Ridge Estates) LOT NO. 11

ROAD AND DESCRIPTION Rover Ridge Rd. (see original application)

SIZE OF LOT 5.552 acres TYPE BLDG. 3

NUMBER OF BEDROOMS

IF NOT SINGLE RESIDENCE DESCRIBE \_\_\_\_\_

THE SYSTEM INSTALLED UNDER THIS APPLICATION IS ACCEPTABLE ONLY UNTIL PUBLIC FACILITIES BECOME AVAILABLE.

SIGNATURE OF APPLICANT W. Woodrow Thompson

APPROVED BY C. B. Betheaker FOR Dry Well + Trench DATE 9/17/76  
(KIND OF SYSTEM)

REJECTED BY \_\_\_\_\_ FOR \_\_\_\_\_ DATE \_\_\_\_\_  
(KIND OF SYSTEM)

HOLD PENDING FURTHER TESTS \_\_\_\_\_ DATE \_\_\_\_\_

REASONS FOR REJECTION OR HOLDING for certified holes in proximity of new house site.

BLDG. PERMIT SIGNED 9/17/76  
AND RETURNED

# THIS IS NOT A PERMIT



# APPLICATION

Woodrow Thompson

A 20946

## SEWAGE DISPOSAL TESTING

P

STATE OF MARYLAND - DEPARTMENT OF HEALTH AND MENTAL HYGIENE

HOWARD COUNTY HEALTH DEPARTMENT  
ENVIRONMENTAL HEALTH SERVICES

3 BR - 1000 gal ST  
4 BR - 1250 gal ST

DISTRICT

4 XL

P. O. BOX 476, ELLICOTT CITY, MARYLAND 21043

DATE

11/15/74

TELEPHONE: 465-5000, EXT. 356

\* Dry well(s): 145 sq ft effective absorbent sidewall area per bedroom below the first 3 1/2 - 4 ft of non absorbent soil at original grade. Maximum depth of DW to be 11 1/2 ft. Locate Dry well(s) 286 ft back from the 279.02' property line, and 73 ft in from the 1301.64' property line. \* If trenches are to be used in lieu of DW(s), call this office for permission and recommendation.

TO: THE COUNTY HEALTH OFFICER

ELLICOTT CITY, MARYLAND

I, HEREBY, APPLY FOR THE NECESSARY TEST IN ORDER TO CONSTRUCT (OR RECONSTRUCT) A SEWAGE DISPOSAL SYSTEM.

PROPERTY OWNER Edward and Evelyn Keenan

ADDRESS 3015 A Oak Green Circle, Ellicott City 21043 PHONE 465-9541

PROPERTY LOCATION:

SUBDIVISION Rover Mill Estates

LOT NO. 11

ROAD AND DESCRIPTION Rover Mill Rd. - Rte. 144 to Pepperhorn Rd. - Right on Rover Mill Rd. - street to city lkw. in.

SIZE OF LOT ~~XXXXXXS~~ 5.552 Acres

TYPE BLDG. 3

NUMBER OF BEDROOMS

IF NOT SINGLE RESIDENCE DESCRIBE

THE SYSTEM INSTALLED UNDER THIS APPLICATION IS ACCEPTABLE ONLY UNTIL PUBLIC FACILITIES BECOME AVAILABLE.

SIGNATURE OF APPLICANT Edward Keenan


APPROVED BY William H. Jepp FOR Dry well(s) DATE 11/20/74  
(KIND OF SYSTEM)

REJECTED BY FOR DATE  
(KIND OF SYSTEM)

HOLD-PENDING FURTHER TESTS WWT DATE 11/17/74

REASONS FOR REJECTION OR HOLDING final plot

# THIS IS NOT A PERMIT

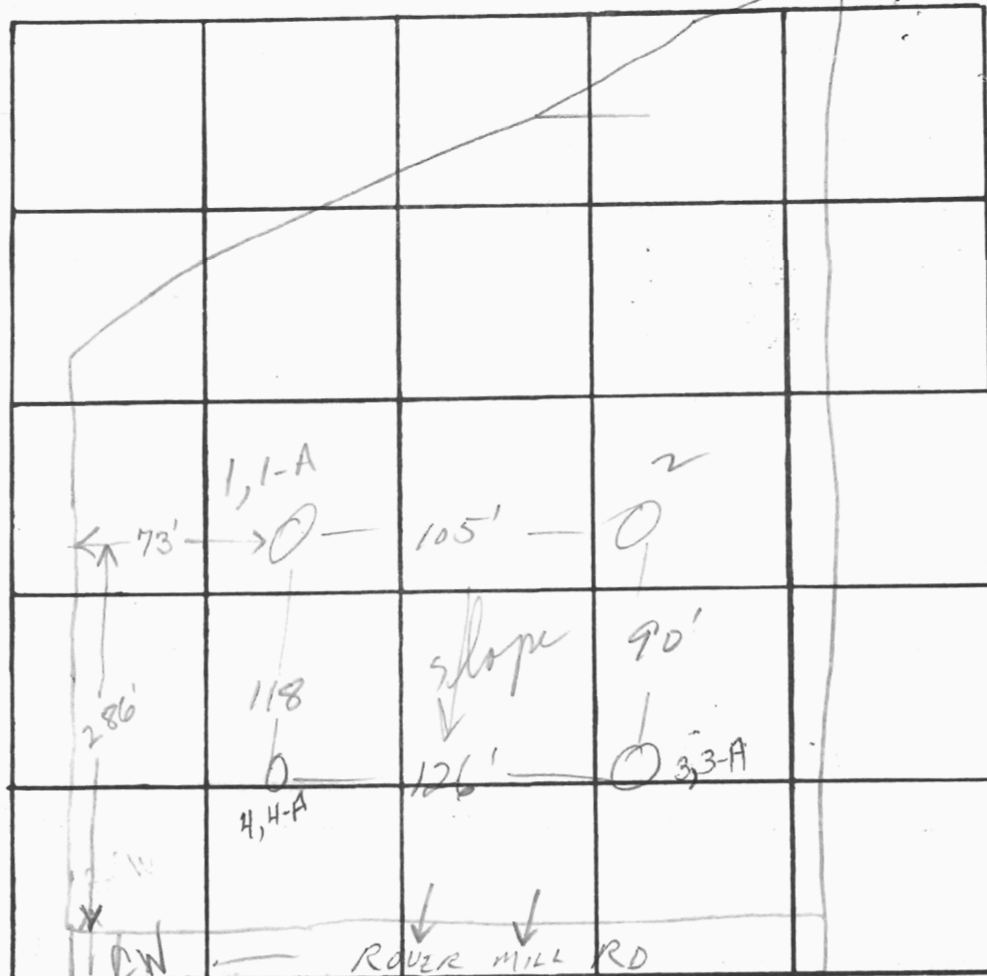

DATE	TEST NO.	DEPTH	PRE-WET		TEST - 1" DROP		TIME
			START	STOP	START	STOP	
	1	4	10:02	10:04	10:04	10:07	3
	1-A	11	10:01	10:06	10:06	10:11	5
	2	12	Visual; sim to				
	3	4 1/2	10:13	10:25	10:25	10:37	12
	3-A	11 1/2	10:13	10:25	10:25	10:38	13
	4	—	Not tested; sim to #3				
	4-A	11	10:23	10:33	10:33	10:55	22

$\bar{t} = 11 \text{ min}$   
 120 #/BR  
 +  
 20% ~ 24 #/BR  
 145 #/BR  
 good soil  
 @ 4 1/2 ~ 5'

REMARKS

TYPE OF SOIL

TESTED BY

ALSO PRESENT:

January 29, 2002

Mr. George Beisser  
Department of Planning and Zoning  
3430 Courthouse Drive  
Ellicott City MD 21043

Mr. George Beisser,

My family and I hereby request a Special Exception regarding the placement of mobile homes on our property. We lost our entire home to a fire last week. Our property is situated on almost six private acres in western Howard County.

As we have dogs, cats, horses, sheep and cattle, we need to be at the property to properly oversee them. My three children all attend the public schools system and ride a bus to school.

We will be re-building a home on the property as soon as the insurance company gives us the go-ahead.

We appreciate your attention to this situation. We are hoping that you will accommodate us promptly in this time of need.

If you should have any questions, our temporary number is 410 489 3636. Our close friend, Tracy Griffin, will be your contact for initial questions as she is helping us to get the proper permits etc. She may be reached at 410 984 2501.

Very Sincerely,

A handwritten signature in cursive script, appearing to read "James Coffey".

James Coffey  
13885 Rover Mill Rd  
West Friendship, MD 21794

A23776

SEC. 40.41E

SEC. 41E


N 26° 40' 53" W

489.30'

N 73° 07' 57" W

S 12° 58' 33" W 279.02'

LOT 11  
5.552 Ac. ±

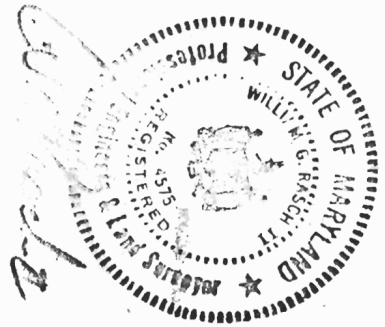

JOHN J. JESCHKE

REGISTERED  
COUNTY CLERK  
HARFORD COUNTY, MARYLAND

NOTE: The lot shown hereon complies with minimum ownership width and is required by the Maryland State Department of Health Regulations.

APPROVED: For Private Water and Private Sewerage Systems, Howard County Health Department.

*[Signature]*  
County Health Officer

11/21/74  
Date