


APPLICATION

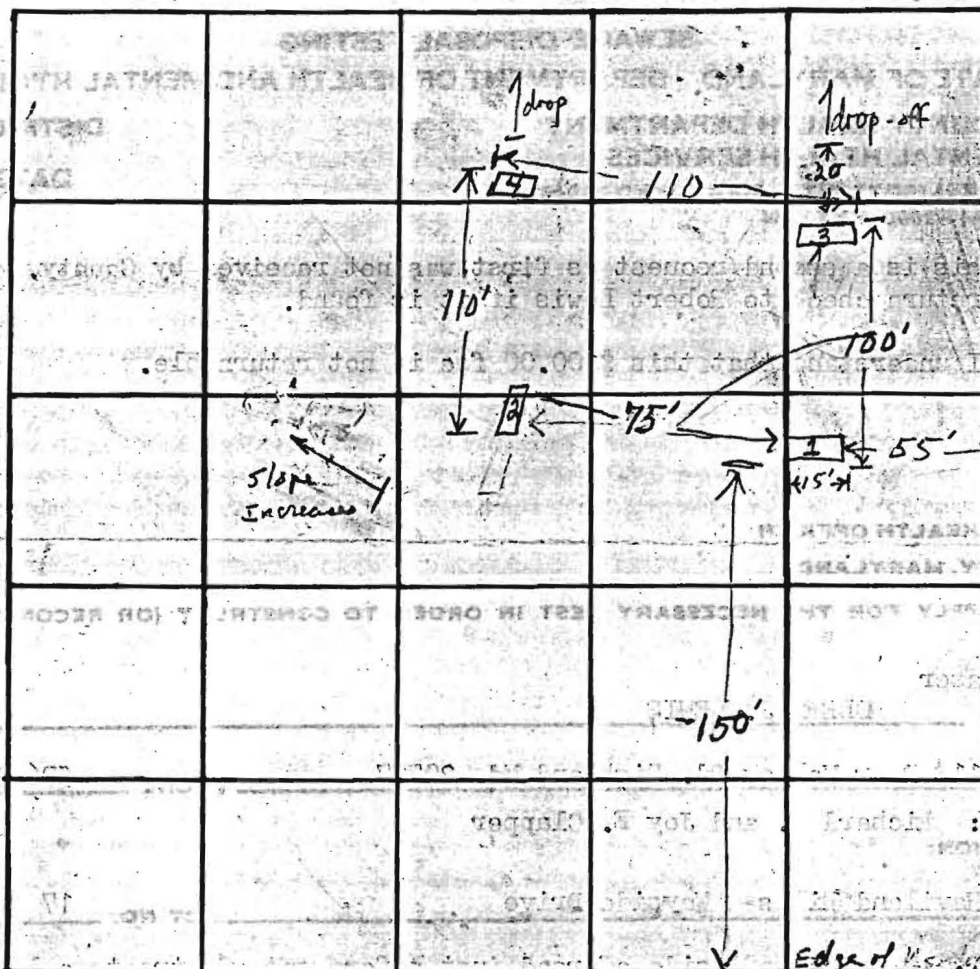

Hole #1:
0-4 sandy clay
4-12 1/2 sand, some
rotten rock
Hole #2: same as
#1

Hole #3:
0-5 Sand
Rotten rock
5-10 Sand & rotten
shale (gray)

10-13 sandy
(some clay)
Hole #4:
0-4 clay
sand
4-13 Sphagnum
sand

INDICATE NORTH. - NAME ADJOINING ROADWAY AS BASE LINE
Wayside Drive

DATE	TEST NO.	DEPTH	PRE-WET		TEST - 1" DROP		TIME
			START	STOP	START	STOP	
High	1s	4 1/2	1013	1014	1014	101630	2 1/2
	1d	12 1/2	1013	1016	1016	1020	4
	2s	3'	1038	1041	1041	1044	3
	2d	13'	visual - same as #1				
	3s	4	1103	1106	1106	1110	4
Low	3d	13	1104	1107	1107	1115	8
	4s	3 1/2	1118			1120	-
	4d	13	1118	1122	1122	1129	7
	skull @ 2', 3' back from 4s		1126	1127	1127	1128	1

ok as per
F.F. 11/3/77

Thomas L. Oyle

REMARKS

TYPE OF SOIL

APPLICATION

SEWAGE DISPOSAL TESTING

STATE OF MARYLAND - DEPARTMENT OF HEALTH AND MENTAL HYGIENE

HOWARD COUNTY HEALTH DEPARTMENT
ENVIRONMENTAL HEALTH SERVICES

P. O. BOX 476, ELLICOTT CITY, MARYLAND 21043
TELEPHONE: 465-5000, EXT. 356

DISTRICT 5th

DATE _____

NOTE: This is a second request as first was not received by County. Please void and return check to Robert Lewis if it is found.

I understand that this \$100.00 fee is not returnable.

TO: THE COUNTY HEALTH OFFICER
ELLICOTT CITY, MARYLAND

I, HEREBY, APPLY FOR THE NECESSARY TEST IN ORDER TO CONSTRUCT (OR RECONSTRUCT) A SEWAGE DISPOSAL SYSTEM.

Contract Purchaser

PROPERTY OWNER ROBERT J. LEWIS

ADDRESS 7118 Deer Valley Rd. Highland Md. 20777 PHONE 596-3552

Property Owners: Richard K. and Joy E. Clapper
PROPERTY LOCATION:

SUBDIVISION Haviland Hills Wayside Drive LOT NO. 17

ROAD AND DESCRIPTION on left side of road just before end of street all wooded lot

SIZE OF LOT 126,328 sq. ft. TYPE BLDG. 4 bedrooms
NUMBER OF BEDROOMS

IF NOT SINGLE RESIDENCE DESCRIBE _____

THE SYSTEM INSTALLED UNDER THIS APPLICATION IS ACCEPTABLE ONLY UNTIL PUBLIC FACILITIES BECOME AVAILABLE.

SIGNATURE OF APPLICANT [Signature]


APPROVED BY Thomas P. Oyle FOR Dry Well & Trench DATE 11/8/77
(KIND OF SYSTEM)

REJECTED BY _____ FOR _____ DATE _____
(KIND OF SYSTEM)

HOLD PENDING FURTHER TESTS _____ DATE _____

REASONS FOR REJECTION OR HOLDING _____

THIS IS NOT A PERMIT

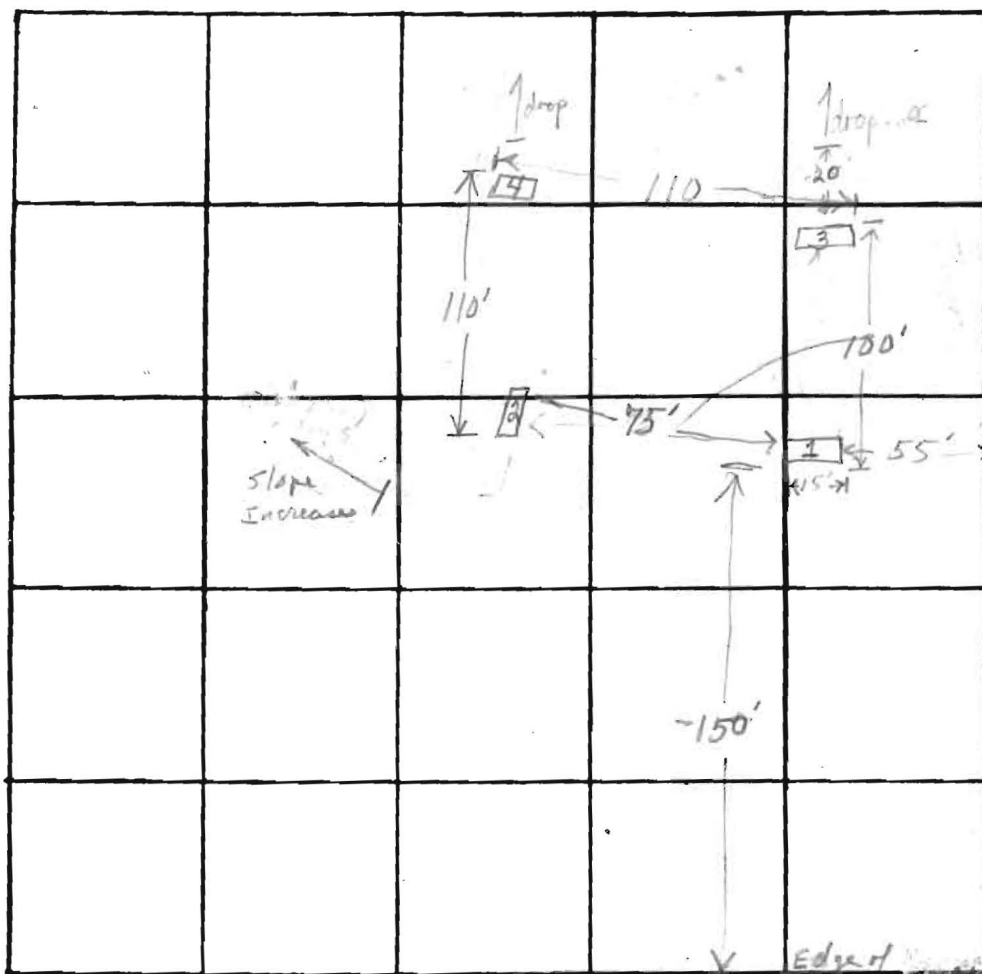

INDICATE NORTH. - NAME ADJOINING ROADWAY AS BASE LINE
Wayside Drive

Hole #1:
0-4' sandy clay, lean
4-12 1/2' sand, some
rotten rock
Hole #2: same as
#1

Hole #3:
0-5' Sand
Rotten rock
5-10' Sand & rotten
shale (gray)
10-13' sandy
(some clay)

Hole #4:
0-4' clayey
sand
4-13' Spherosylt
sand

DATE	TEST NO.	DEPTH	PRE-WET		TEST - 1" DROP		TIME	
			START	STOP	START	STOP		
11/3/77	1s	4 1/2	1013	1014	1014	1016:30	2 1/2	
	1d	12 1/2	1013	1016	1016	1020	4	
	2s	3'	1038	1041	1041	1044	3	
	2d	13'	Visual - same as #1					
	3s	4	1103	1106	1106	1110	4	
	3d	13	1104	1107	1107	1115	8	
	4s	3 1/2	1118			1120	-	
	4d	13	1118	1122	1122	1129	17	
	skull @ 2' 3" back from 4s		1126	1127	1127	1128	1	

4.2 min/avg.
time

OK as per
F.F. 11/3/77

Thomas L. Ogle

REMARKS _____

TYPE OF SOIL _____

