

APPLICATION

SEWAGE DISPOSAL TESTING

MARYLAND STATE DEPARTMENT OF HEALTH

HOWARD COUNTY

ELLICOTT CITY

DISTRICT 3rd

DATE 12/1/72

TO: THE COUNTY HEALTH OFFICER
ELLICOTT CITY, MARYLAND

I, HEREBY, APPLY FOR THE NECESSARY TESTS IN ORDER TO CONSTRUCT OR RECONSTRUCT A SEWAGE DISPOSAL SYSTEM.

PROPERTY OWNER Allan C. Driver and Wife

ADDRESS 1340 Driver Rd., Marriottsville, Md. PHONE 328-2329

PROPERTY LOCATION:

SUBDIVISION Driver Subdivision

LOT NO. 1 Blk. 1 Sec. 4

ROAD AND DESCRIPTION Road "A"

OCCUPANT _____ PHONE _____

PERSON TO CONSTRUCT SYSTEM _____

ADDRESS _____ PHONE _____

SIZE OF LOT 41,000 sq. ft. TYPE BLDG. 3 or 4 bedrooms

NUMBER OF BEDROOMS

IF NOT SINGLE RESIDENCE DESCRIBE _____

SIGNATURE OF APPLICANT /s/ Allan C. Driver

APPROVED BY _____ FOR _____ DATE _____

NAME OF OFFICIAL


RECEIVED BY _____ FOR _____ DATE _____

NAME OF OFFICIAL

HOLD PENDING FURTHER TESTS _____ DATE _____

REASONS FOR REJECTION OR HOLDING _____

THIS IS NOT A PERMIT

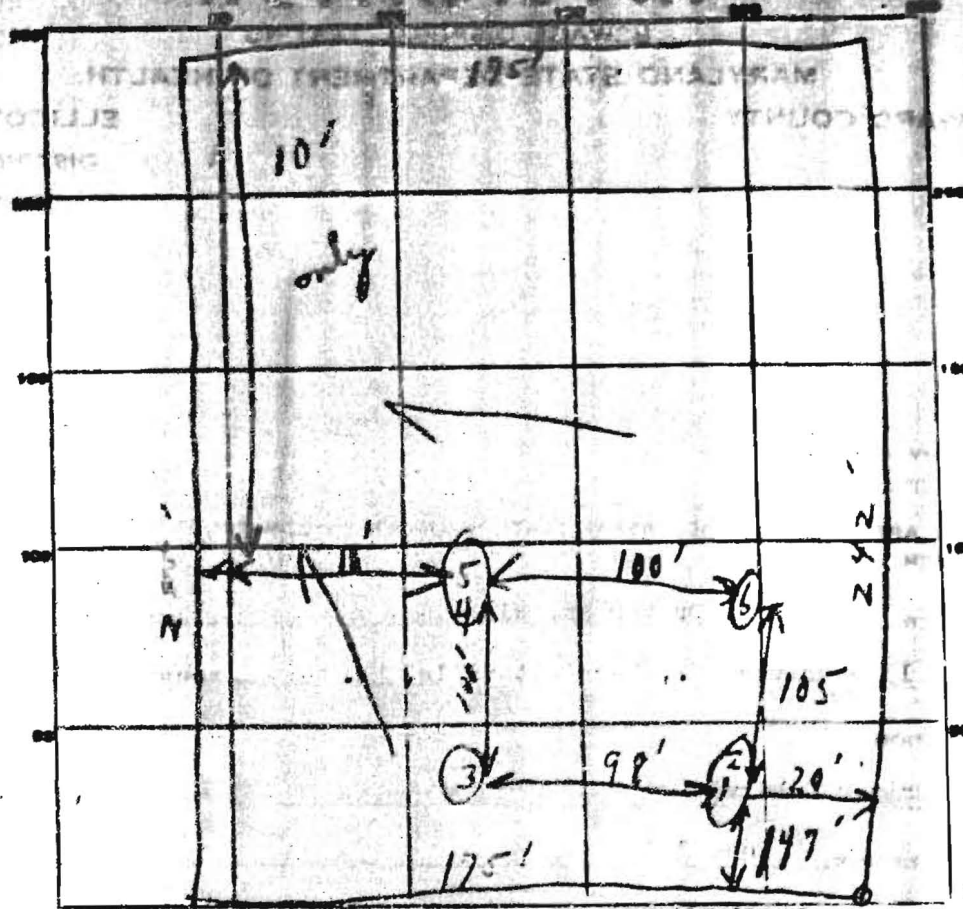

East
Road

100' + 100'
8

DATE	TEST NO.	DEPTH	PRE-WET START	STOP	TEST 1" DROP START	STOP	TIME
11/30/72	1	4 1/2'	9:59	10:01	10:01	10:04	3m
	2	11'	9:57	9:59	9:59	10:02	3m
	3	10'	Similar to 1+2				
	4	9'	10:14	10:17	10:17	10:21	9m
	5	11'	10:45	10:47	10:47	10:52	5m
	6	9 1/2'	Similar and to 1+2				
						4	20

5 min
each
10:20

SCS AUGER FINDING (Use 1+2)
 TESTED BY W. H. H. H. 10:40
 REVISOR