LAYOUT	INSP 4	New Art State of the State of t	
INSP 2	INSP 5		
INSP 3	INSP 6		
ISSUE DATE:		ERMIT P	
APPROVAL DATE		A 517050 A	
	and the same of th	DEXED A 317939-A	
	HOWARD COUNTY	GE DISPOSAL SYSTEM WHEALTH DEPARTMENT WHEALTH HEALTH	
	05-380	7-66 IS PERMITTED TO INSTALL ALTER	
ADDRESS:		PHONE NUMBER:	
SUBDIVISION:	THE HERITAGE	LOT NUMBER: 44	
ADDRESS: 4093	S SHARP ROAD	PROPERTY OWNER: ROY E KOLLY	
SEPTIC TANK CAP	PACITY (GALLONS):	OUTLET BAFFLE FILTER REQUIRED	
PUMP CHAMBER	CAPACITY (GALLONS):	COMPARTMENTED TANK REQUIRED	
NUMBER OF BEDI	ROOMS:		
SQUARE FEET PEI	R BEDROOM:		
LINEAR FEET OF	ΓRENCH REQUIRED:		
TRENCHES:	Trench to be feet wide. Inlet feet below original grade. Bottom maximum depth feet below original grade. Effective area begins at feet below original grade. feet of stone below distribution pipe.		
LOCATION:			
NOTES:			
PLANS APPROVED:		DATE:	
NOTE: PERMIT VOID AFT	FED 2 VEADS		

NOTE: CONTRACTOR RESPONSIBLE FOR SCHEDULING A PRE-CONSTRUCTION INSPECTION FOR ALL INSTALLATIONS

NOTE: WATERTIGHT SEPTIC TANKS REQUIRED

NOTE: ALL PARTS OF SEPTIC SYSTEM SHALL BE 100 FEET FROM ANY WATER WELL
NOTE: MANHOLE RISERS REQUIRED ON ALL SEPTIC TANKS AND PUMP CHAMBERS UNLESS SPECIFICALLY AUTHORIZED

NEITHER THE HOWARD COUNTY COUNCIL NOR THE HEALTH DEPARTMENT IS RESPONSIBLE FOR THE SUCCESSFUL OPERATION OF ANY SYSTEM PERMITTEE RESPONSIBLE FOR OBTAINING FINAL APPROVAL ON THIS PERMIT

BUILDING PERMIT SICHED -313-2640 FOR INSPECTION OF SEPTIC SYSTEM

AND RETURNED 10/10/2002 BOO 138840 DECK WSTEPS Mallela

PERMIT

22300


SEWASE DISPOSAL SYSTEM


MARYLAND STATE DEPARTMENT OF HEALTH'

HOWARD COUNTY BUREAU OF BRYTRONMERTAL HEALTH INDEXED

DISTRICT STY

	-000
SUBDIVISION The Markings Lot	4
PROPERTY CHINES	出路多次
Appress	经事业 拉耳
IF GARBAGE GRIPBAR IS USED INCREASE SERVIC TANK CAPACITY BY SON AND ADSOMPTION AREA BY 22%.	-d-2
GATANOE CRISOSSY 189	VIV
SEPTIC TANK CAPACITY 1990 GALLONS HUMBER OF SELECOMS 4	
THENCHES - 200 eq. ft. per bedroom. Tremch to be 3 feet wide. Inlet 3	t fame butter eviction
at 24 feat below original grade, 14 feet of stone below die ECCRECH - Place the distribution has 150 feet from the front lot like	
right lot line as soon when facing the property from Day Fo. Along contour toward such size lot line being parties, that a	
Road and ASO feet from Day Park Road - 2nd transh fo feet from	t 46 Aug Street also no Mary Book and
105 Yest from her Path Road. 1079 - No transh to accord 100 doct in length. If more than one to	and used, a filest
Provide Pt - P' disseptor classroot and cap to grade or above.	
SITS CONDITIONS - Mine (Annual Subsect And See Countries Conditions Condition	
D CHART SECUL, our STREET, OUR STREET,	1 - 20 T
COVER NO WORK CHIEF REFECTED AND APPLICATED.	Selection of the
ACCIDENT THE HONORID COUNTY COUNTY CONTROL NOT THE HEALTH BETWEENT IS RESPONSIBLE FOR THE SUCCESSIVE OPERATION HOSTE. OF THE HURS OF CALL FOR PROPERTION SETONS AND AFTER PLACING GRAVEL IN TRENCH.	OF ANY SYSTEM
MOTS: NO DRY WILL BROKED 18 FOOT IN CHAMETER, NO ASSOCIATION TREMON TO EXCELL TOURSET IN LENGTH.	
HOTE: ALL PIPE FROM HOUSE 10 SEPTIC TANK MUST SE CAST FROM OR POLICIULE 40 PVC OR ASS. PERCHT VOID APTER THREE YEARS.	
ROTE - RETALL STAND FOR OR SEPTIC TANK AND DIC WILL, STAND PARE BUILT BE & RICHES IN DANGETER CAST HOW OF	MONETE ON TENNA COTTA, CO.
PVE GR AND ACCEPTED. IF TOP OF BEPTIC TANK IS DEEPER THAN 2 FEET MANHOLE TO GRADE REQUIRED	
"INSTALLER IS RESPONSIBLE FOR OBTAINING PINAL APROVAL ON	INIS PERINT

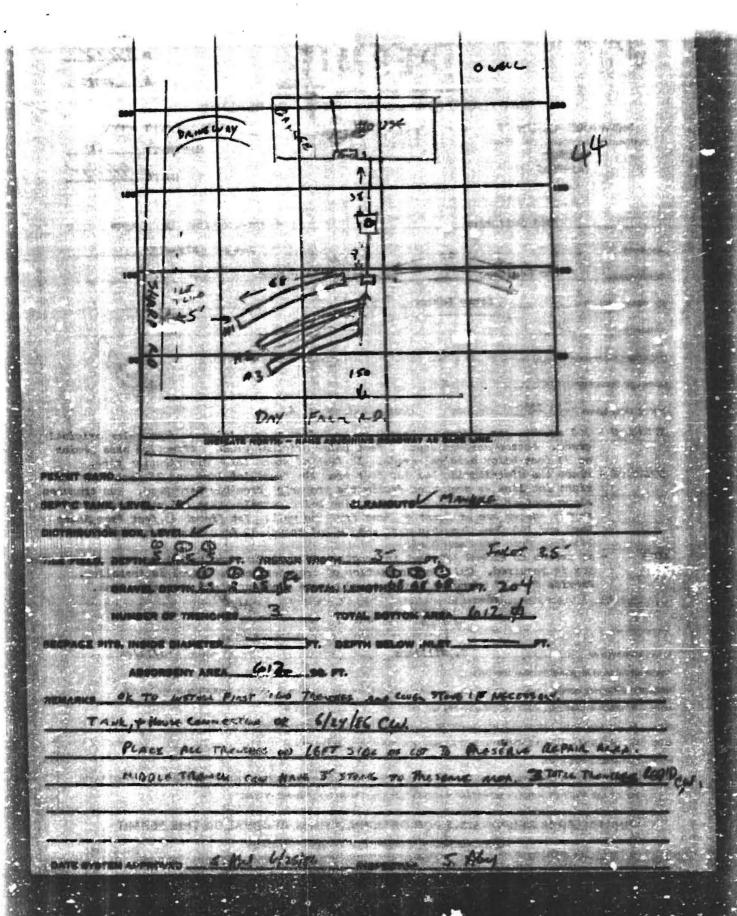

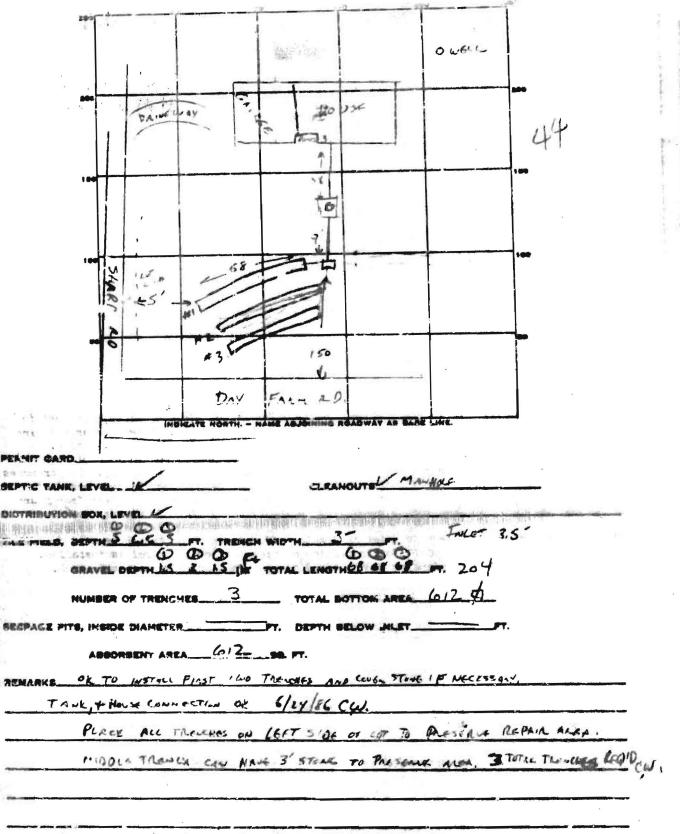

DATE SYSTEM APPROVED & MU G

5. Aby

