


DATE RECEIVED [] [] [] [] [] []		DATE WELL COMPLETED 07/2/86		Depth of Well [] [] [] [] [] [] TO NEAREST FOOT		PERMIT NO. FROM "PERMIT TO DRILL WELL" 810-84-1182	
OWNER FORNEY		STREET OR RFD SHARP RD.		TOWN GLENN		LOT 44	
DIVISION THE HERITAGE		SECTION 44		LOT 44			

WELL LOG Not required for driven wells			SPROUTING RECORD WELL HAS BEEN SROUTED (Circle Appropriate Box)			C3		
STATE THE KIND OF FORMATIONS PENETRATED, THEIR COLOR, DEPTH, THICKNESS AND IF WATER BEARING			TYPE OF SROUTING MATERIAL CEMENT ☒ RENTONITE CLAY ☒			HOURS PUMPED (nearest hour) 5		
DESCRIPTION (Use reduplicated sheets if needed)	FEET		NO. OF BAGS 17 NO. OF POUNDS 1500			PUMPING RATE (gal. per min. to nearest gal.) 100		
	FROM	TO	GALLONS OF WATER DEPTH OF GROUT SEAL (to nearest foot) from 0 ft. to 30 ft.			METHOD USED TO MEASURE PUMPING RATE Bucket		
Top Soil	0	2	Casing Record Casing type: Insert appropriate code below ST STEEL CO CONCRETE PL PLASTIC OT OTHER			WATER LEVEL (distance from land surface) SEPOFF PUMPING 35		
Sandy	2	60				WHEN PUMPING 40		
Sand/Stone	60	65	MAP'S Casing TYPE Nominal diameter top (main) casing (nearest inch) Total depth of main casing (nearest foot) PL ST CO OT			TYPE OF PUMP USED (for test) A P T C R O		
Micka	65	70				OTHER CASING (if used) diameter inch _____ depth (feet) _____		
Sand/Stone	70	75	SCREEN RECORD screen type or open hole Insert appropriate code below ST IR HO PL OT			DRILLER WILL INSTALL PUMP (YES or NO) YES		
Micka	75	110				IF DRILLER INSTALLS PUMP, THIS SECTION MUST BE COMPLETED FOR ALL WELLS EXCEPT HOME USE		
CIRCLE APPROPRIATE LETTER A. WELL WAS ABANDONED AND SEALED WHEN THIS WELL WAS COMPLETED E. BLOCKING LOG OBTAINED P. TEST WELL CONVERTED TO PRODUCTION WELL I HEREBY CERTIFY THAT THIS WELL HAS BEEN DRILLED, SROUTED OR ABANDONED IN ACCORDANCE WITH COMAR 26.17.05 "WELL OF ABSTENTION" AND IN CONFORMANCE WITH ALL CONDITIONS STATED IN THE ABOVE CAPTIONED PERMIT, AND THAT THE INFORMATION FURNISHED HEREIN IS ACCURATE AND TRUE TO THE BEST OF MY KNOWLEDGE. DRILLER'S IDENT. NO. 275 Ralph S. Marine DRILLER'S SIGNATURE (MUST MATCH SIGNATURE ON APPLICATION) Ralph S. Marine SITE SUPERVISOR (sign of driller or journeyman responsible for sitework if different from permittee)			DEPTH (nearest ft.) 1 2 3 100			CAPACITY: GALLONS PER MINUTE (to nearest gallon) 100		
			SLOT SIZE 2 3			PUMP HORSE POWER 10		
			DIAMETER OF SCREEN 4 (NEAREST INCH)			PUMP COLUMN LENGTH (nearest ft.) 10		
			GRAVEL PACK IF WELL DRILLED WAS PLUGGING WELL INSERT P IN BOX 68			Casing Height (circle appropriate box and enter casing height) above below		
OSF USE ONLY (NOT TO BE FILLED IN BY DRILLER) T (E.R.O.S.) ☐ WQ ☐ TELESCOPE CASING ☐ LOG INDICATOR ☐ OTHER DATA ☐			LOCATION OF WELL ON LOT SHOW PERMANENT STRUCTURE SUCH AS BUILDING, SEPTIC TANKS, AND/OR LANDMARKS AND INDICATE NOT LESS THAN TWO DISTANCES (MEASUREMENTS TO WELL) 					

HEALTH

JOHN H. BOYD, M.D., M.P.H.
COUNTY HEALTH OFFICER

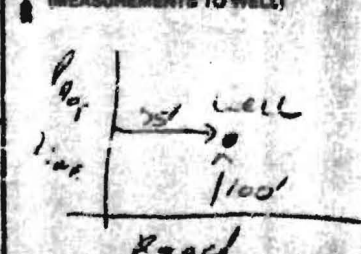

Bureau of Environmental Health
8825 Elliott Mills Drive
Belted City, Maryland 21046

Director - 481-8888
Water & Sewerage, Permits - 481-8888
Community Environmental Health - 481-8844
Technical Services - 481-8888

April 25, 1988

Mr. Roy Kelly
4093 Sharp Road
Glenelg, Maryland 21737

RE: The Heritage, Lot 44
4093 Sharp Road
Well Permit 80-81-1302

Dear Mr. Kelly:

This is to advise you that the septic system was installed, inspected and approved on Jan. 25, 1986.

The water sample recently submitted for testing was free of coliform and fecal coliform bacteria at the time of sampling and is bacteriologically safe for drinking.

FINAL CERTIFICATE OF POTABILITY

This certifies that all sampling requirements of COMAR 10.17.13 "Well Regulations" have been met for the water supply system installed under permit(s) 80-81-1302.

Date of Final Sampling
March 22, 1988

Date of Acceptance
April 25, 1988

Jane E. Nadeau
Jane E. Nadeau, Sanitarian
Water and Sewerage Program

Water Sample Dates: 8/20/86
3/22/88

JEN:hs