


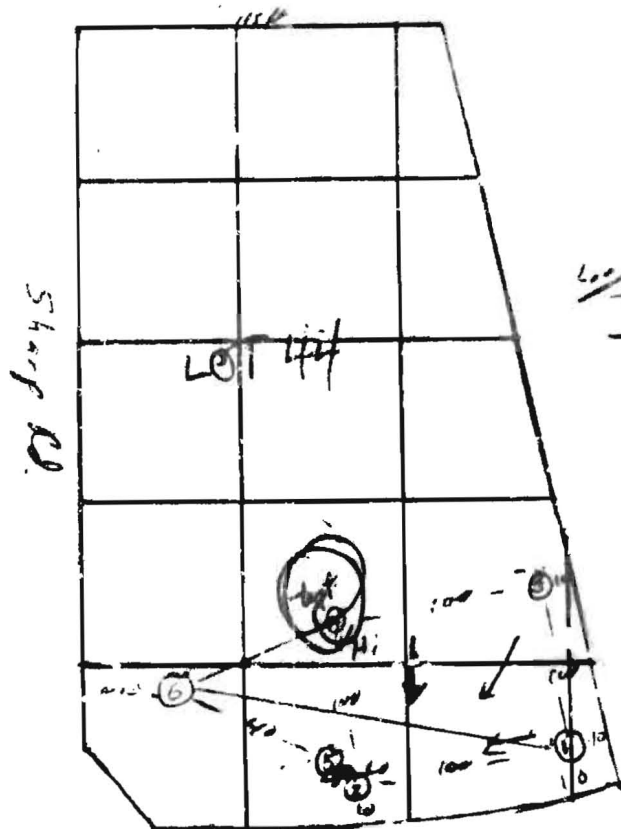

LOT 43

LOT 44

? 14/8/5/15/20/25

AC 69377

INDICATE HOLE IN - C. 100 ft. (HAY FARM RD.)

AS BASE LINE

DATE	TEST NO.	DEPTH	PRE-WET		TEST - 1" DROP		TIME
			START	STOP	START	STOP	
4/23	1	4	2 ²⁵	2 ³⁵	2 ²⁵	2 ⁵⁰	15
	1A	12	2 ²⁵	2 ³⁵	2 ³⁵	2 ⁴⁰	10
	2	45	2²⁵				
	2A	12	2²⁵				
	2B	12	water	@	8'	clay	15'
	3	4	2 ⁴²	2 ⁵²	2 ⁵²	3 ⁰²	10
	3A	12	2 ⁴²	2 ⁵²	2 ⁵²	3 ⁰²	8
	4	12	vis	same	6"	3	
	5	3	3 ⁰⁵	3 ⁰⁸	3 ⁰⁵	3 ¹¹	3 min
	5A	9	3 ⁰⁵	3 ¹¹	3 ¹¹	3 ²⁶	15

(6/2 Jun) REMARKS 4/24 6 12' - 6 min water 0 1' 4' - 5 min
 TYPE OF SOIL shallow systems
 TESTED BY R M H 2 ALSO PRESENT: