

16564

DEPARTMENT OF INSPECTIONS, LICENSES AND PERMITS 3430 COURT HOUSE DRIVE ELLCOTT CITY, MD 21043 PERMITS (410) 313-2465 INSPECTIONS (410) 313-1810 AUTOMATED INFORMATION (410) 313-3800	HOWARD COUNTY PERMIT APPLICATION	PERMIT NUMBER B 00147533
--	---	------------------------------------

Building Address <u>15179 Tristram Mill Rd</u> <u>Clark Mo 21737</u>	Property Owner's Name <u>KD Builders, LLC</u>
Suite/Apt. #: _____ SDP/WP/Petition #: _____	Address <u>6420 Autumn Sky Way</u>
Census Tract <u>605101</u> Subdivision <u>James Brown Prop</u>	City <u>Columbia</u> State <u>Mo</u> Zip Code <u>21014</u>
Section _____ Area _____ Lot <u>19</u>	Home Phone _____ Work Phone <u>(413) 324-4732</u>
Tax Map <u>77</u> Parcel <u>149</u> Grid <u>9</u>	Applicant's Name & Mailing Address, (if other than stated hereon): _____
Zoning <u>RCOFE</u> Map Coordinates <u>13A2</u> Lot size _____	Phone _____ Fax _____
Existing Use <u>SF Home</u>	Contractor Company <u>UNITED PROPAPE</u>
Proposed Use <u>Single Family W 10000G 1P TANK</u>	Contact Person <u>Pick</u>
Estimated Construction Cost \$ <u>3500</u>	Address <u>114 W Roseville Blvd</u>
Description of Work <u>DIG HOLE FOR 10000G 1P TANK</u> <u>ADD HOOK TO STUD OUT @ HOUSE</u>	City <u>Mr. Airy</u> State <u>Mo</u> Zip Code <u>21771</u>
Occupant or Tenant _____	License No. <u>6-9986 E 1175</u>
Contact Name _____	Phone <u>(301) 829-2829</u> Fax <u>(301) 829-5294</u>
Address _____	Engineer or Architect Company _____
City _____ State _____ Zip Code _____	Contact Person _____
Phone _____ Fax _____	Address _____
	City _____ State _____ Zip Code _____
	Phone _____ Fax _____

BUILDING DESCRIPTION - <u>COMMERCIAL</u>		BUILDING DESCRIPTION - <u>RESIDENTIAL</u>	
Building Characteristics	Utilities	Building Characteristics	Utilities
Height: _____	Water Supply: _____ Public _____ Private _____	SF Dwelling ☒ SF Townhouse ☐ <u>Depth</u> <u>Width</u>	Water Supply: _____ Public _____ Private _____
No. of stories: _____	Sewage Disposal: _____ Public _____ Private _____	1st floor: _____	Sewage Disposal: _____ Public _____ Private _____
Gross area, sq. ft. per floor: _____	Electric Yes ☐ No ☐	2nd floor: _____	Electric Yes ☐ No ☐
Use group: _____	Gas Yes ☐ No ☐	Basement: _____	Gas Yes ☐ No ☐
Construction type: _____ Reinforced Concrete _____ Structural Steel _____ Masonry _____ Wood Frame _____	Heating System: _____ Electric ☐ Oil ☐ Natural Gas ☐ Propane Gas ☐	Finished Basement ☐ Unfinished Basement ☐ Crawl space ☐ Slab on Grade ☐ No. of Bedrooms _____	Heating System: _____ Electric ☐ Oil ☐ Natural Gas ☐ Propane Gas ☐
State Certified Modular _____	Sprinkler system: N/A ☐ Full _____ Partial _____ Other Suppression _____ # of Heads _____	Multi-family dwellings: _____ No. of efficiency units: _____ No. of 1 BR units: _____ No. of 2 BR units: _____ No. of 3 BR units: _____	Sprinkler system: N/A ☐ NFPA #13D _____ NFPA #13R _____ Other: _____
		Other Structure: _____ Dimensions: _____ Footings: _____ Roof: _____	
		State Certified Modular _____ Manufactured Home _____	

THE UNDERSIGNED HEREBY CERTIFIES AND AGREES AS FOLLOWS: (1) THAT HE/SHE IS AUTHORIZED TO MAKE THIS APPLICATION; (2) THAT THE INFORMATION IS CORRECT; (3) THAT HE/SHE WILL COMPLY WITH ALL REGULATIONS OF HOWARD COUNTY WHICH ARE APPLICABLE THERE TO; (4) THAT HE/SHE WILL PERFORM NO WORK ON THE ABOVE REFERENCED PROPERTY NOT SPECIFICALLY DESCRIBED IN THIS APPLICATION; (5) THAT HE/SHE GRANTS COUNTY OFFICIALS THE RIGHT TO ENTER ONTO THIS PROPERTY FOR THE PURPOSE OF INSPECTING THE WORK PERMITTED AND POSTING NOTICES.

<u>MICHAEL E. GARRETT</u> Applicant's Signature	<u>MICHAEL E. GARRETT</u> Print Name
_____	<u>4/19/04</u> Date

Title/Company _____

Checks payable to: **DIRECTOR OF FINANCE OF HOWARD COUNTY**
**** PLEASE WRITE NEATLY AND LEGIBLY. ****
- FOR OFFICE USE ONLY -

AGENCY	DATE	SIGNATURE APPROVAL	DPZ SETBACK INFORMATION	PROPERTY ID#
Land Development, DPZ			Front: _____	59940
State Highways			Rear: _____	Filing fee \$ _____
Building Official			Side: _____	Permit fee \$ <u>100.00</u>
Dev. Engineering, DPZ			Side St.: <u>Feb</u>	Excavation \$ <u>10.00</u>
Health <u>4/27/04</u> <u>[Signature]</u>			All minimum setbacks met? YES ☐ NO ☐	Add'l per. fee \$ _____
Fire Protection			Is Entrance Permit required? YES ☐ NO ☐	TOTAL FEES \$ <u>110.00</u>
Is Sediment Control approval required prior to issuance? YES ☐ NO ☐			Historic District? YES ☐ NO ☐	Sub-total paid \$ _____
CONTINGENCY CONSTRUCTION START: ☐			Lot Coverage for New Town Zone _____	Balance due \$ _____
ONE STOP SHOP: ☐			SDP/Red-line approval date _____	Check # <u>[Signature]</u>
				Validation # <u>44225</u>
				Accepted by <u>[Signature]</u>

N 572250

E 1301800


4/27/04
Proposed Location of
Propane tank OK
BOOTH 33 (KS)

Scale: 1" = 30'
Distance to:
Well : > 240'
Septic Tank : 90'
Septic Easement: 52'

N 572000

STORMWATER
MANAGEMENT
CREDIT
EASEMENT

N72°24'21"E 150.90'

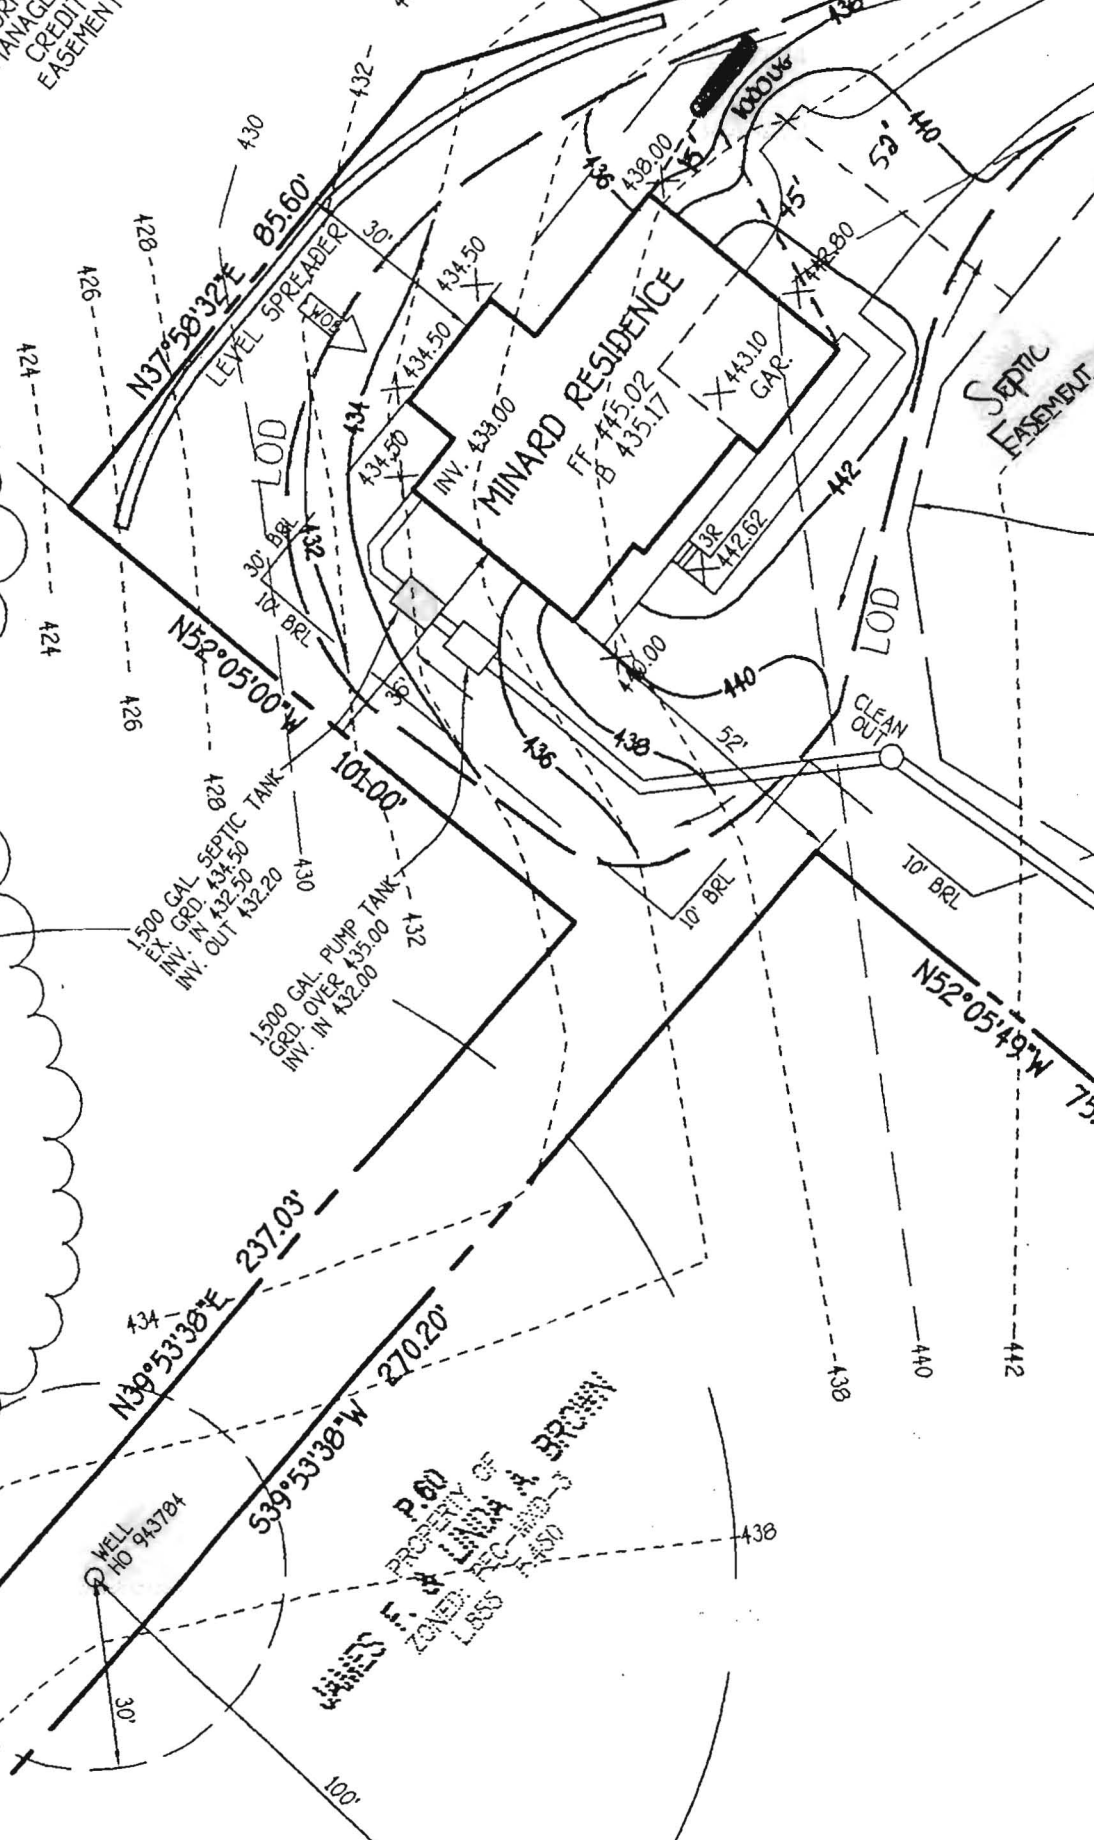

PROPERTY OF
LINDA J. BROWN
ZONED REC-MD-3
L850

HOWARD COUNTY
PERMIT APPLICATION

PERMIT NUMBER
B00144799

Building Address 15179 Tridelphi in Mill Road

Clensle, MD 21737

Suite/Apt. #: NA SDP/WP/Petition #: NA

Census Tract 114101 Subdivision Map 11

Section 27 Area 60 Lot 9

Tax Map 27 Parcel 60 Grid 9

Zoning PERMITD Map Coordinates 13 A-1 Lot size 1 acre

Existing Use Vacant property

Proposed Use Single Family Dwelling

Estimated Construction Cost \$ 100,000.00

Description of Work "Myard House" model

Occupant or Tenant

Contact Name

Address

City State Zip Code

Phone Fax

BUILDING DESCRIPTION - COMMERCIAL

Building Characteristics

Height

No. of stories

Gross area, sq. ft. per floor

Use group

Construction type:

Reinforced Concrete

Structural Steel

Masonry

Wood Frame

State Certified Modular

Utilities

Water Supply:

Public

Private

Sewage Disposal:

Public

Private

Electric Yes ☐ No ☐

Gas Yes ☐ No ☐

Heating System:

Electric ☐ Oil ☐

Natural Gas ☐

Propane Gas ☐

Sprinkler system: N/A

Full

Partial

Other Suppression

of Heads

BUILDING DESCRIPTION - RESIDENTIAL

Building Characteristics

SF Dwelling NA SF Townhouse ☐

Depth Width

1st floor:

2nd floor:

Basement:

Finished Basement ☒ Unfinished Basement ☐

Crawl space ☐ Slab on Grade ☐

No. of Bedrooms 4

Multi-family dwellings:

No. of efficiency units:

No. of 1 BR units:

No. of 2 BR units:

No. of 3 BR units:

Other Structure:

Footings:

Roof:

State Certified Modular

Manufactured Home

Utilities

Water Supply:

Public

Private

Sewage Disposal:

Public

Private

Electric Yes ☒ No ☐

Gas Yes ☐ No ☐

Heating System:

Electric ☐ Oil ☐

Natural Gas ☒

Propane Gas ☐

Sprinkler system: N/A

Full

Partial

Other:

Property Owner's Name KD Builders, LLC

Address c/o B. James Greenfield, 6420 Autumn Sky Way

City Columbia State MD Zip Code 21044

Home Phone

Applicant's Name & Mailing Address, (if other than stated hereon):

Phone

Fax

Contractor Company KD Builders, LLC

Contact Person B. James Greenfield or Dee Sperling

Address Same

City Columbia State MD Zip Code 21044

License No. 3525

Phone 410-534-9834 Fax 410 992 3020

Engineer or Architect Company D.W. Taylor

Contact Person Michael

Address 5024 Dorsey Hall Drive, Ste. 203

City Ellicott City State MD Zip Code 21043

Phone 410-964-1181

Fax

THE UNDERSIGNED HEREBY CERTIFIES AND AGREES AS FOLLOWS: (1) THAT HE/SHE IS AUTHORIZED TO MAKE THIS APPLICATION; (2) THAT THE INFORMATION IS CORRECT; (3) THAT HE/SHE WILL COMPLY WITH ALL REGULATIONS OF HOWARD COUNTY WHICH ARE APPLICABLE THEREON; (4) THAT HE/SHE WILL PERFORM NO WORK ON THE ABOVE REFERENCED PROPERTY NOT SPECIFICALLY DESCRIBED IN THIS APPLICATION; (5) THAT HE/SHE GRANTS COUNTY OFFICIALS THE RIGHT TO ENTER ONTO THE PROPERTY FOR THE PURPOSES OF INSPECTING THE WORK PERMITTED AND POSTING NOTICES.

Applicant's Signature B. James Greenfield

Owner, KD Builders, LLC

Title Company

B. James Greenfield

Print Name 10/24/03

Date

Checks payable to: DIRECTOR OF FINANCE OF HOWARD COUNTY
** PLEASE WRITE NEATLY AND LEGIBLY. **
- FOR OFFICE USE ONLY.

SIGNATURE APPROVAL

DATE

AGENCY

Land Development, DPZ

State Highways

Building Official

Dev. Engineering, DPZ

Health

Fire Protection

Is Sediment Control approval required prior to issuance?

YES ☒ NO ☐

CONTINGENCY CONSTRUCTION START: ☐
ONE STOP SHOP: ☐

PROPERTY ID# 59945

Filing fee

Permit fee

Excise tax

Sub-total paid

Add 1 permit fee

TOTAL FEES

Balance due

Check

Validation

Lot Coverage for New Town Zone

SDP/Red-line approval date

Yellow: DED, DPZ

Pink: Health

Gold: SHA

Distribution of Copies: White: Building Official

Green: LDD, DPZ

Yellow: DED, DPZ

Pink: Health

Gold: SHA

a: yornal:dm

Rev: 10/15/98