

250 ok kb
6/4/76
6/2

PERMIT

P. 23170

A. 23/76

SEWAGE DISPOSAL SYSTEM

MARYLAND STATE DEPARTMENT OF HEALTH

HOWARD COUNTY

ELLCOTT CITY

INDEXED

DISTRICT 1

DATE 5/13/76

Jack Frank

IS PERMITTED TO INSTALL

ADDRESS The Oaks Farm, Ellicott City, Md.

PHONE 282-2829

A SEWAGE DISPOSAL SYSTEM LOCATED AT

SUBDIVISION ROAD 15125 Triadelphia LOT

2111 West

PROPERTY OWNER James B. Baker

ADDRESS

SPECIFICATIONS - trailer - 8 bedrooms

DRAIN FIELD DEPTH FEET, BOTTOM AREA SQ. FT.

SEWAGE PITS ABSORBENT SIDE-WALL AREA SQ. FT.

SPACE FOR TRENCH

FIELD SHALL BE IN EXISTING SEPTIC TANK CAPACITY 1,000 GALLONS

AND APPROVED BEFORE

PERMIT WILL FOR GARAGE GRINDER, INCREASE DISPOSAL AREA 200 & TANK CAPACITY 500

BE REMOVED.

OTHER TRENCH - 2 ft. wide - 20 ft. long - 12 ft. deep and filled with 3 ft.

of gravel. Place ditch 15 to 20 ft. from trailer side and 10 to 15 ft. from the building.

NOTE: Ditch to fill with stone. Ditch was inspected at time of permit.

NOTE: NO PIPE FROM TRAILER TO DISPOSAL AREA MUST BE CAST IRON.

NOTE: THIS SYSTEM SHALL BE

MAINTAINED AND REPAIRS TO SEPTIC TANK, SEWAGE PITS MUST BE 6" TO 8" DIA., CAST IRON, COVERED

OR APPROVED EQUIVALENT.

PLANS APPROVED BY Edward Hedges

DATE 5/13/76

FILL SEPTIC TANK AND DISTRIBUTION BOX WITH WATER BEFORE CALLING FOR AN INSPECTION. COVER AND LOCK UNTIL INSPECTED AND APPROVED.

NEITHER THE HOWARD COUNTY COMMISSIONERS NOR THE HEALTH DEPARTMENT IS RESPONSIBLE FOR THE SUCCESSFUL OPERATION OF ANY SYSTEM.

OWNER FOR NOTES: CALL FOR INSPECTION WHEN CHANGING IS OPENED UP BY CONTRACTOR OR REPAIRMAN. REPAIR DESIGN.

just for wash water


ENCL. PERMIT SIGNED
AND RETURNED

James B. Baker
P.H.

23170

slow
up
to
3

5' buffer

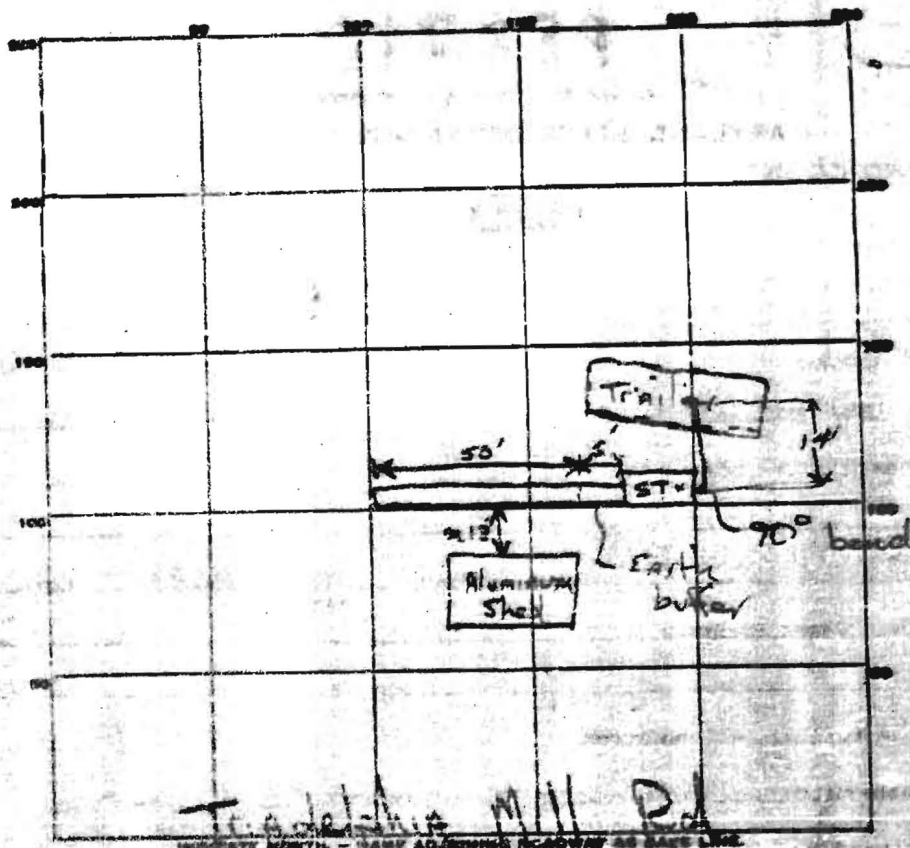

PERMIT CARD

SEPTIC TANK LEVEL

CONNECTION BOX LEVEL

INLET

DEPTH 2 ft. TRENCH WIDTH 2 ft.

GRAVEL DEPTH 4 ft. TOTAL LENGTH 50 ft.

NUMBER OF TRENCHES

TOTAL BOTTOM AREA 100 sq. ft.

SEPTAGE PITS INSIDE DIAMETER

DEPTH BELOW INLET

ABSORBENT AREA

REMARKS May 20 1976 septic tank & drain field meet

Required Specifications - ok to hook up trailer

June 4 1976 at 1:45 pm 1 1/2" pipe hooked up

satisfactorily - ok to cover all work

DATE SYSTEM APPROVED

June 4 1976

INSPECTOR

hal Benson - Frank

3' 13' L... Triangle 450
Page 1
SEE page 2 for
Existing House
Specs
P. _____
APPLICATION

SEWAGE DISPOSAL TESTING

STATE OF MARYLAND - DEPARTMENT OF HEALTH AND MENTAL HYGIENE

HOWARD COUNTY HEALTH DEPARTMENT TRAILER SPECS DISTRICT _____
ENVIRONMENTAL HEALTH SERVICES 1000 GALTANK DATE 4/29/76
P. O. BOX 470, ELLICOTT CITY, MARYLAND 21043
TELEPHONE: 463-9000, EXT. 300

5/19/76 DITCH - 2 FT WIDE 50 FT LONG 12 FT DEEP
2 FT FILLED WITH 8 FT OF STONE
PLACE DITCH 15 TO 20 FT FROM TRAILER SITE
90 TO 150 FT FROM THE EXISTING WALL
OK TO FILL THIS DITCH WITH STONE

TO: THE COUNTY HEALTH OFFICER BECAUSE DITCH WAS INSPECTED
ELLICOTT CITY, MARYLAND AT TIME OF PERC TEST

I, HEREBY, APPLY FOR THE NECESSARY TEST IN ORDER TO CONSTRUCT (OR RECONSTRUCT) A SEWAGE
DISPOSAL SYSTEM.

PROPERTY OWNER James E. Brown

ADDRESS 15133 Tridolphia Mill Road, Clarks, MD PHONE 463-4702

PROPERTY LOCATION:

SUBDIVISION _____ LOT NO. _____

ROAD AND DESCRIPTION 15133 Tridolphia Mill Road near intersection of

Tridolphia Rd & Tridolphia Mill Rd White 2 Story
House near Road Farm trailer

SIZE OF LOT 2.2 ACRES B/L TYPE BLDG. 2 NUMBER OF BEDROOMS 2

IF NOT SINGLE RESIDENCE DESCRIBE _____

THE SYSTEM INSTALLED UNDER THIS APPLICATION IS ACCEPTABLE ONLY UNTIL PUBLIC
FACILITIES BECOME AVAILABLE.

SIGNATURE OF APPLICANT James E. Brown

APPROVED Raymond Hodge FOR Ditch DATE 5/19/76

REJECTED BY _____ FOR _____ DATE _____


HOLD PENDING FURTHER TESTS _____ DATE _____

REASONS FOR REJECTION OR HOLDING _____

SYSTEM NEEDS TO BE INSTALLED FIRST BEFORE PERMIT CAN BE SIGNED.

THIS IS NOT A PERMIT

TRAILER PIA MLLRD

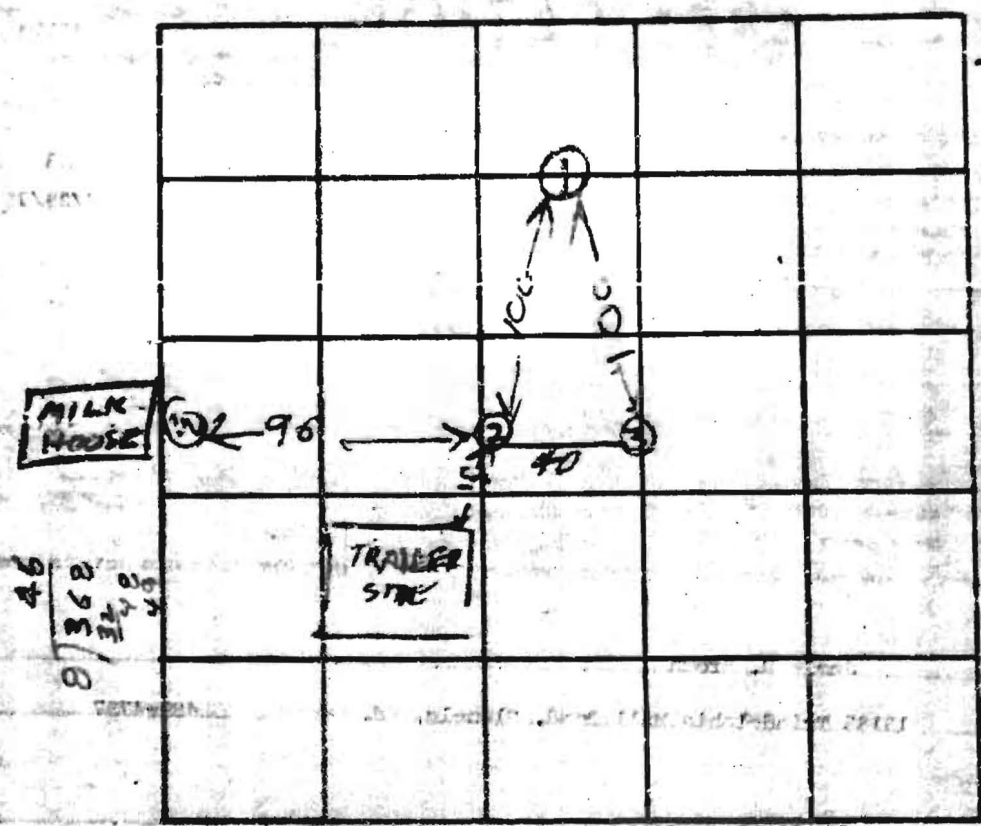

INDICATE NORTH - LONG ADJOINING ROADWAY AS BASE LINE.

DATE	TEST NO.	DEPTH	PRE-TEST		TEST START DROP		TIME
			START	STOP	START	STOP	
5/1/68	1D	12	247	252	252	258	5
	15	4	247	252	252	259	5
	25	4 1/2	250	255	255	302	7
	27	12 1/2	250	259	259	303	9
	35	6	258	300	300	302	2
	3D	13	259	302	302	305	3

LOW
WATER

REMARKS: EXISTING SYSTEM ON
TYPE OF SOIL: TOP 4 FT CLAY
 TESTED BY: B. HODGES ALSO PRESENT: _____

APPLICATION

Pager

SEWAGE DISPOSAL TESTING

STATE OF MARYLAND - DEPARTMENT OF HEALTH AND MENTAL HYGIENE

HOWARD COUNTY HEALTH DEPARTMENT *EXISTING HOUSE* DISTRICT *3*
ENVIRONMENTAL HEALTH SERVICES *SPCS*

P. O. BOX 476, ELLICOTT CITY, MARYLAND 21043
TELEPHONE: 485-8888, EXT. 300

DATE *ADATE*

*DEEP DITCH FOR WASH WATER - 30 FT LONG
2 FT WIDE 8 FT DEEP FILLED WITH 4 FT
OF STONE. PUT DITCH IN POROUS SOIL
SOIL WILL BE INSPECTED AT TIME OF
DITCH INSPECTION TWO INSPECTIONS*

TO: THE COUNTY HEALTH OFFICER *OF DITCH NEEDED ONE*
ELLICOTT CITY, MARYLAND *BEFORE STONE ADDED & ONE*

I, HEREBY, APPLY FOR THE NECESSARY TEST IN ORDER TO CONSTRUCT (OR RECONSTRUCT) A SEWAGE
DISPOSAL SYSTEM. *AFTER STONE ADDED*

PROPERTY OWNER *John D. Jones*

ADDRESS *2000 Telegraph Hill Rd., Chevy, MD* PHONE *485-4787*

PROPERTY LOCATION:

SUBDIVISION _____ LOT NO. _____

ROAD AND DESCRIPTION *2000 Telegraph Hill Rd.*

SIZE OF LOT *10 ACRES +/-* TYPE BLDG. *Frame building*

IF NOT SINGLE RESIDENCE DESCRIBE _____

THE SYSTEM INSTALLED UNDER THIS APPLICATION IS ACCEPTABLE ONLY UNTIL PUBLIC
FACILITIES BECOME AVAILABLE.

SIGNATURE OF APPLICANT *John D. Jones*

APPROVED BY *Raymond J. Dodge* FOR *Ditch* DATE *5/19/76*

REJECTED BY _____ FOR _____ DATE _____

HOLD PENDING FURTHER TESTS _____ DATE _____

REASONS FOR REJECTION OR HOLDING _____


SYSTEM SEEMS TO BE INSTALLED FIRST BEFORE PERMIT CAN BE ISSUED.

THIS IS NOT A PERMIT

open
trench
12" deep

stone
up to
23'

HE
MAY 20
1974

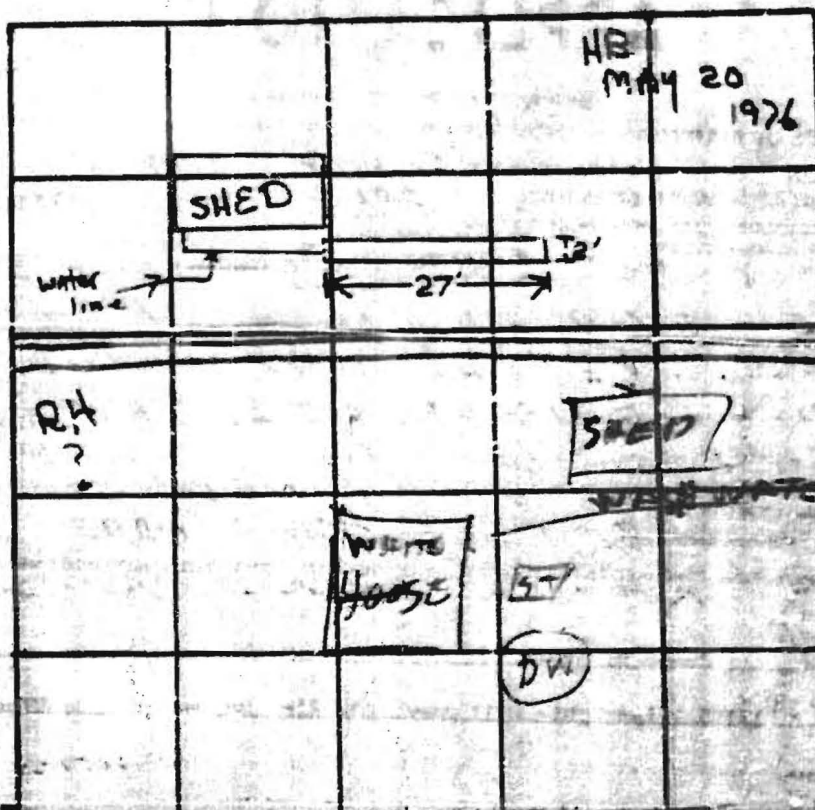

TRIPOLI MILA R.D.

[illegible]

References

TYPE SET 2000

TESTED BY

Sub installed in Heavy Duty

ALSO PRESENT

TRIDELPHIA RD

EXHIBIT A

