

PUB. SEWER STATUS VERIFIED BY _____

ISSUE DATE: _____

APPROVAL DATE: _____

PERMIT

P _____

A A518005

INDEXED

**ON-SITE SEWAGE DISPOSAL SYSTEM
HOWARD COUNTY HEALTH DEPARTMENT
BUREAU OF ENVIRONMENTAL HEALTH**

05-354714

IS PERMITTED TO INSTALL ☐ ALTER ☒

ADDRESS: _____ PHONE NUMBER: _____

SUBDIVISION: William Contrivance LOT NUMBER: 6

ADDRESS: 8231 Reservoir Road PROPERTY OWNER: Jones Perry

SEPTIC TANK CAPACITY (GALLONS): _____

PUMP CHAMBER CAPACITY (GALLONS): _____

NUMBER OF BEDROOMS: _____

SQUARE FEET PER BEDROOM: _____

LINEAR FEET OF TRENCH REQUIRED: _____

TRENCHES:	Trench to be _____ feet wide. Inlet _____ feet below original grade. Bottom maximum depth _____ feet below original grade. Effective area begins at _____ feet below original grade. _____ feet of stone below distribution pipe.
LOCATION:	
PURPOSE:	

PLANS APPROVED: _____ DATE: _____

NOTE: PERMIT VOID AFTER 2 YEARS

NOTE: CONTRACTOR RESPONSIBLE FOR SCHEDULING A PRE-CONSTRUCTION INSPECTION FOR ALL INSTALLATIONS

NOTE: WATERTIGHT SEPTIC TANKS REQUIRED

NOTE: ALL PARTS OF SEPTIC SYSTEM SHALL BE 100 FEET FROM ANY WATER WELL

NOTE: MANHOLE RISERS REQUIRED ON ALL SEPTIC TANKS AND PUMP CHAMBERS

**NEITHER THE HOWARD COUNTY COUNCIL NOR THE HEALTH DEPARTMENT IS
RESPONSIBLE FOR THE SUCCESSFUL OPERATION OF ANY SYSTEM
PERMITTEE RESPONSIBLE FOR OBTAINING FINAL APPROVAL ON THIS PERMIT
CALL 410-313-2640 FOR INSPECTION OF SEPTIC SYSTEM**

A518005

A518005

9/24/74
as late as possible
8/17/74 send a copy of this to below person!!

MARYLAND STATE DEPARTMENT OF HEALTH

HOWARD COUNTY

ELICOTT CITY

DISTRICT

DATE 6/22/74

INDEXED

W. W. Cleary

10408

Cherry Lane, Mitchellville Md

20714

IS PERMITTED TO INSTALL & ALTER

ADDRESS 6888 Main Street, Luthers, Maryland 20917 PHONE 377-3840

A SEWAGE DISPOSAL SYSTEM LOCATED AT

SUBDIVISION Williams Contrivances Estates ROAD Bessette Rd LOT T

PROPERTY OWNER Kenneth W. Hoffman

ADDRESS same as above

SPECIFICATIONS 3

DRAIN FIELD DEPTH FEET BOTTOM AREA SQ. FT.

SEEPAGE PITS ABSORBENT SIDEWALL AREA SQ. FT.

SEPTIC TANK CAPACITY 1250 GALLONS

FOR GARBAGE GRINDER, INCREASE DISPOSAL AREA 25% & TANK CAPACITY 50%.

OTHER DRY WELL - To have 115 sq. feet effective absorbent sidewall area below inlet. Inlet to be 3 ft. below original grade and maximum depth 12 ft. Locate dry well 135 ft. from rear property line and 10 ft. from right side of lot from road. or 145' from rear & 40' off right side

NOTE: ALL PIPE FROM HOUSE TO DRY WELL MUST BE CAST IRON.

PERMIT VOID AFTER THREE YEARS.

NOTE: INSTALL BOND PIPE ON SEPTIC TANK AND DRY WELL.

PLANS APPROVED BY Charles E. Stricker DATE 8/23/74

FILL SEPTIC TANK AND DISTRIBUTION BOX WITH WATER BEFORE CALLING FOR AN INSPECTION. COVER NO WORK UNTIL INSPECTED AND APPROVED.

NEITHER THE HOWARD COUNTY COMMISSIONERS NOR THE HEALTH DEPARTMENT IS RESPONSIBLE FOR THE SUCCESSFUL OPERATION OF ANY SYSTEM.

OK for trench 50' long - 18' deep, 5' gravel under pipe 2' wide
between 10 & 90 from right sidewalk
& 135' from rear lot line
11' 6" not well from edge of lot before gravel

17964

PERMIT CARD

MARYLAND DEPARTMENT OF HEALTH
SEWAGE DISPOSAL SYSTEM

HOWARD COUNTY
ELLCOTT CITY
DISTRICT
DATE

ADDRESS
A SEWAGE DISPOSAL SYSTEM LOCATION
SUBDIVISION
PROPERTY OWNER
ADDRESS
SPECIFICATIONS
DRAIN FIELD
DEPTH
FEET BOTTOM AREA
20 FT.

INDICATE NORTH -- NAME ADJOINING ROADWAY AS BASE LINE.

PERMIT CARD signed

SEPTIC TANK, LEVEL 10 ft OK

DISTRIBUTION BOX, LEVEL 10 ft

TILE FIELD, DEPTH 10 ft TRENCH WIDTH 10 ft

GRAVEL DEPTH 10 ft TOTAL LENGTH 10 ft

NUMBER OF TRENCHES 10 TOTAL BOTTOM AREA 10

SEEPAGE PITS, NUMBER 10 DEPTH BELOW INLET 9 FT.

ABSORBENT AREA 10 SQ. FT.

PLANS APPROVED BY Charles E. Stewart


REMARKS

NEITHER THE HOWARD COUNTY COMMISSIONER NOR THE HEALTH DEPARTMENT IS RESPONSIBLE FOR THE SUCCESSFUL OPERATION OF ANY SYSTEM.


UNTIL INSPECTED AND APPROVED.

FILE SEPTIC TANK AND DISTRIBUTION BOX WITH WATER REPORT CALLING FOR AN INSPECTION.

0 1

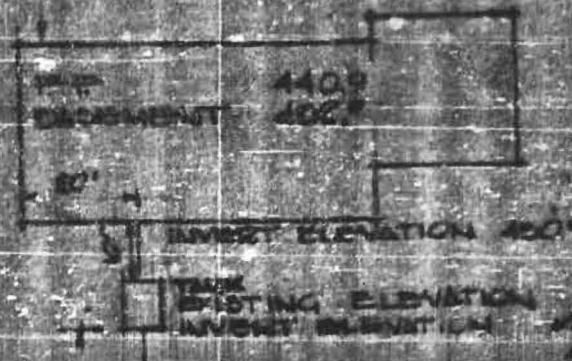

4/3/11 H. Old
Level ✓
marked down
dry - old
Level ✓
116-500

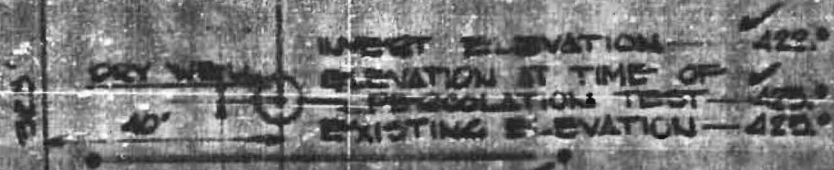

PERCOLATION TEST PIT'S
discussed

OK 4/3/11
ced

